

Lloyd's Register of British and Foreign Shipping.

S.S. Maryland (Report on Vessel No. *6296* Port *W. H. H. H.*)

The words FORGINGS or CASTINGS, IRON or STEEL, should be struck out as may be required.

No. *469.a* SHIP FORGINGS OR CASTINGS.

I have to report that the undermentioned Iron or Steel Forgings or Castings, manufactured by *Messrs J Richardson & Sons* of *Bathpool* for the Vessel No. *317*, being built by *Messrs H Gray & Co.* of *Brest Bathpool* have been inspected by me as set forth below, and found to be, so far as can be seen, *sound*.


Mark on Forgings.

Lloyd's
No. *469.a*
H.C.

Hugh Cameron
Lundulund

	STERN FRAME.	RUDDER FRAME.	STEM.
Material* - - - -	<i>Scrap Iron</i>	<i>Scrap Iron</i>	
How made - - - -	<i>Forged</i>	<i>Forged</i>	
Dimensions - - - -	<i>11' 7 1/2"</i>	<i>8 1/2' - 4'</i>	
Progress on Inspection -	<i>Forged & Smithed</i>	<i>Forged & Smithed</i>	<i>Not seen</i>
Dates when Inspected	<i>July 27 Aug 20-25 Sept 15 22-24/86</i>	<i>Oct 11-28 Nov 11/86</i>	

SKETCHES OF FRAMES SHEWING POSITION AND DESCRIPTION OF WELDS OF FORGINGS, OR PARTICULARS OF TESTS APPLIED TO CASTINGS.

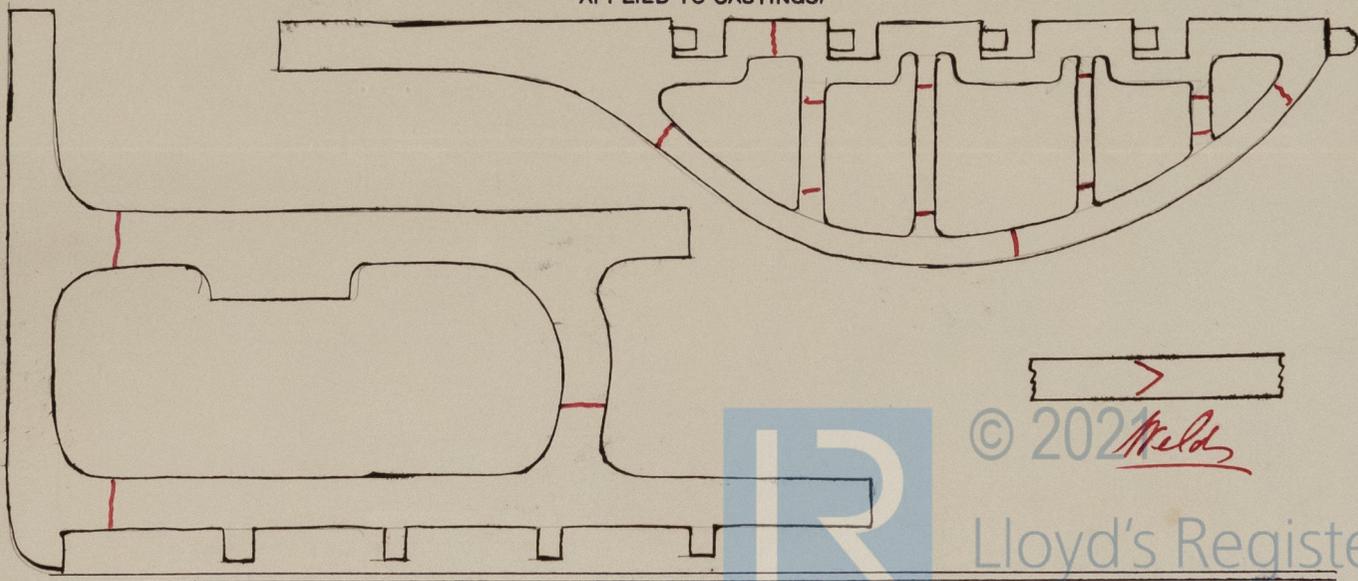

© 2021 *Melds*
Lloyd's Register
Foundation

* If of Iron, state whether scrap or puddled Iron.