

15.7.86

22.7.86


5.8.86

*S.S. Maryland* *W. & P. Report No 6296*


Profile of Steel Steamer

N<sup>o</sup> 317

Scale 1/8" to one foot

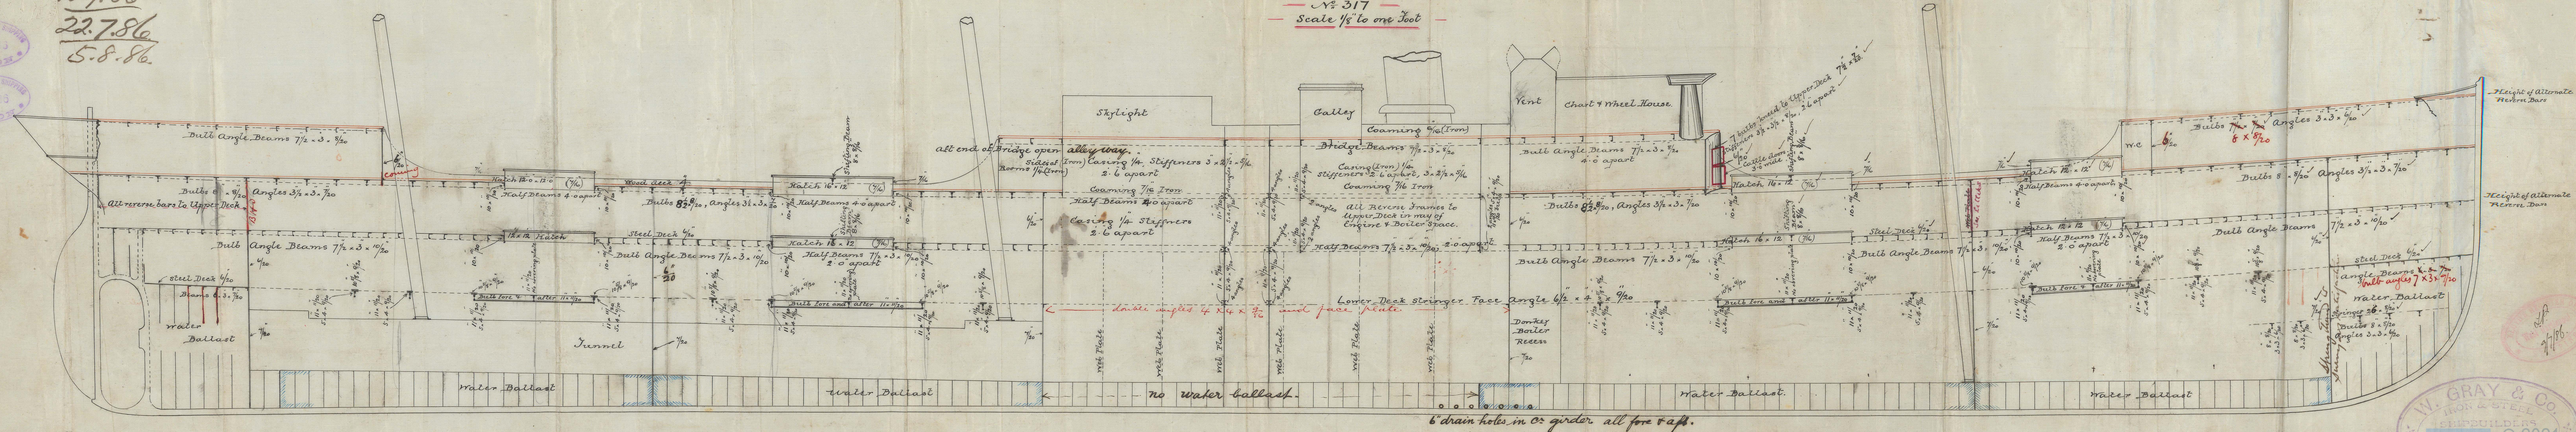

*W. & P.*  
14/7/86

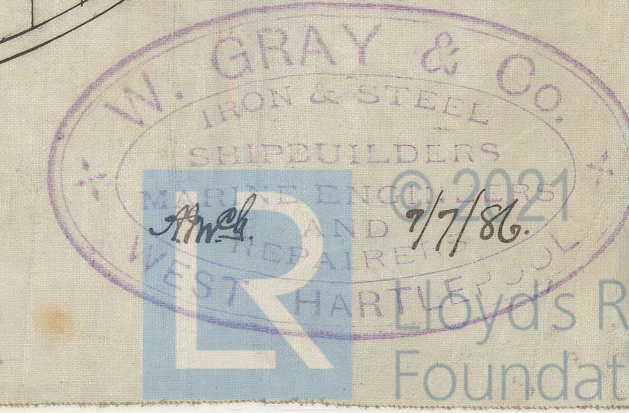

STK 913-0294

Lloyd's Register Foundation

Mayland

Profile of Steel Steamers

215 1/2

Scale 1/8 to over foot



© 2021

Lloyd's Register  
Foundation