


— No 317 S.S. —

— Sketch showing Shifting Boards —

SCALE  $\frac{1}{2}$  INCH = 1 FOOT


15.7.86

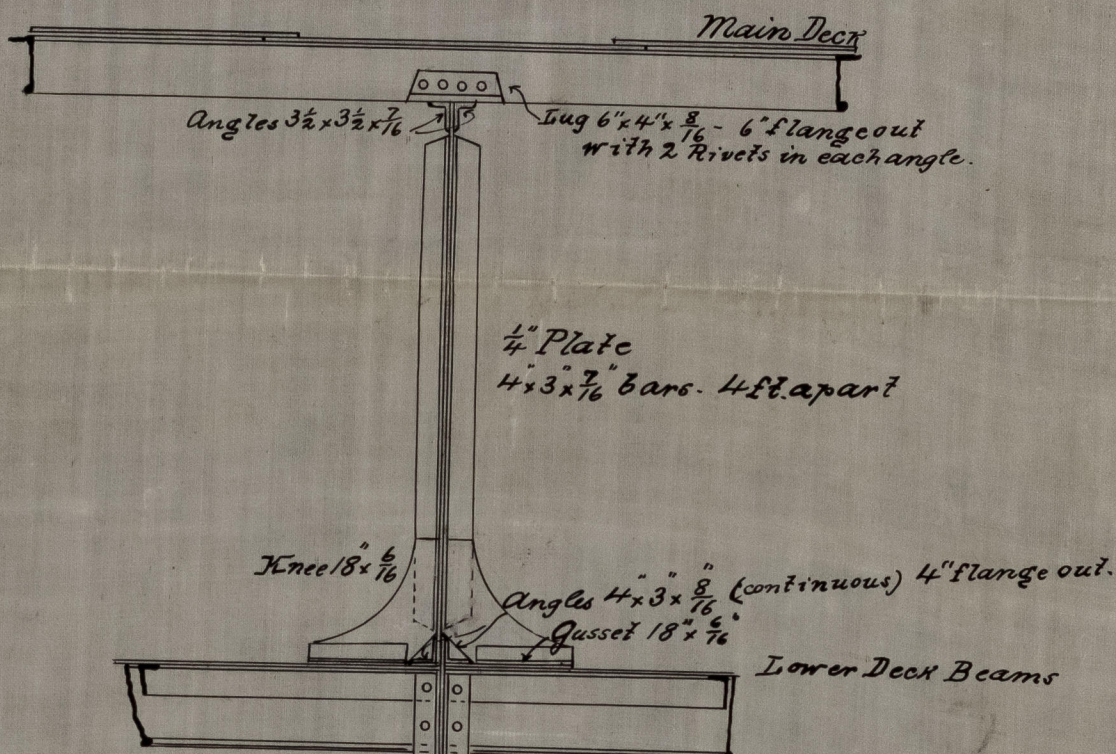

This arrangement applies to Fore Part of Ship. In the after Part the Shifting Boards terminate on top of tunnel.  
All Plates & Stiffeners of Iron.

$\frac{5}{16}$  Plate

$4 \times 3 \times \frac{8}{16}$  bars - 4 ft. apart

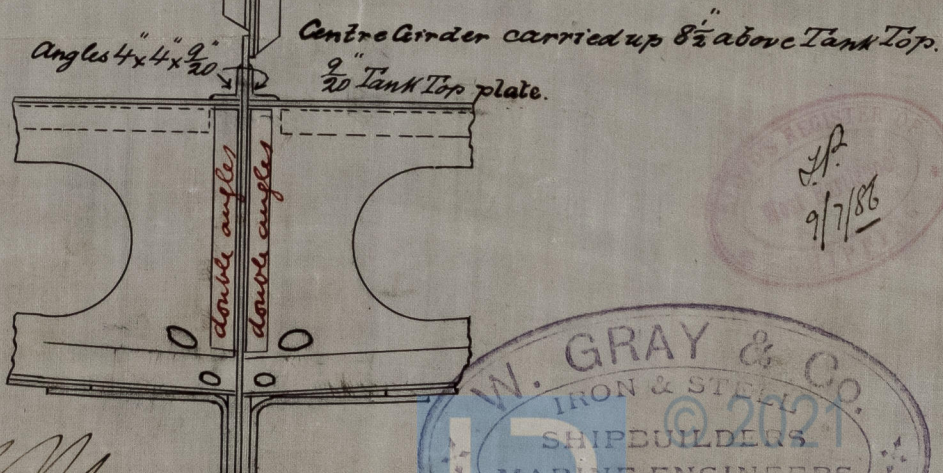

J.H. 18M  
14/7/86

