



13.8.86.

SS Maryland 'Huller Report to 1896


Fore Mast.

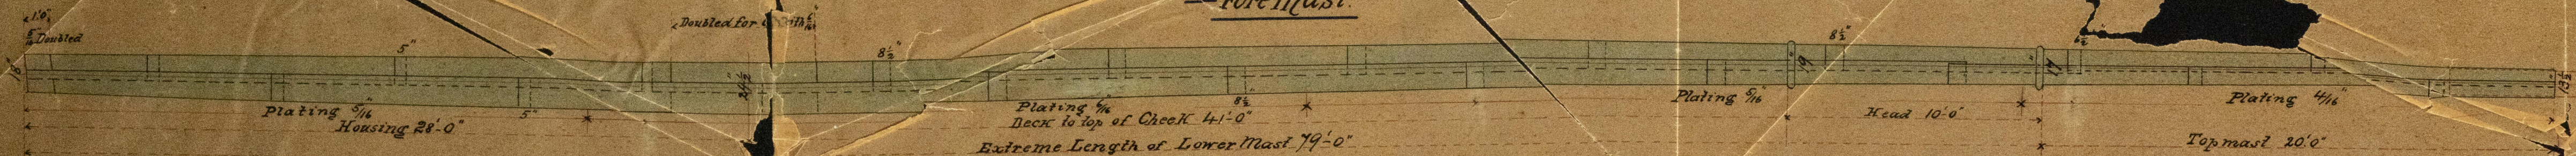


Section th^o Fore Mast at Height of Deck

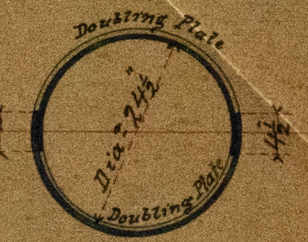


Main Mast.

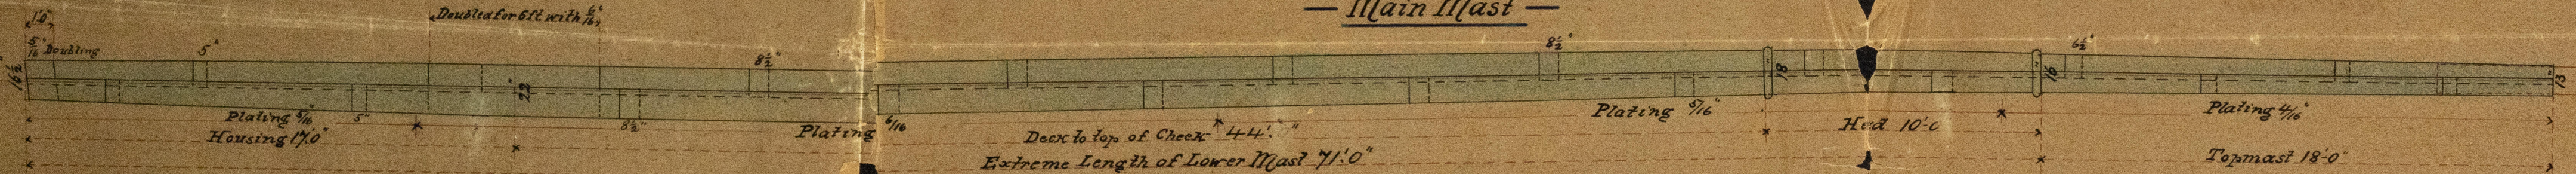


Section th^o Main Mast at Height of Deck

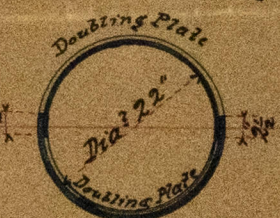

Mizen Mast.

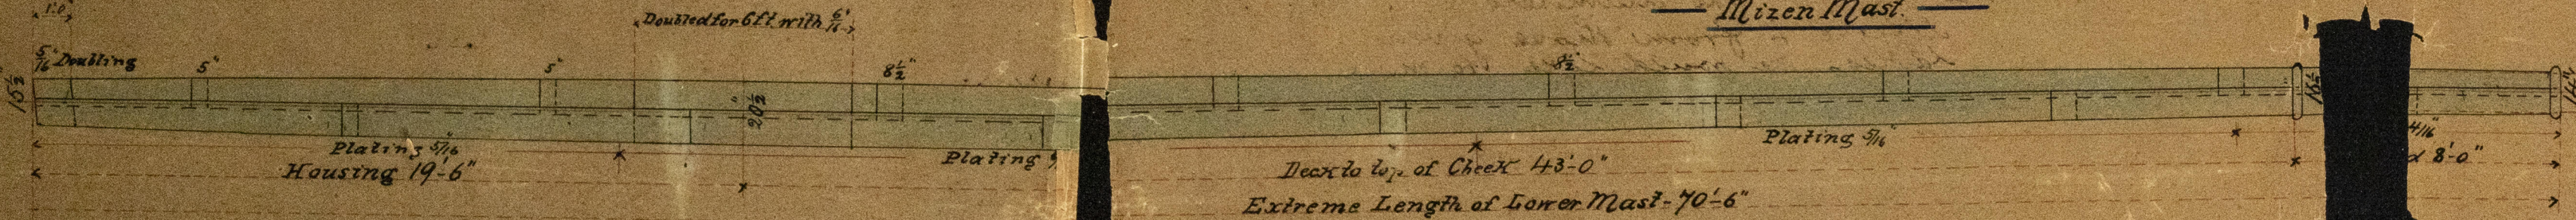


Section th^o Mizzen Mast at Height of Deck

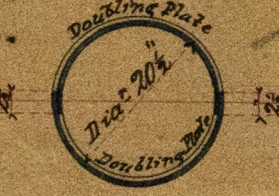

Note. Some of the diameters are slightly different from those given in the tables. We would like to make them as shown.

Note: Iron Mast to be built without Angles
Edges double zigzag riveted in Fore Lower Mast
Single riveted in Main Mast & Mizzen Mast
Butts free & overlapped above Deck - double below.
 $\frac{5}{8}$ " Rivets spaced 3' apart.

SCALE $\frac{1}{4}$ INCH = 1 FOOT

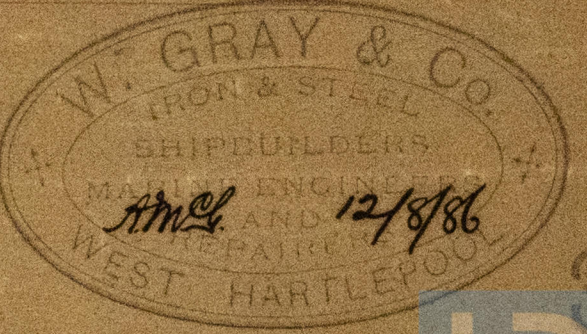

13/8/86

12/8/86

STK 913-0293

Lloyd's Register Foundation