

The words FORGINGS or CASTINGS, IRON or STEEL, should be struck out as may be required.

Received at

W. Hpl

Office,

14. 3.

18 87

# Lloyd's Register of British and Foreign Shipping.

S.S. Manitoba Report on Vessel No. 6398 Port W. Hpl )

No. 511 a

## SHIP FORGINGS OR CASTINGS.

I have to report that the undermentioned Iron or Steel Forgings or Castings, manufactured by

Messrs J Richardson Sons of Northpool  
for the Vessel No. 142, being built by Messrs E Hilly Co.  
of Northpool have been inspected by me as set forth below, and found  
to be, so far as can be seen, sound

Mark on Forgings.

Lloyd's

No. 511 a


H.C.

Hugh Cameron

Sunderland

	STERN FRAME.	RUDDER FRAME.	STEM.
Material* - - - -	Scrap iron	Scrap iron	Scrap iron
How made - - - -	Fayed	Fayed	Fayed
Dimensions - - - -	4' x 5 1/2'	4' x 4'	9' x 2 1/2'
Progress on Inspection -	Fayed & Smithed	Fayed & Smithed	Fayed
Dates when Inspected	Oct 1-11-28 Nov 11-18-23/86	Nov 23 Dec 8-14-23/86 Jan 13-21-25-28 Feb 4-17-24/87	Nov 23/86

SKETCHES OF FRAMES SHEWING POSITION AND DESCRIPTION OF WELDS OF FORGINGS, OR PARTICULARS OF TESTS APPLIED TO CASTINGS.

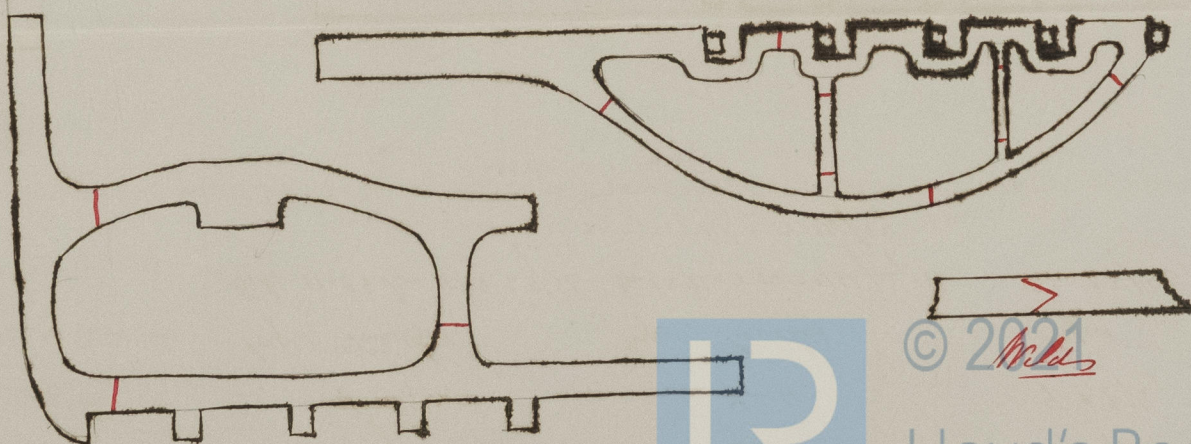

\* If of Iron, state whether scrap or puddled Iron.