


S.S. "Manitoba" W. Spl Report No 6398

13.11.86.


Proposed Strengthening of
26 ft Hatch on Main Deck

Scale $\frac{1}{4}$ in = one foot.

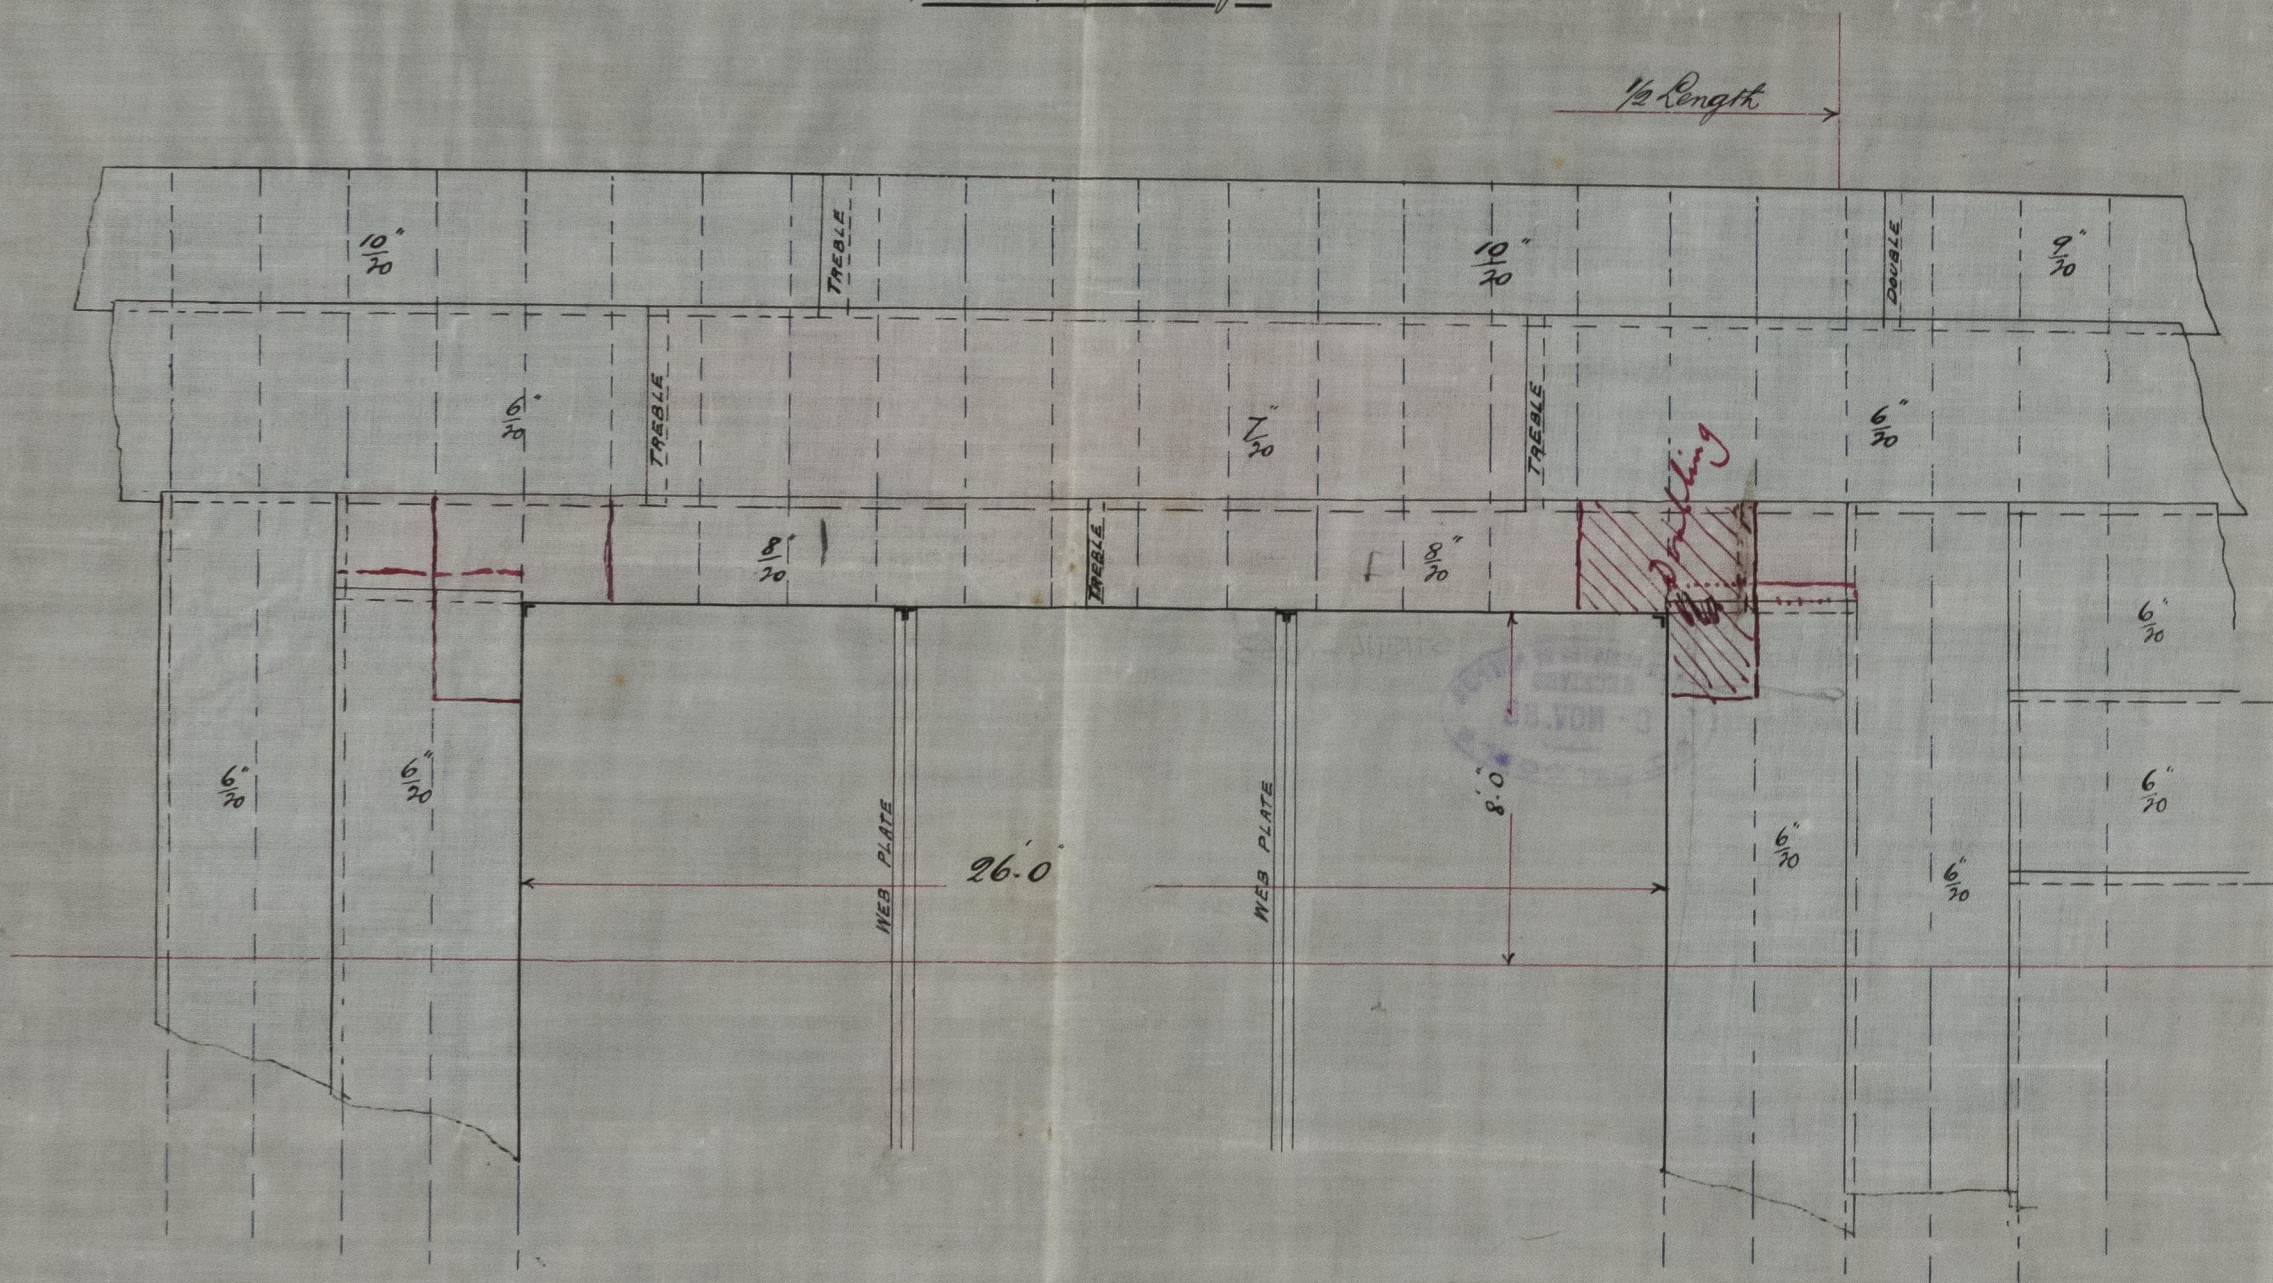

Proposed Strengthening of
22 ft Hatch on Quarter Deck

Scale $\frac{1}{4}$ in = one foot.

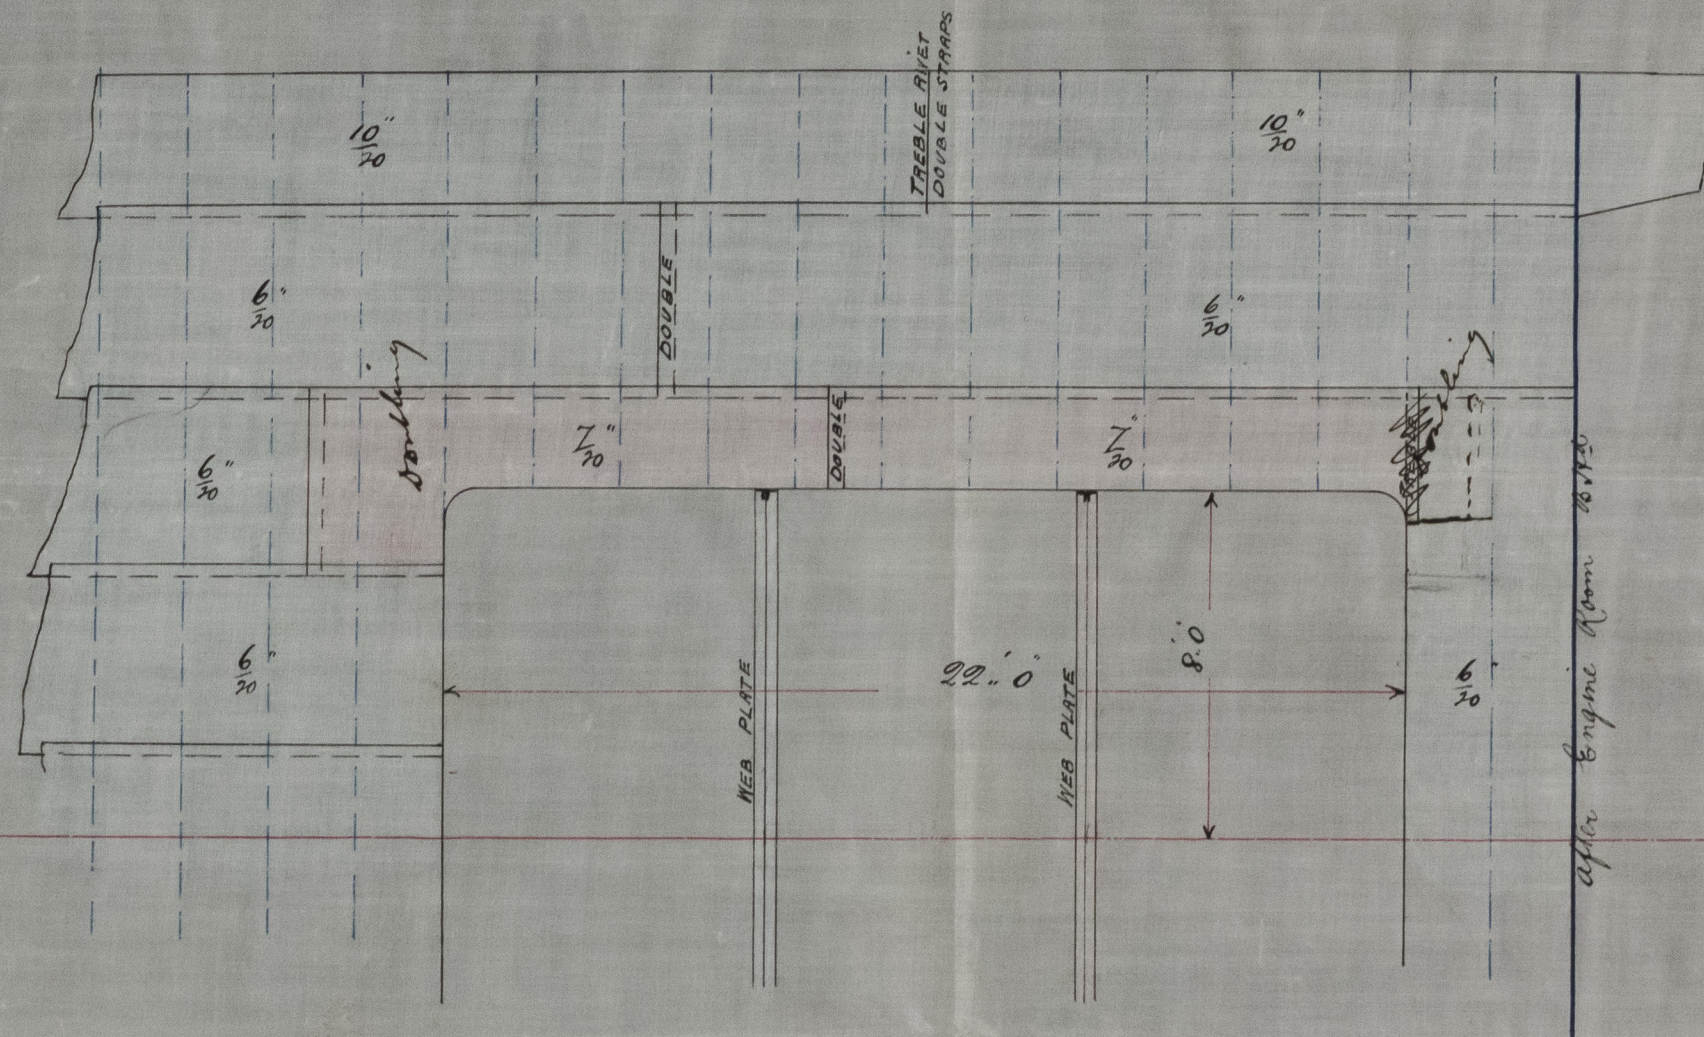


Nº 142.

13/11/86

EDWD. WITTHY & Co.
IRON & STEEL SHIP BUILDERS,
SHIP REPAIRERS & Co.
WEST HARTLEPOOL.


Tracing No 6701
Nov. 8/11/86

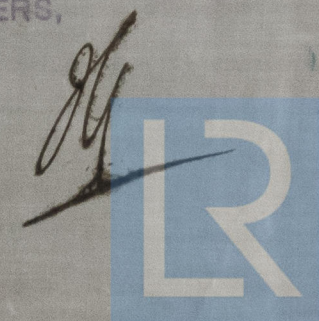

© 2021
Lloyd's Register
Foundation

STK914-0063


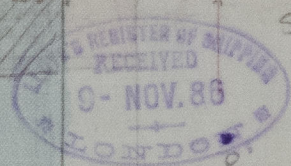

STK914-0063

© 2021

© 2021
Lloyd's Register
Foundation