




4800-111112

SS "Manitoba" W. Supt Report No 6398

14.10.86.

THE PART TINTED	RED	9
		20
-DO-	BLUE	8
		20
-DO-	NEUTRAL	7
		20

— TANK TOP. —
— SCALE $\frac{1}{8}$ IN = ONE FOOT. —

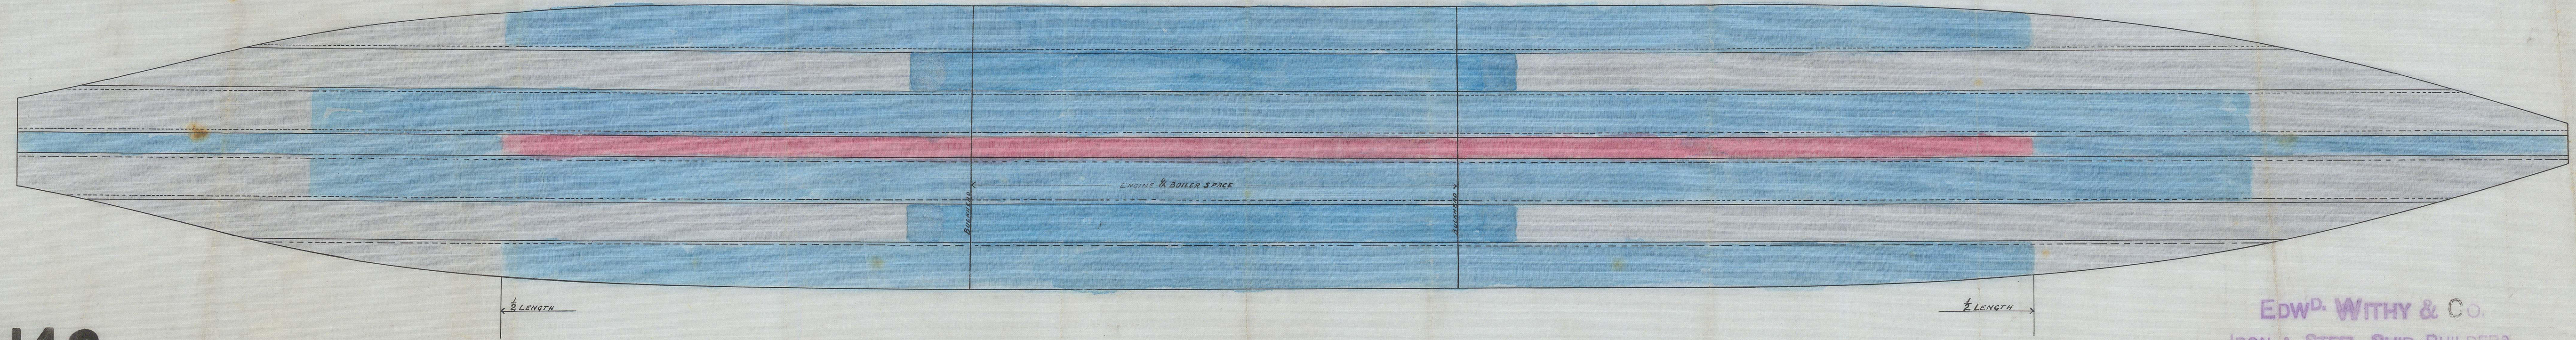

Nº 142

J.H.L.

EDWD. WITBY & CO.
IRON & STEEL SHIP BUILDERS,
SHIP REPAIRERS &c.
WEST HARTLEPOOL.
SEPTEMBER 14TH 1886.



© 2021
Lloyd's Register
Foundation