



Bridge Deck

Middle Deck

Lower Deck

31 x 9/16

Space 31 in apart

24 x 7/16


31 x 9/16

6 1/2 x 3 x 9/16

18m

10/10/80

Longitudinal Plan of No 100 S.S.
Scale $\frac{7}{8}$ inch = 1 foot

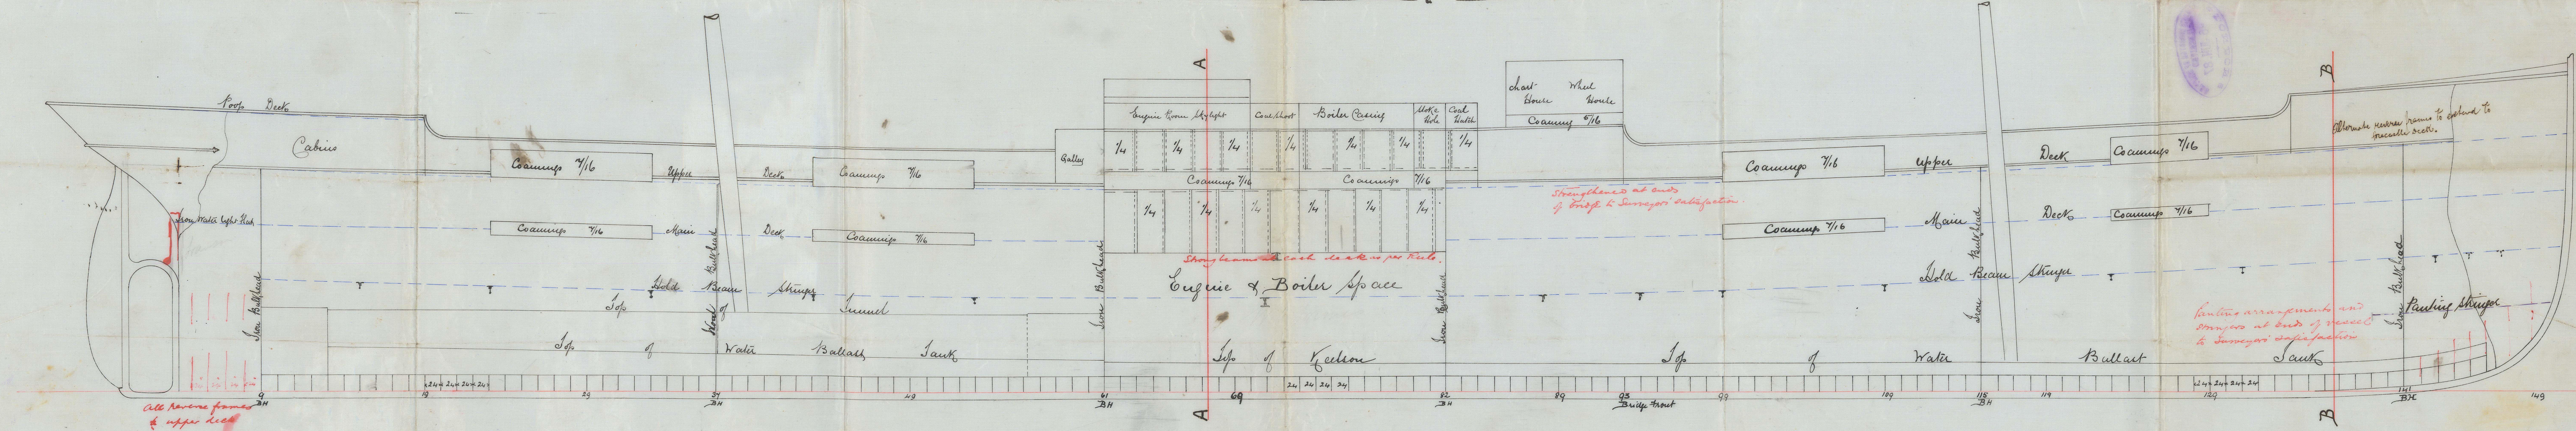

— Section of Newcastle thro' B. B. —

Supelata 11 x 16 Shrimps 24 x 7/16
Wood Deck 3 in
Bassano 7 1/2 x 7/16
Angles 3 x 3 x 7/16
Wood Deck 4"
Iron Deck.

A circular purple ink stamp. The outer ring contains the text "J. TURNBULL & SON" at the top and "WHITE" at the bottom, separated by small stars. The center of the stamp features the text "IRON SHIP BUILDERS" in a bold, serif font, flanked by decorative horizontal flourishes.

9/10/86
LLOYD'S REGISTER
SHIPPING
R.D.

STK914-0227



© 2021

Lloyd's Register
Foundation