

Lloyd's Register of British and Foreign Shipping.

S.S. Swansea (Report on Vessel No. 6501 Port W. H. H.)

No. 541 A SHIP FORGINGS OR CASTINGS.

I have to report that the undermentioned Iron or Steel Forgings or Castings, manufactured by Messrs. The Stockton Forge Co. of Stockton for the Vessel No. 322, being built by Messrs. W. Gray Co. of West Heathpool have been inspected by me as set forth below, and found to be, so far as can be seen, sound and efficient.

The words FORGINGS or CASTINGS, IRON or STEEL, should be struck out as may be required.


Mark on Forgings.

Lloyd's
No. 541 A
H. C.

Hugh Cameron
Sunderland

	STERN FRAME.	RUDDER FRAME.	STEM.
Material* - - - -	<u>Scrap iron</u>	<u>Scrap iron</u>	<u>Scrap iron</u>
How made - - - -	<u>Forged</u>	<u>Forged</u>	<u>Forged</u>
Dimensions - - - -	<u>10' x 6'</u>	<u>7 3/4 - 3 3/4</u>	<u>10' x 2 3/4</u>
Progress on Inspection -	<u>Forged & Smithed</u>	<u>Forged & Smithed</u>	<u>Forged</u>
Dates when Inspected	<u>Jan'y 6-21-25-29 Feb'y 2-11/87</u>	<u>Feb'y 17-24 March 5-14-17-19 28/87</u>	<u>Jan'y 25-29/87</u>

SKETCHES OF FRAMES SHEWING POSITION AND DESCRIPTION OF WELDS OF FORGINGS, OR PARTICULARS OF TESTS APPLIED TO CASTINGS.

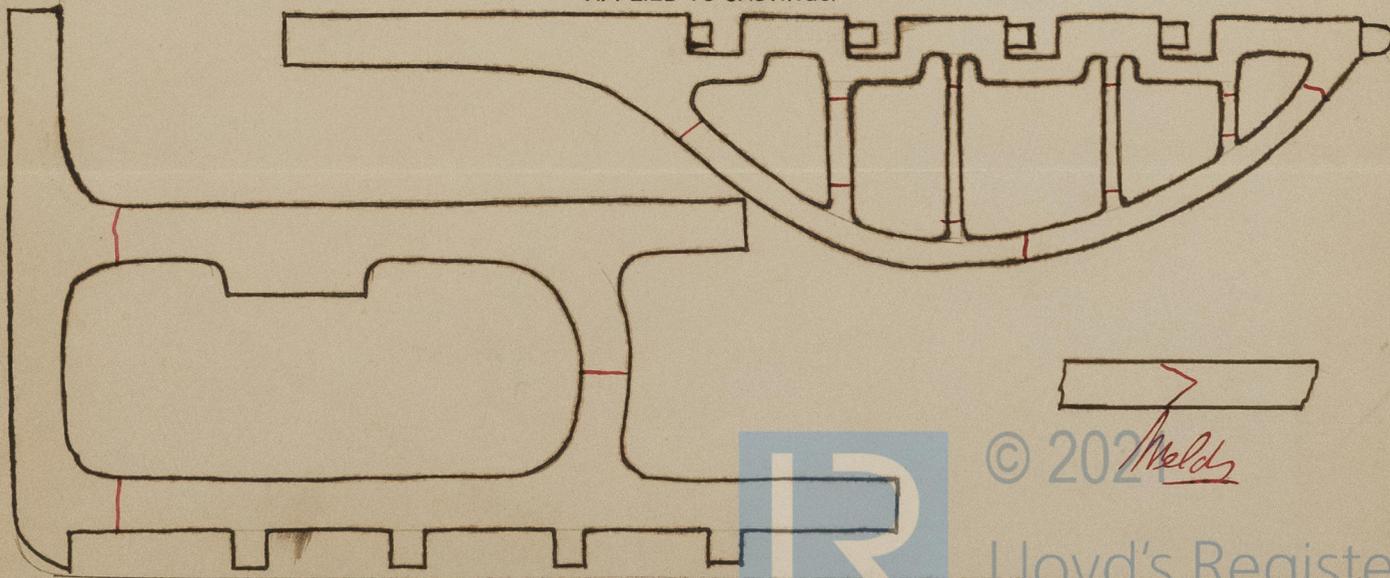

* If of Iron, state whether scrap or puddled iron.

541