


S.S. Roddam W. Lpl Report No 6615.

-S. S. RODDAM- No 147.

Tanks to be put in vessel temporarily for one voyage
vessel then to be restored to original condition.

See letter
19/87

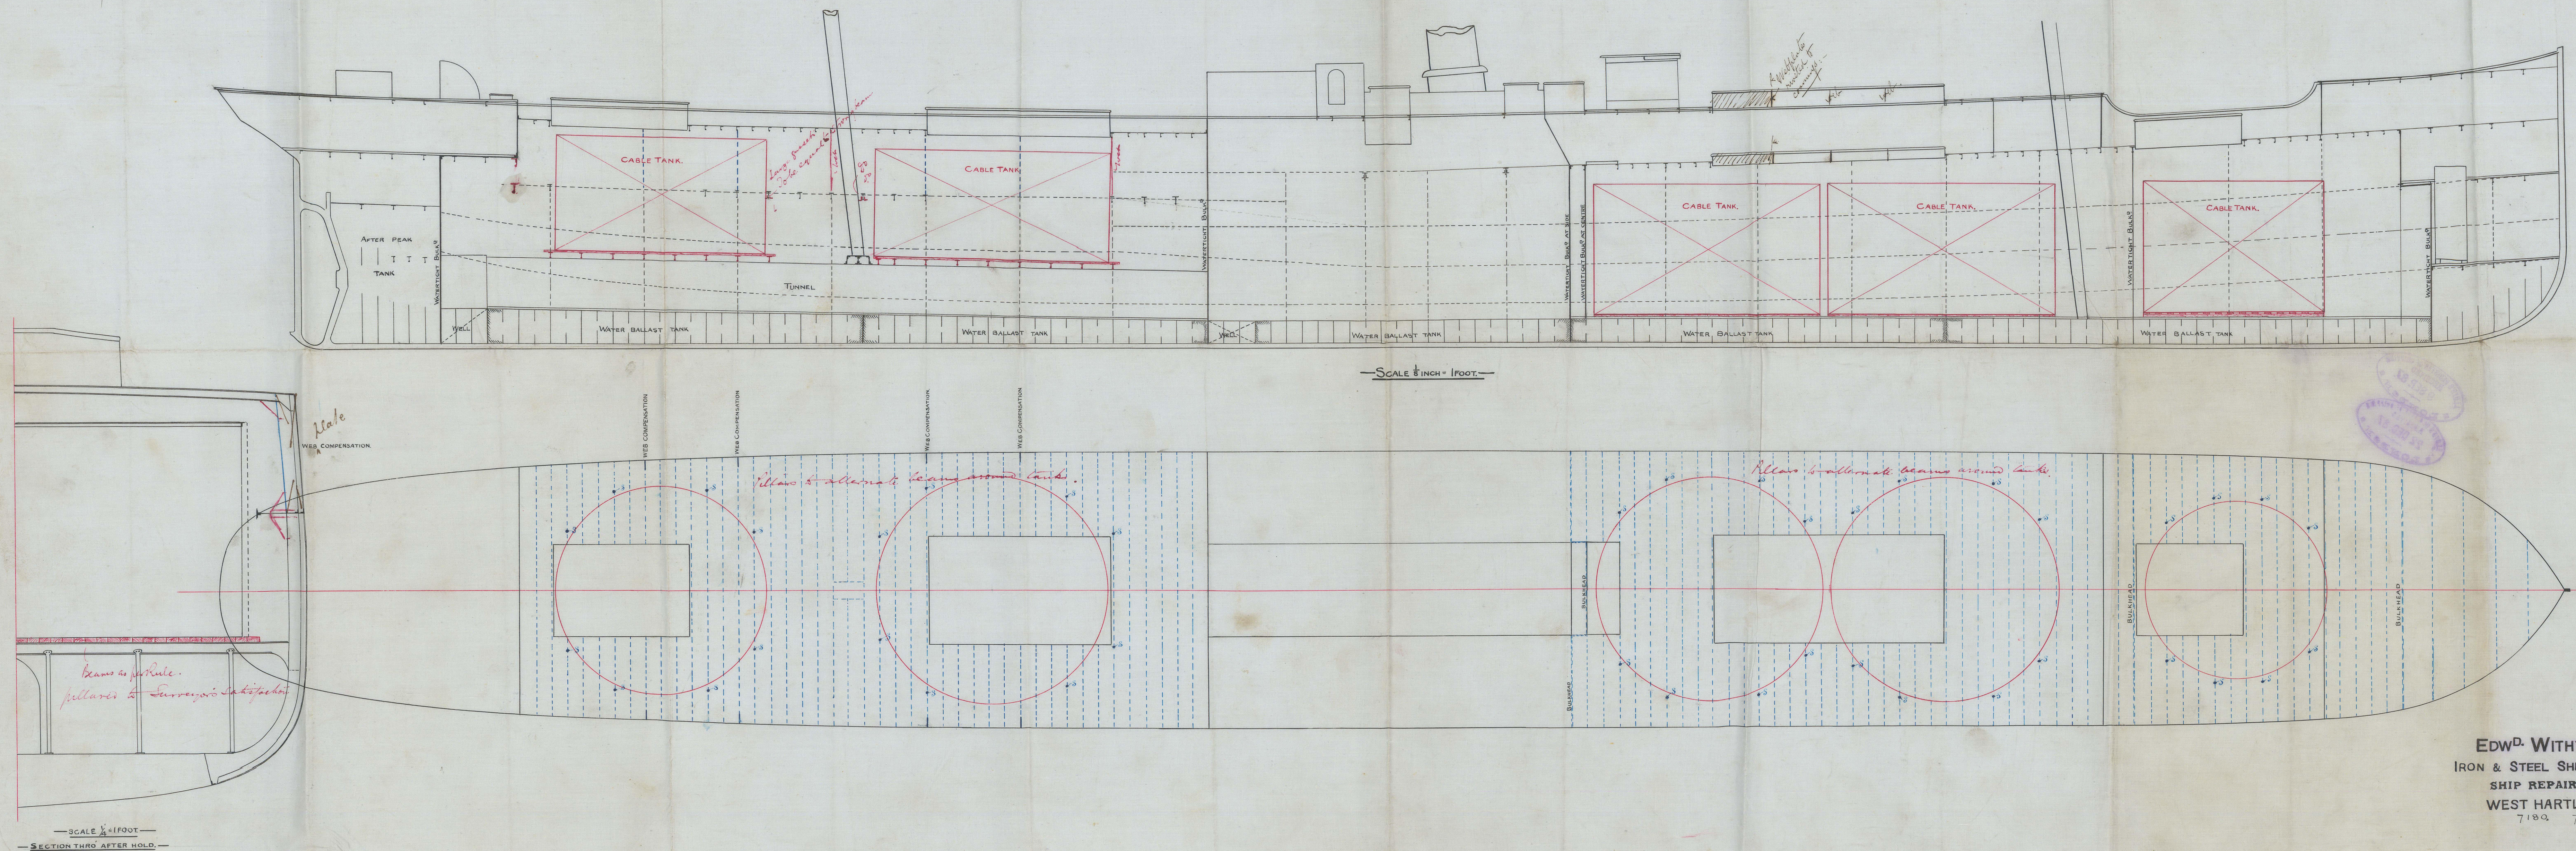

EDWD. WITBY & Co.
IRON & STEEL SHIP BUILDERS,
SHIP REPAIRERS &c.
WEST HARTLEPOOL.
7182 7187.

RECEIVED
9 SEP. 87.
LONDON

RECEIVED
22 DEC. 87.
LONDON






© 2021

Lloyd's Register
STK915-07.51
Foundation