

The words FORGINGS or CASTINGS, IRON or STEEL, should be struck out as may be required.

Received at W. Hpl. Office, 4. 8. 1887

Lloyd's Register of British and Foreign Shipping.

W. Hpl.

S. Roddam (Report on Vessel No. 6615 Port W. Hpl.)

No. 513.a SHIP FORGINGS OR CASTINGS.

I have to report that the undermentioned Iron or Steel Forgings or Castings, manufactured by The Stratton Coy Co. of Stratton for the Vessel No. 147, being built by Morrison & Co. of Southport have been inspected by me as set forth below, and found to be, so far as can be seen, sound.


Mark on Forgings.

Lloyd's
No. 513.a
16.6.

W. Hpl.
Sunderland
3/8/87

	STERN FRAME.	RUDDER FRAME.	STEM.
Material*	<u>Scrap iron</u>	<u>Scrap iron</u>	<u>Scrap iron</u>
How made	<u>Forged</u>	<u>Forged</u>	<u>Forged</u>
Dimensions	<u>10' x 6"</u>	<u>7 3/4' - 8 3/4'</u>	<u>10" x 2 3/4"</u>
Progress on Inspection	<u>Forged & Smithed</u>	<u>Forged & Smithed</u>	<u>Forged</u>
Dates when Inspected	<u>March 17-19-28 April 14-18</u> <u>25-28/87</u>	<u>May 10-18-23-27 June 7-10-15</u> <u>23 July 5-11-14-22/87</u>	<u>April 18/87</u>

SKETCHES OF FRAMES SHEWING POSITION AND DESCRIPTION OF WELDS OF FORGINGS, OR PARTICULARS OF TESTS APPLIED TO CASTINGS.

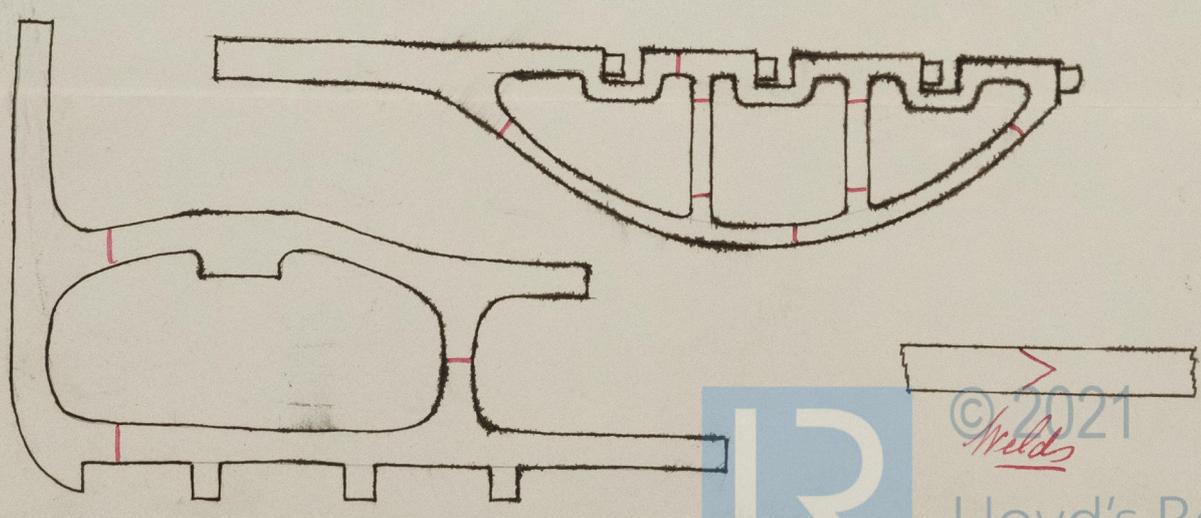

* If of Iron, state whether scrap or puddled iron.

513