

The words FORGINGS or CASTINGS, IRON or STEEL, should be struck out as may be required.

Recd

Lloyd's Register of British and Foreign Shipping.

(Report on Vessel No. 20924 Port Newcastle)

No. 745.A SHIP FORGINGS OR CASTINGS.

I have to report that the undermentioned Iron or ~~Steel~~ ^{repaired} Forgings or Castings, manufactured by The Farrow Forge Co. of Farrow for the Vessel No. —, being built by J. S. Prior of Leith have been inspected by me as set forth below, and found to be, so far as can be seen, sound.

This rudder was fractured as shown on sketch, A, B, and C and has been repaired by forging a new piece on rudder head.

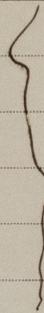
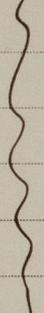
Mark on Forgings.

Lloyd's
No. —

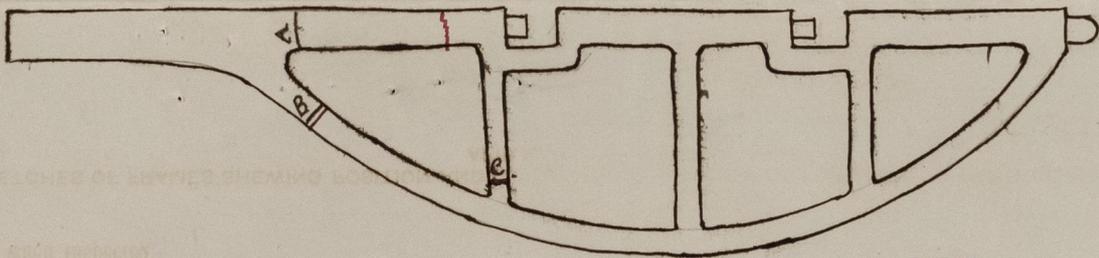
Hugh Cameron

Survey Fee £2-2-0
(will be debited at Sunderland)

Sunderland
9/11/87

	STERN FRAME.	RUDDER FRAME.	STEM.
Material* - - - -		repairing Dec 5-8/87	
How made - - - -			
Dimensions - - - -			
Progress on Inspection -			
Dates when Inspected			

SKETCHES OF FRAMES SHEWING POSITION AND DESCRIPTION OF WELDS OF FORGINGS, OR PARTICULARS OF TESTS APPLIED TO CASTINGS.



© 2021
Lloyd's Register
Foundation

Welds

* If of Iron, state whether scrap or puddled iron.