



11.11.87

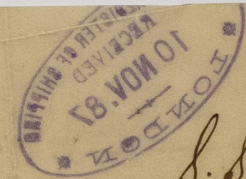

S.S. Lowlands H. Hpl Report No 336. S.S. 6893


Fore Mast

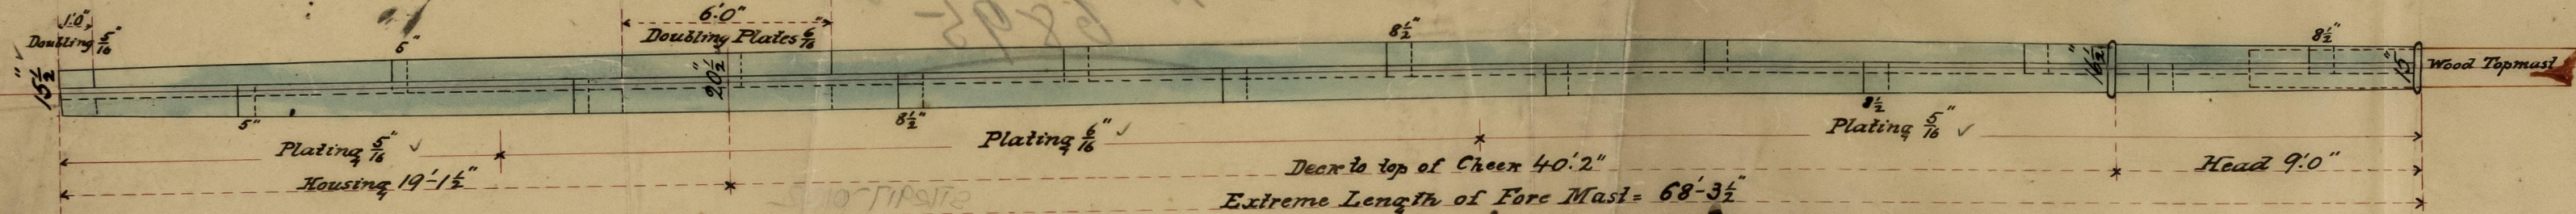


Section thro Fore Mast at Height of Main Ex.



Section thro Main Mast at Height of Quarter Dk.

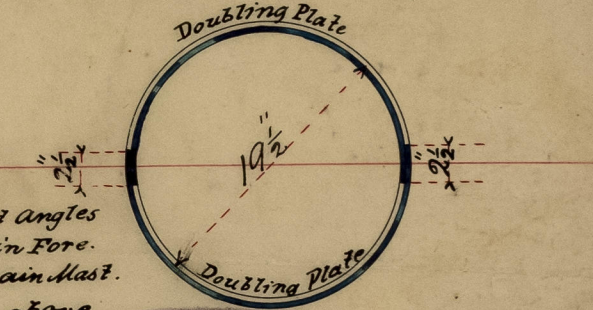

Main Mast.

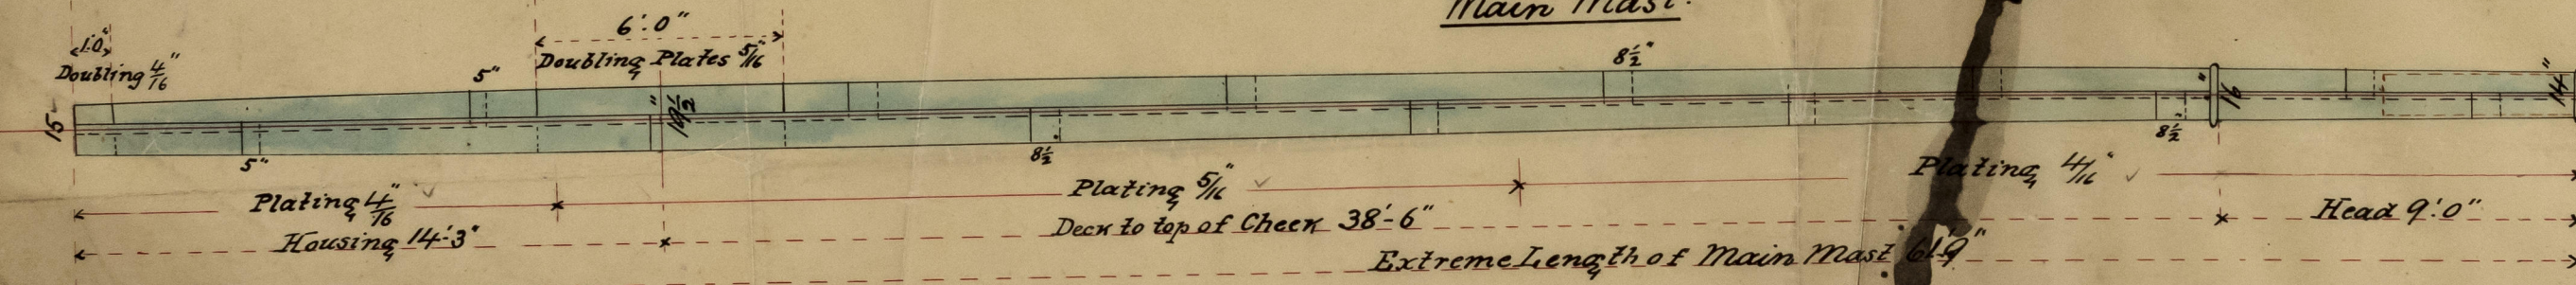

Note Iron Masts to be built without Angles  
Edges double zigzag riveted in Fore.  
Mast - single riveted in Main Mast.  
Built - treble riv'd overlaps above  
Deck - double below.

Scale 1/4" = 1 Foot.

Note. The single riveting of the main mast has been approved of in former cases in consequence of the light rig and no yards being fitted on that mast.



STK 917-0102




REGISTERED  
RECEIVED  
10 NOV 87  
LONDON

No 336.22


Fore Mast

*Handwritten:* 5986  
*Handwritten:* J. J. Lambourne  
*Handwritten:* 11.11.87

Section of Fore Mast at Height of Main

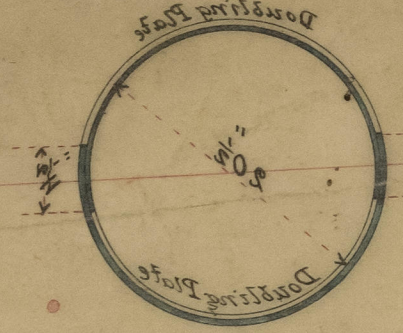


Section of Main Mast at Height of Quarter Deck

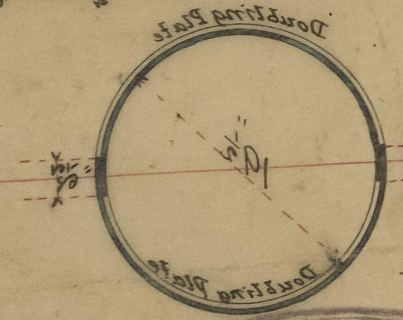

*Handwritten notes:*  
Deck - double below

*Handwritten note:* Note. The single riveting of the main mast has been approved of in former cases in consequence of the light top and no good being fitted on that mast.


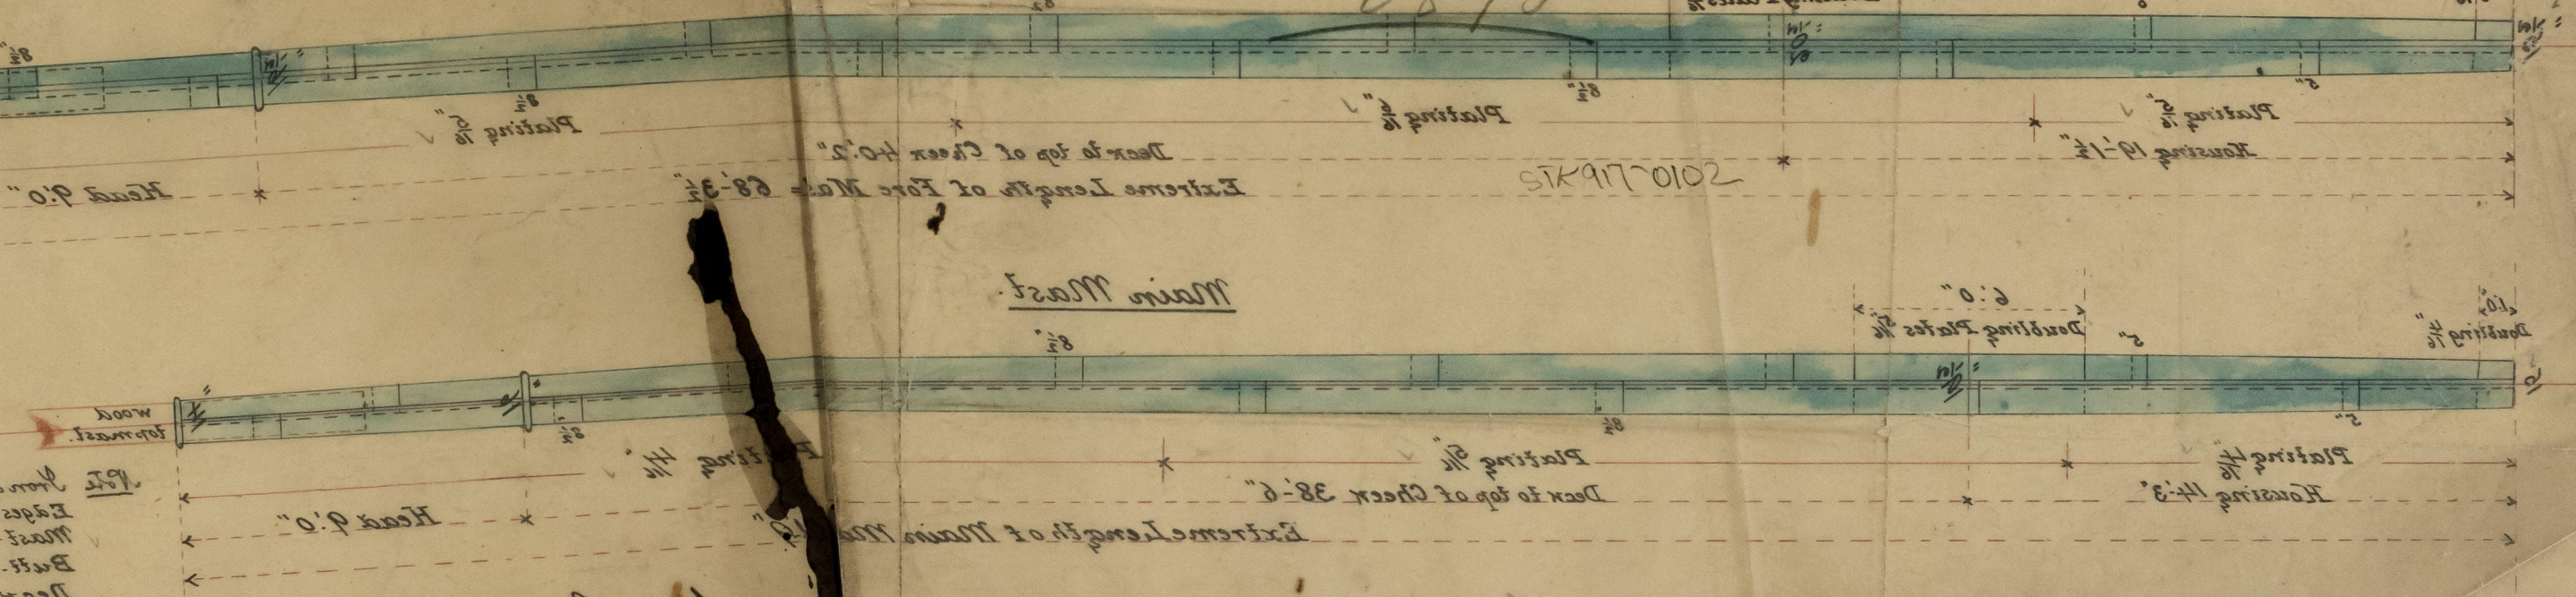

Scale 1/4\"/>