




Nº 289

14th 17/9. 88

S. S. Cahuca

PUMPING ARRANGEMENT
Nº 289
SCALE 1/8 INCH TO ONE FOOT.

*Nº 289
15-9-88*

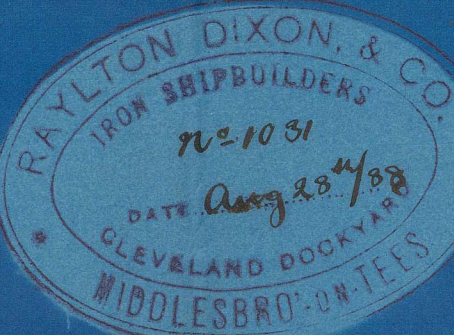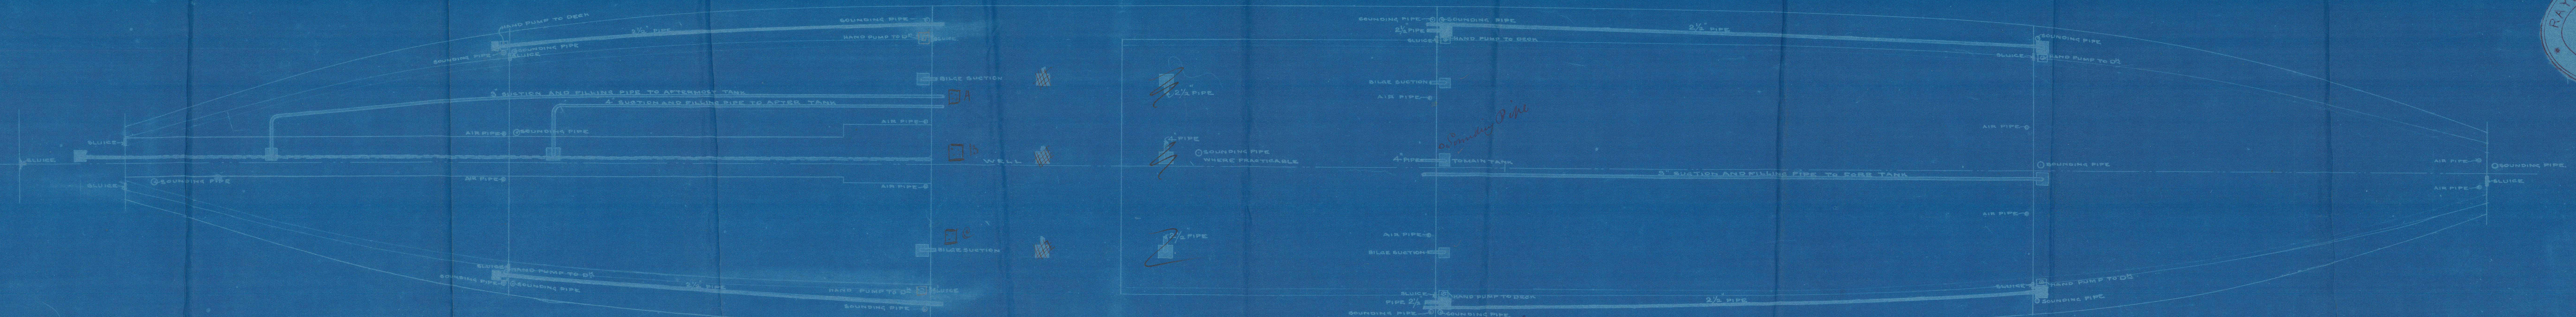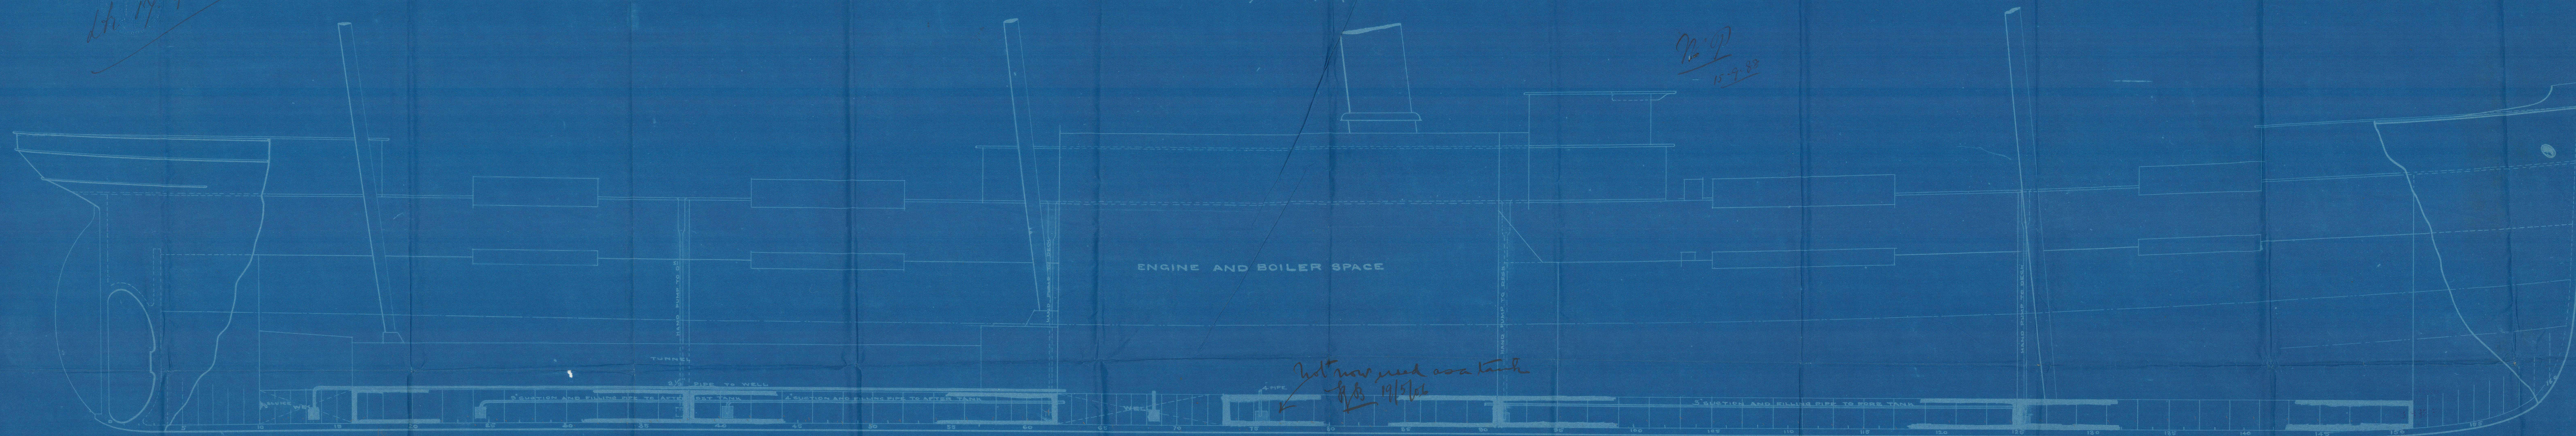

A+C Suctions to main engine + Local Dewatering
13 " " " " + Ballast "



Is. Catania (ex Echnua)

14pl N. 7246,

STK919-0281

0281



© 2021

Lloyd's Register
Foundation