

NUMERALS

1/2 GIRTH.....44.33
 1/2 BREADTH.....19.89
 DEPTH.....29.45
 93.67
 7.08
 86.57
 323
 26001
 17334
 26001
 2799441

EQUIPMENT NO 32216-61

PROPORTIONS

DEPTHS TO LENGTH TO UPPER DECK.....10.96
 MAIN.....14.93
 BREADTHS TO.....8.11

MIDSHIP SECTION

STEEL SCREW STEAMER

SCALE 1/4 INCH TO ONE FOOT


DIMENSIONS

LENGTH OVER ALL.....336.0 DEPTH TO TANK TOP.....28.51
 B.P.....325.0 MOULDED.....28.81/2
 BREADTH EX.....40.0 CLASS AT LLOYDS.....100A1

EQUIPMENT

2 BOWERS EX OF STOCK.....36 1/2 CWTs
 1 STREAM.....31
 1 REDGE.....5 1/2
 1.....2 1/2
 300 FATHOMS OF 1/16" STUO CHAIN CABLE
 50.....1/16" CHAIN OR 1/4" STEEL WIRE
 100.....12 TONLINE OR 4
 90.....10 WARP
 30.....8 1/2

THREE DECKED RULE

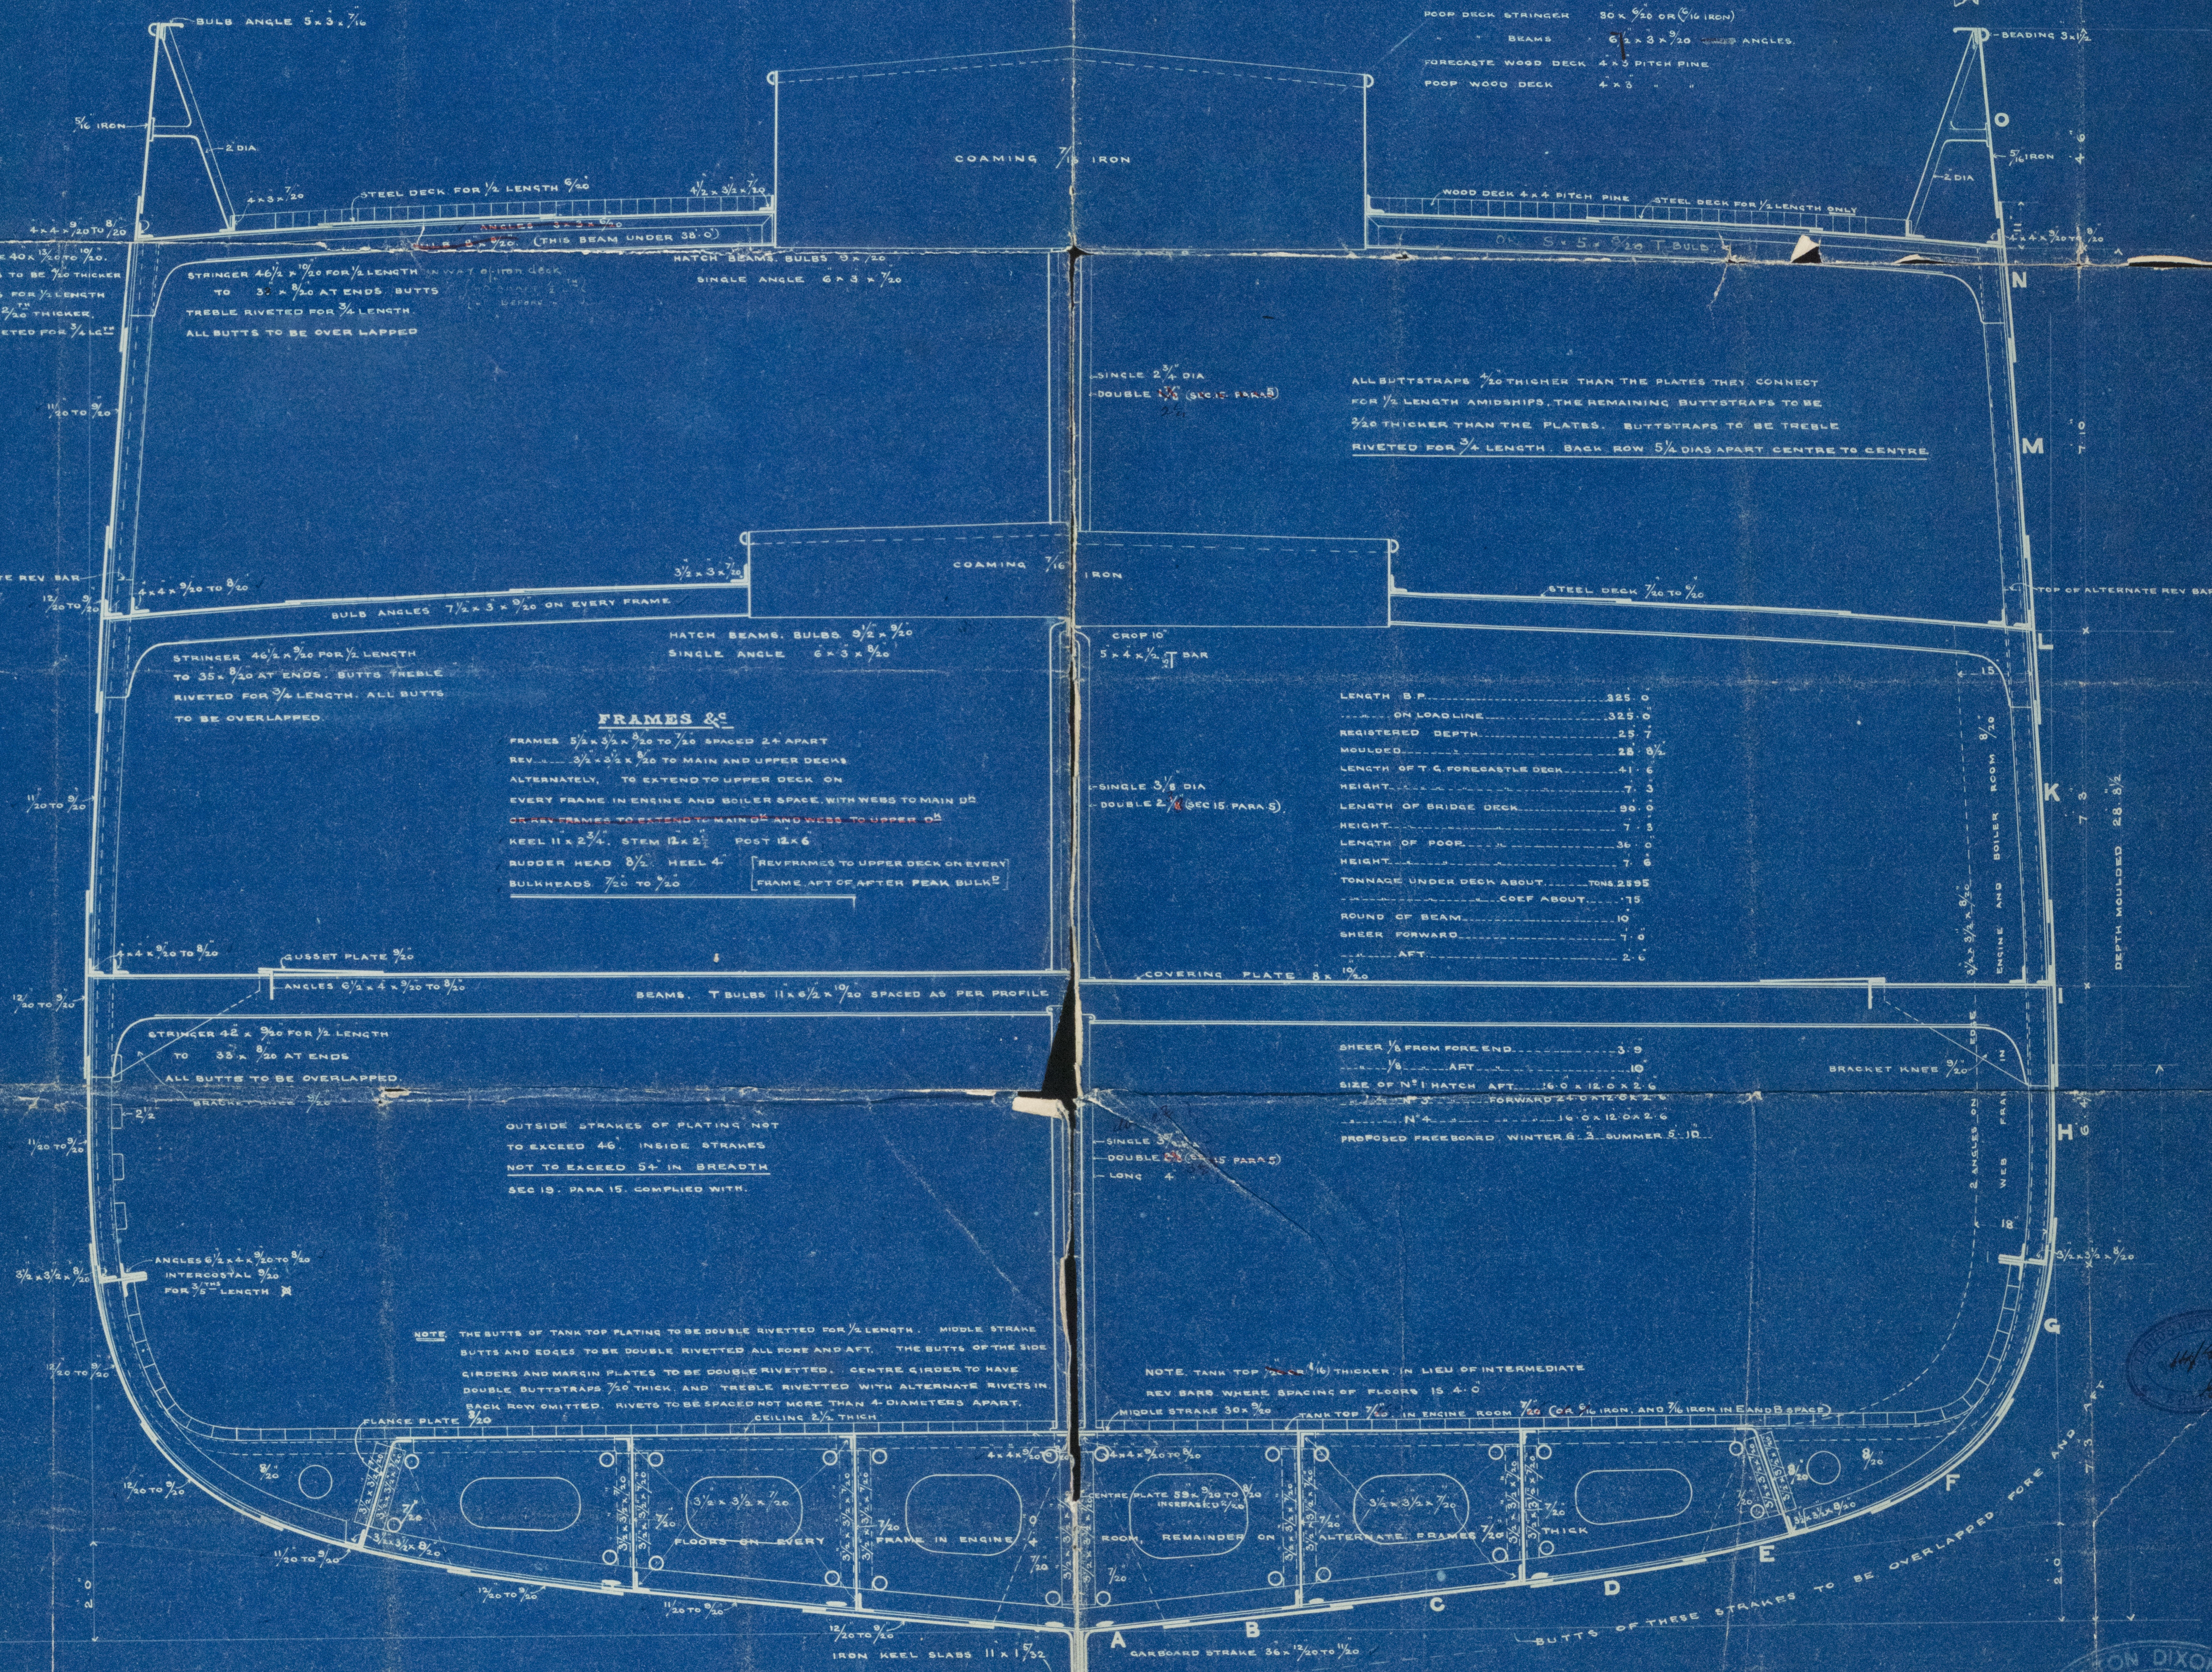


Nº 289

RAYMOND DIXON & CO
 SHIPBUILDERS
 No 5589
 18730
 100 APL 6th 88
 CLEVELAND DOCKYARD
 WHEELS AND TIE

STR 119-0283

STK 919-0283

Midship Section

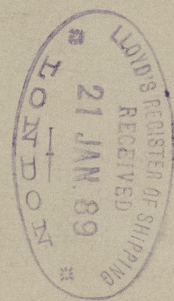

0283



© 2021

Lloyd's Register
Foundation