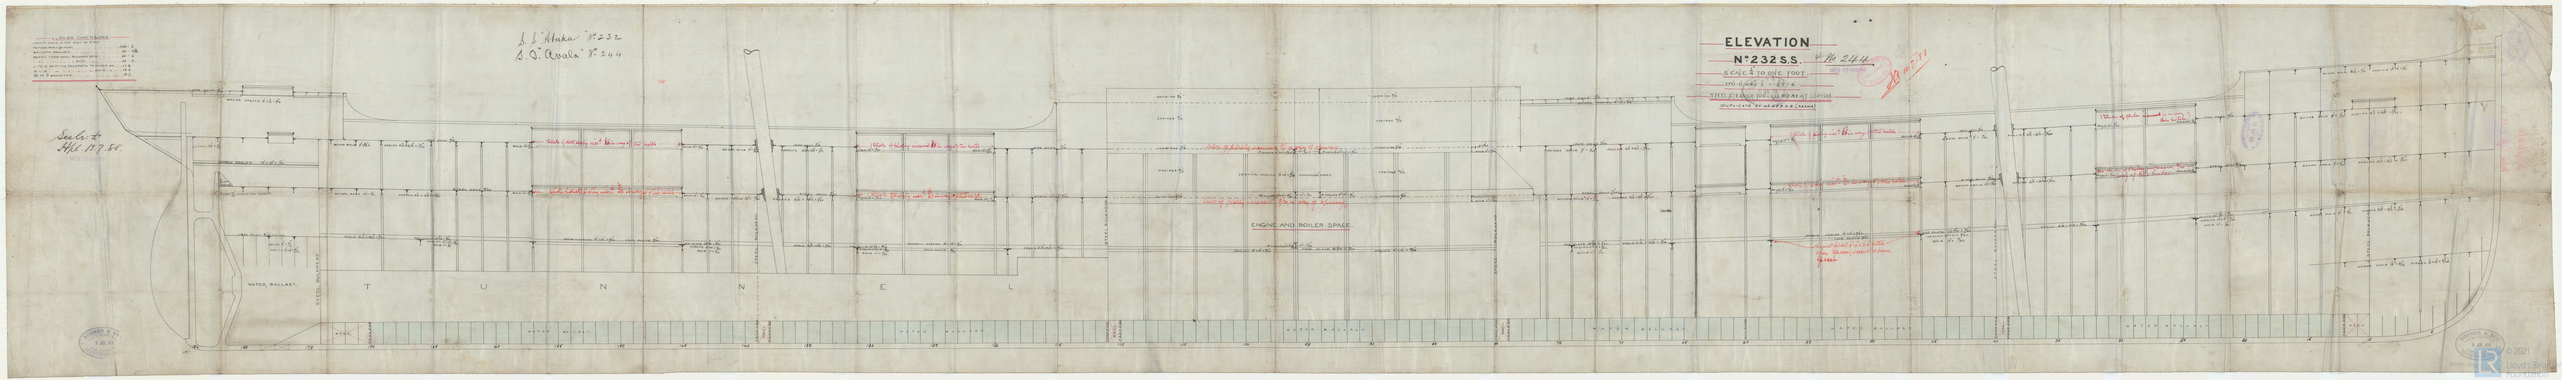
ELEVATION
No. 232 S.S.
SCALE 4 TO ONE FOOT
DUPLICATE OF No. 1 SHEET S.S. (ORIGINAL)
No. 244
Sealed to Hull 13.7.58
LAYER CONDITIONS
WATER BALLAST
TUNNEL
ENGINE AND BOILER SPACE
STEEL BULKHEAD
WATER BALLAST
© 2021 Lloyd's Register

Lo Ataka
Hpl. No. 7334
& S.S. "Avala"
Mbro Report No. 33

STK919-0487

LLOYD'S REGISTER OF SHIPPING
RECEIVED
11 JUL. 88
LONDON

© 2021
Lloyd's Register
Foundation