

B. S. Garlands

Received at West Hartlepool Office, 28th June 1889

Lloyd's Register of British and Foreign Shipping.

W. Hoop

(Report on Vessel No. 4607 Port W. Hart)

No. 13300

SHIP FORGINGS OR CASTINGS.

IRON, IRON or STEEL, should be struck out as may be required.

I have to report that the undermentioned Iron or ~~Steel~~ Forgings or Castings, manufactured by

The Stockton Forge Co of Stockton

for the Vessel No. 368, being built by Messrs H. Gray & Co

of Warrington have been inspected by me as set forth below, and found

to be, so far as can be seen, sound.


Forgings.

Order No. 13300
D.C.

W. Hoop
Sunderland 27/6/89

	STERN FRAME.	RUDDER FRAME.	STEM.
Material	Scrap iron	Scrap iron	Scrap iron
Condition	Fayed	Fayed	Fayed
Dimensions	9 x 5 1/2"	4 - 3 1/2"	9 x 2 1/2"
Inspection	Fayed & Smithed	Fayed & Smithed	Fayed
When Inspected	March 22-28 April 2-9 16-26/89	May 24-31 June 5-14/89	March 28/89

SKETCHES OF FRAMES SHOWING POSITION AND DESCRIPTION OF WELDS OF FORGINGS, OR PARTICULARS OF TESTS APPLIED TO CASTINGS.

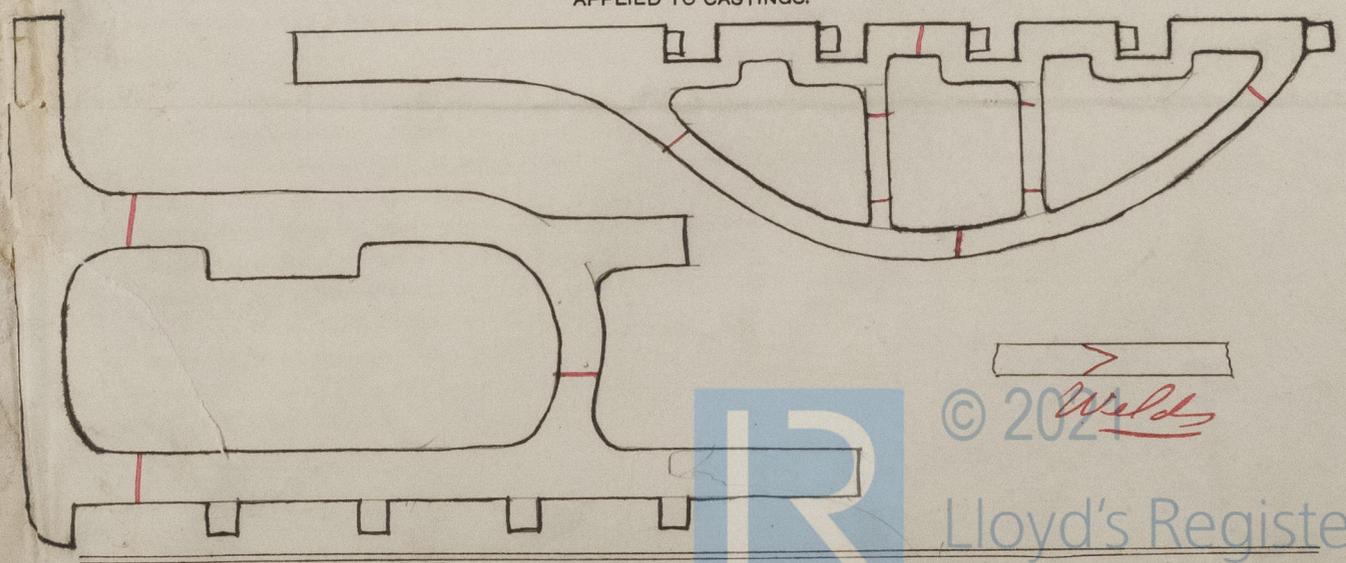

* If of Iron, state whether scrap or puddled Iron.