

MIDSHIP SECTION RAISED QUARTER D^K STEEL STEAMER

SCALE 1/2 INCH TO ONE FOOT

DIMENSIONS

LENGTH OVER ALL	304.0	DEPTH OF HOLD TO TOP OF TANK	20.4
B. P.	295.0	MOULDED	22.9
BREADTH EXTREME	38.0	CLASS AT LLOYDS	100A.1

QUARTER DECK RULE

EQUIPMENT

2 BOWER ANCHOR EX OF STOCK	32 CWT.
1 STREAM	10 1/2
1 KEDGE	5 1/2
1 KEDGE	5 1/2
1 KEDGE	5 1/2
76	1 1/2
90	12
90	9 1/2
90	7 1/2


1/2 GIRTH.....37.50
1/2 BREADTH.....18.89
DEPTH.....23.50
79.89
293.33
239.67
239.67
719.01
159.78
23434.1337

TUE 18 SEP 83

PROPORTIONS

DEPTHS TO LENGTH.....2.12:48
BREADTHS.....7.7

EQUIPMENT No 26079.59

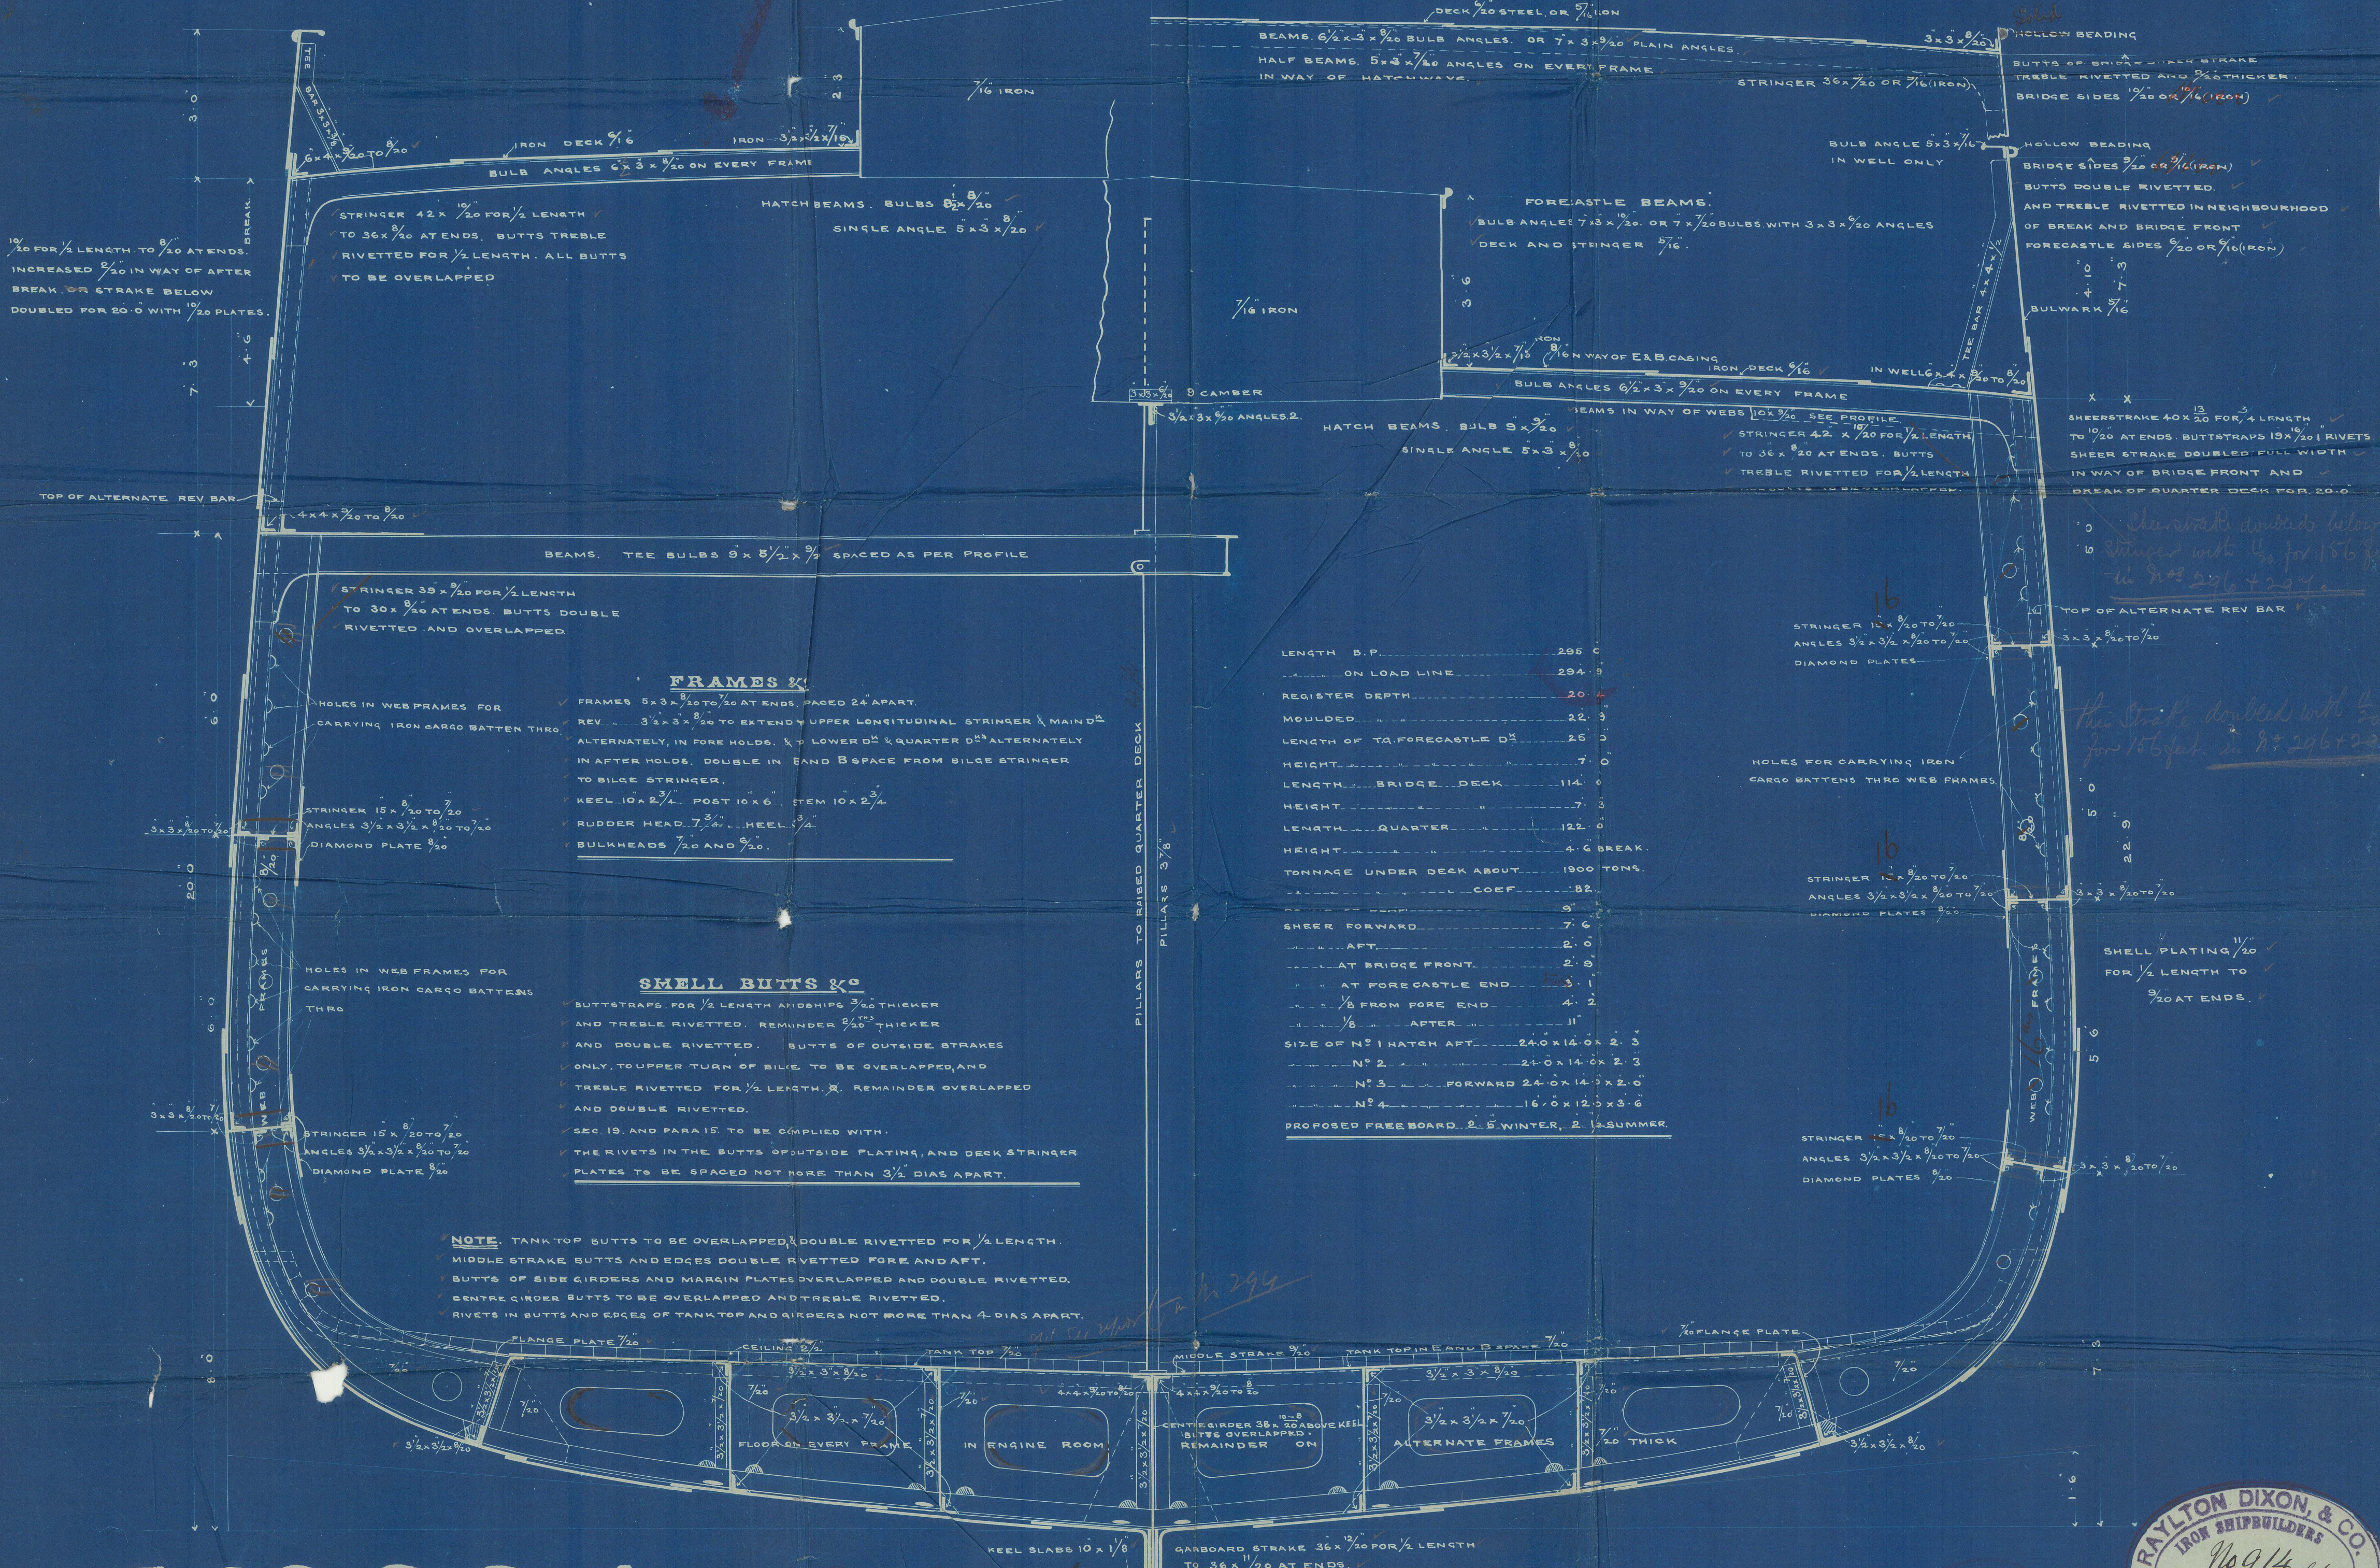


No. 294




292; 296 297, 298 + 299

See list of plates

TUE 18 SEP 83

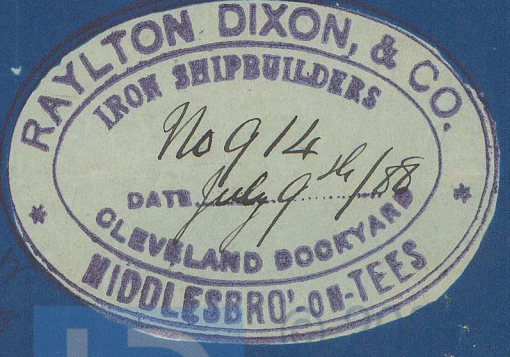

292-4-6-7-8
Midship Section

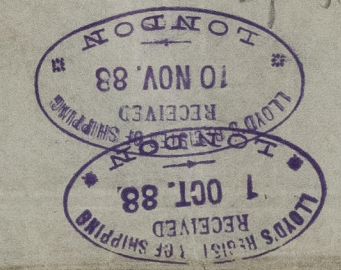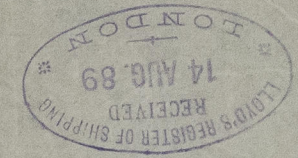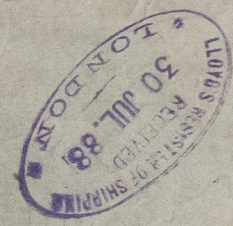

Sp. Varkman
ex. d. Maas
in S. v. d. Maas
W. de 7088



© 2021
Lloyd's Register
Foundation

LLOYD'S REGISTER OF SHIPPING
RECEIVED
17 MAR. 89
LONDON

LLOYD'S REGISTER OF SHIPPING
RECEIVED
14 JUL. 88
LONDON

LLOYD'S REGISTER OF SHIPPING
RECEIVED
11 JUN. 89
LONDON

LLOYD'S REGISTER OF SHIPPING
RECEIVED
11 JUN. 89
LONDON



© 2021
Lloyd's Register
Foundation