

S.S. "Ironopolis"

Received at

Office,

14

Lloyd's Register of British and Foreign Shipping.

(Report on Vessel No. 4608 Port West Hartlepool)

W. Pool

No. 1137A

SHIP FORGINGS ^{and} OR CASTINGS.

I have to report that the undermentioned Iron ^{and} or Steel Forgings ^{and} or Castings, manufactured by

The Darlington Forge Co. of Darlington
for the Vessel No. 298, being built by Messrs R Dixon & Co.
of Middlesbrough have been inspected by me as set forth below, and found
to be, so far as can be seen, sound

The stern frame cast in two pieces, tested in accordance with the
Rules and found satisfactory

Mark on Forgings.


Lloyd's

No. 1137A
R.D.C.

W. Cameron
Sunderland

| | STERN FRAME. | RUDDER FRAME. | STEM. |
|------------------------|---------------------------------|--------------------------------------|----------|
| Material* | Siemens cast steel | Scrap iron | |
| How made | cast in two pieces & scarfed | Forged | |
| Dimensions | as per drawing attached | 7 3/4" - 3 3/4" | |
| Progress on Inspection | cast and finished | Forged & Smithed | Not seen |
| Dates when Inspected | Feb 13 - March 6 April 12-16/89 | April 5-12-16-26 May 1-4-11-16/89 | |

SKETCHES OF FRAMES SHEWING POSITION AND DESCRIPTION OF WELDS OF FORGINGS, OR PARTICULARS OF TESTS APPLIED TO CASTINGS.

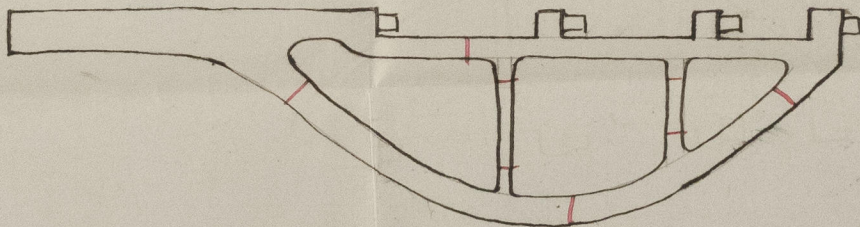

© 2021
Wells

Lloyd's Register
Foundation

* If of Iron, state whether scrap or puddled Iron.