

S.S. "Daylight"

Received at

Office.

18

Lloyd's Register of British and Foreign Shipping.

(Report on Vessel No. 7640 Port )

Wool

No. 1140A.

SHIP FORGINGS OR CASTINGS.

The words FORGINGS or CASTINGS, IRON or STEEL, should be struck out as may be required.

I have to report that the undermentioned Iron or Steel Forgings or Castings, manufactured by the Darlington Forge Co. of Darlington for the Vessel No. 302, being built by Messrs R Dixon & Co. of Middlesbrough have been inspected by me as set forth below, and found to be, so far as can be seen, sound

This stern frame has been tested in accordance with the Rules and found satisfactory

Mark on Forgings.

Lloyd's


No. 1140A.

Wm Cameron

Sunderland 12/6/88

Table with 4 columns: STERN FRAME, RUDDER FRAME, STEM. Rows include Material, How made, Dimensions, Progress on Inspection, and Dates when Inspected.

SKETCHES OF FRAMES SHEWING POSITION AND DESCRIPTION OF WELDS OF FORGINGS, OR PARTICULARS OF TESTS APPLIED TO CASTINGS.

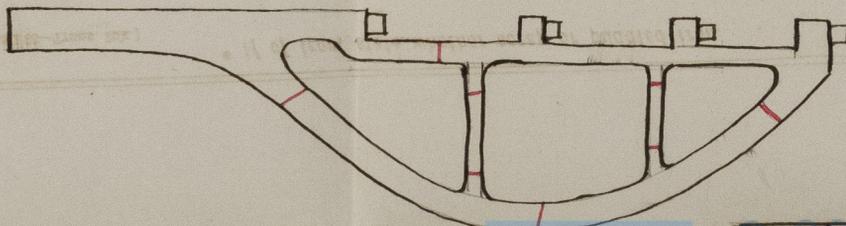

Welds



Lloyd's Register Foundation