

Oderwerke, Grabow a. O.

Anlage

zum Briefe vom 31. 12. 98. No.
an Lloyds Register
London

179. 2000. 180997.



STN 1152-0014 3/4

S.S. No 500.

Length (Lloyds)-----193'-6 1/2"
Breadth moulded-----30'-2"
Depth moulded-----14'-1 1/2"
Draft to top of keel-----12'-0"

Scale 1:100.


Oderwerke
Maschinenfabrik & Schiffbauwerft A. G.

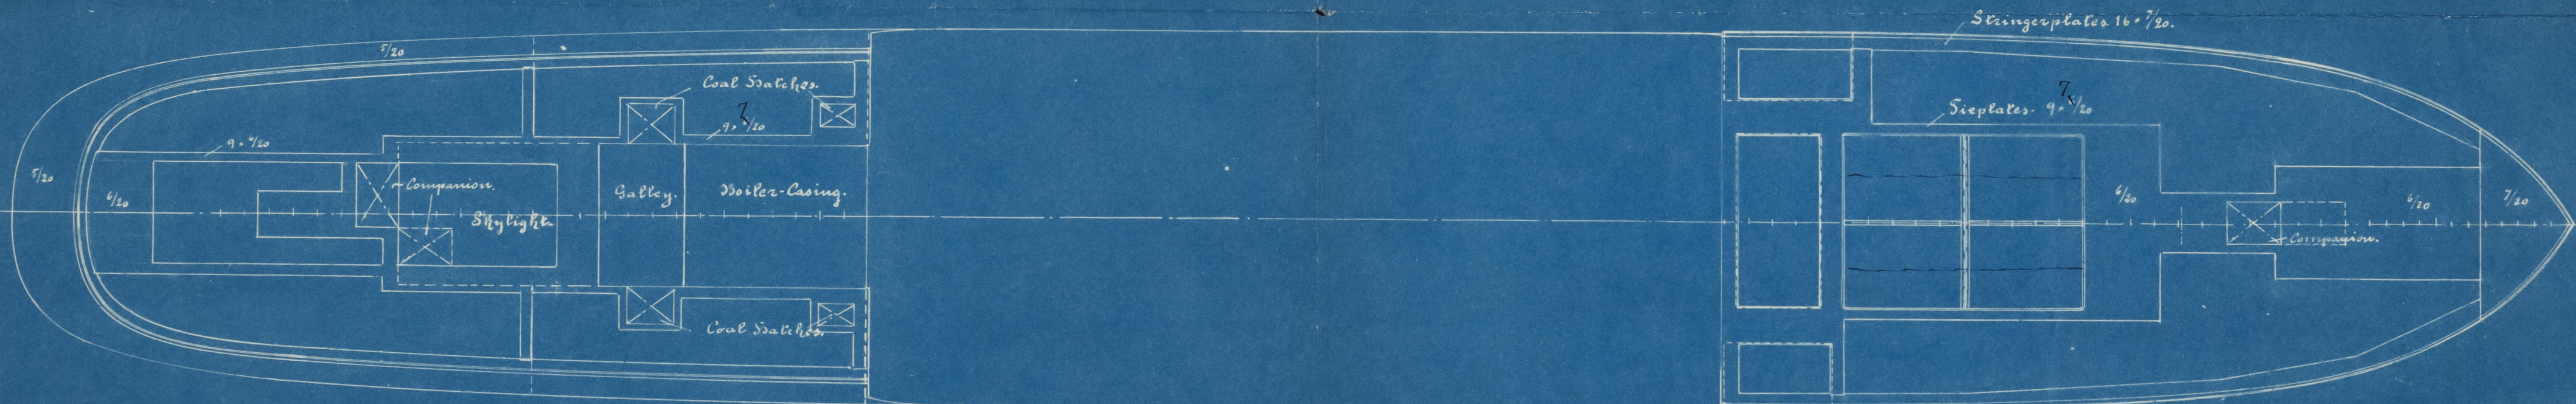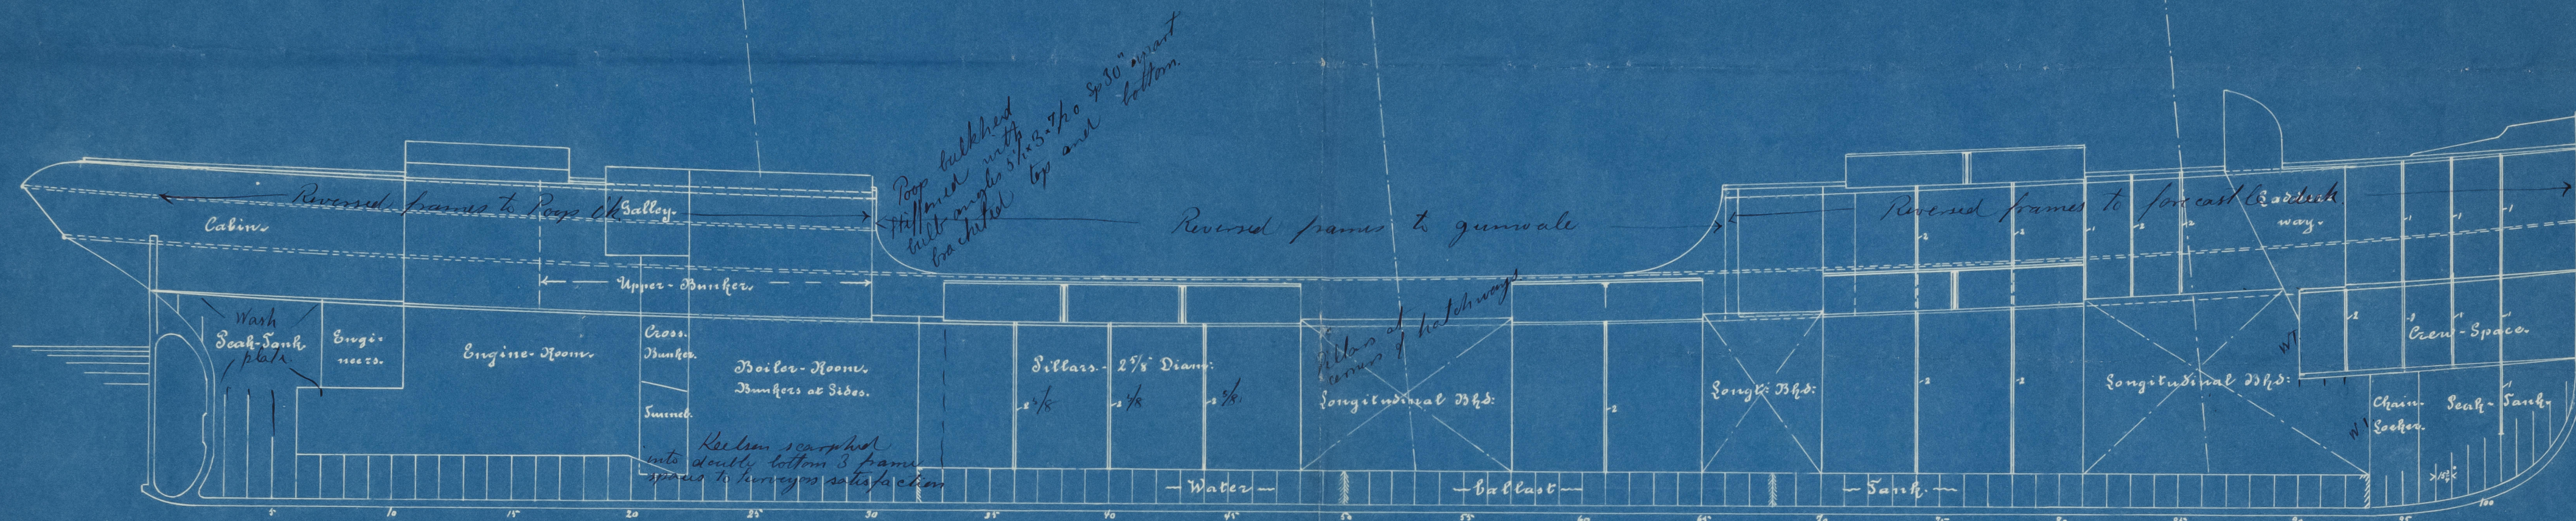

Pop-

and

Forecastle deck.

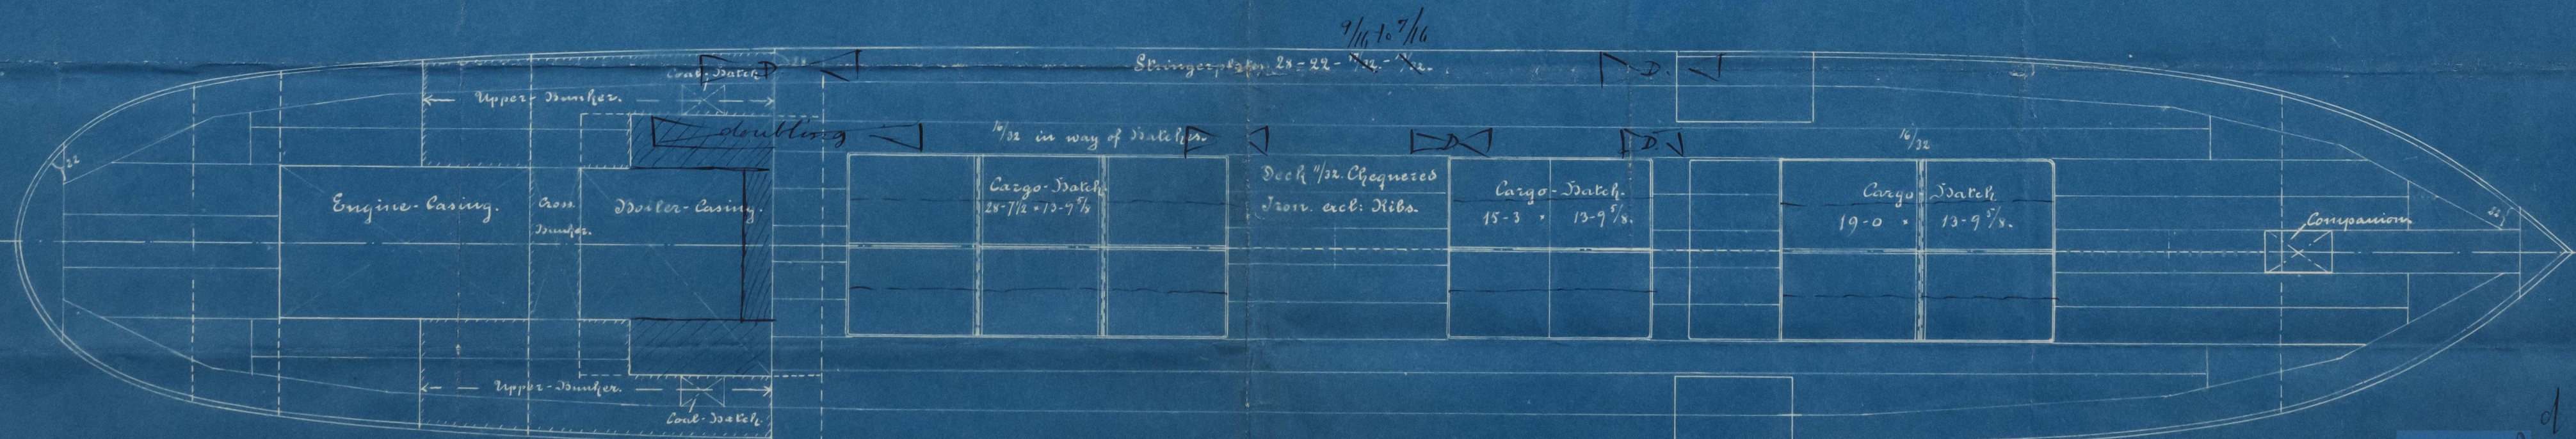

Main deck.

Copy of Plan
and 11/1/99.

STN 1152-0014 3/4

Schiffbau-Bureau


1123

S.S. No 500.

Length (Lloyd's)-----193'-6 1/2".
 Breadth moulded-----30'-2".
 Depth moulded-----14'-1 1/2".
 Draft to top of keel-----12'-0".

Scale 1:100.


Oderwerke
 Maschinenfabrik & Schiffbauwerk A. G.

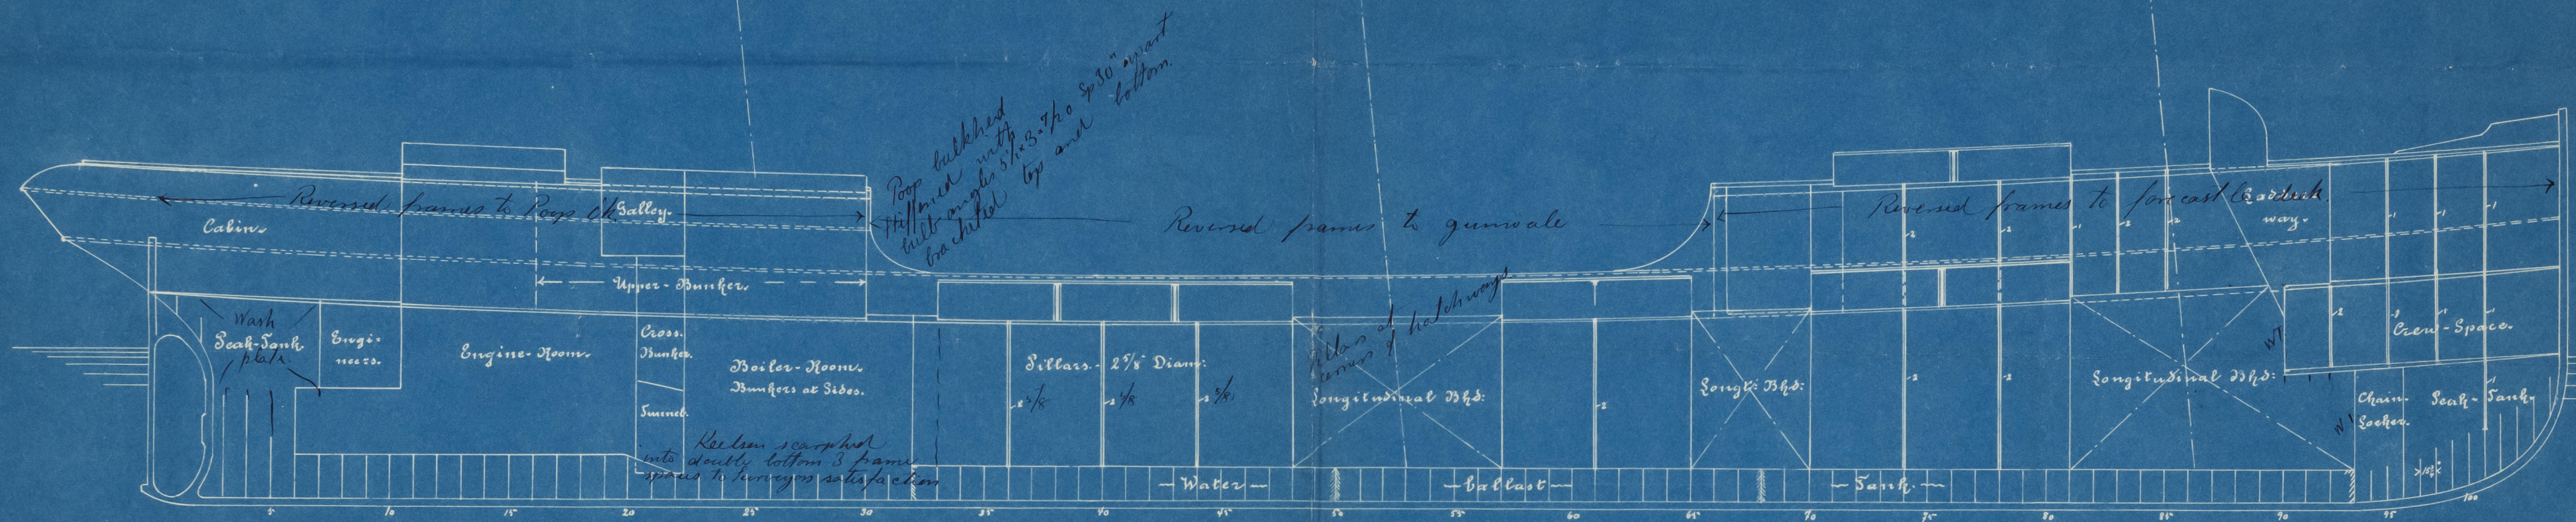

Poop-

and-

Forecastle Deck.

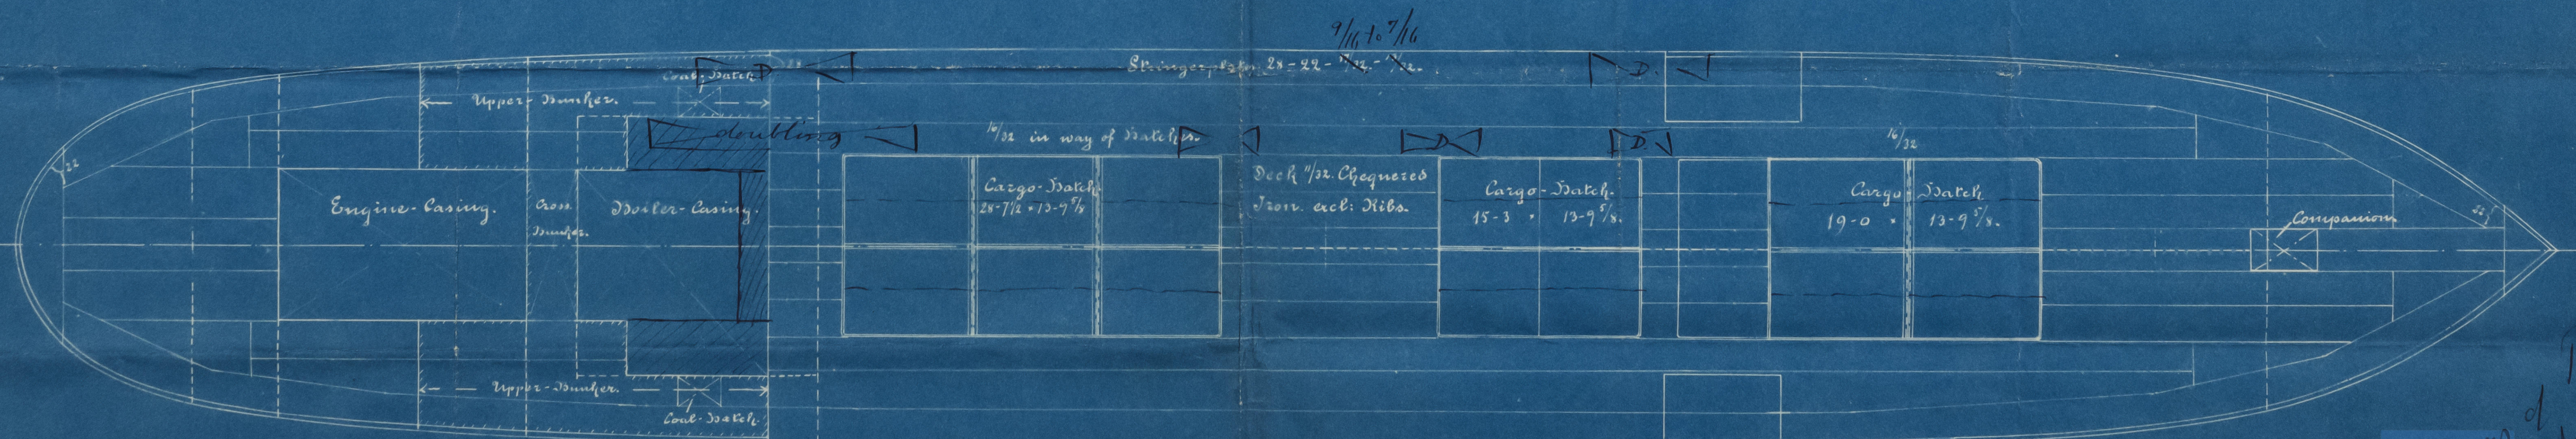

Main Deck.

Copy of Plan
 and 11/1/99.

Box *General* No. in Box *373*

Builders & Yard No. *Oderwerke H. S. Gessell 500*


Copy of *H.S. P. & S. Plans*

STN1152-0014 $\frac{2}{3}$

Date *11/1/99*

Ank. 5. 1. 99

Antw.

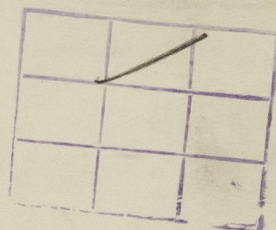

Profile & Deck plans

Lt. Imil Berenz
Stn 47.

STN1152-0014 $\frac{1}{3}$



© 2021

Lloyd's Register
Foundation