

Oderwerke, Grabow a. O.

Anlage

zum Briefe vom 31. 12. 98. No.

an Lloyds Register

London

179. 2000. 280997.

STN 1152-0015 1/2

S.S. Nr. 500

Midship-Section.

Scale 1/25

Length (Lloyd's) 193' - 6 1/2"

Breadth moulded 30' - 2"

Depth moulded 14' - 1 1/4"

Draft to top of keel 12' - 0"

Class 100 A1 * A-C.S. Lloyd's Register.

and 100 A(E).L. Germ. Lloyd.

1/2 Breadth 15.09

1/2 Depth 24.00

Depth 14.73

1st Number 56.82 x 193.56

2nd Number 10998


1/8 6.42 1/16 13.12

Oderwerke
Maschinenfabrik & Schiffbauwerk A. G.

Forecastle not rounded at Sunnvale

Stringer Plate 16. 7/20

Stringer Bar 2 1/2. 2 1/2. 6/20

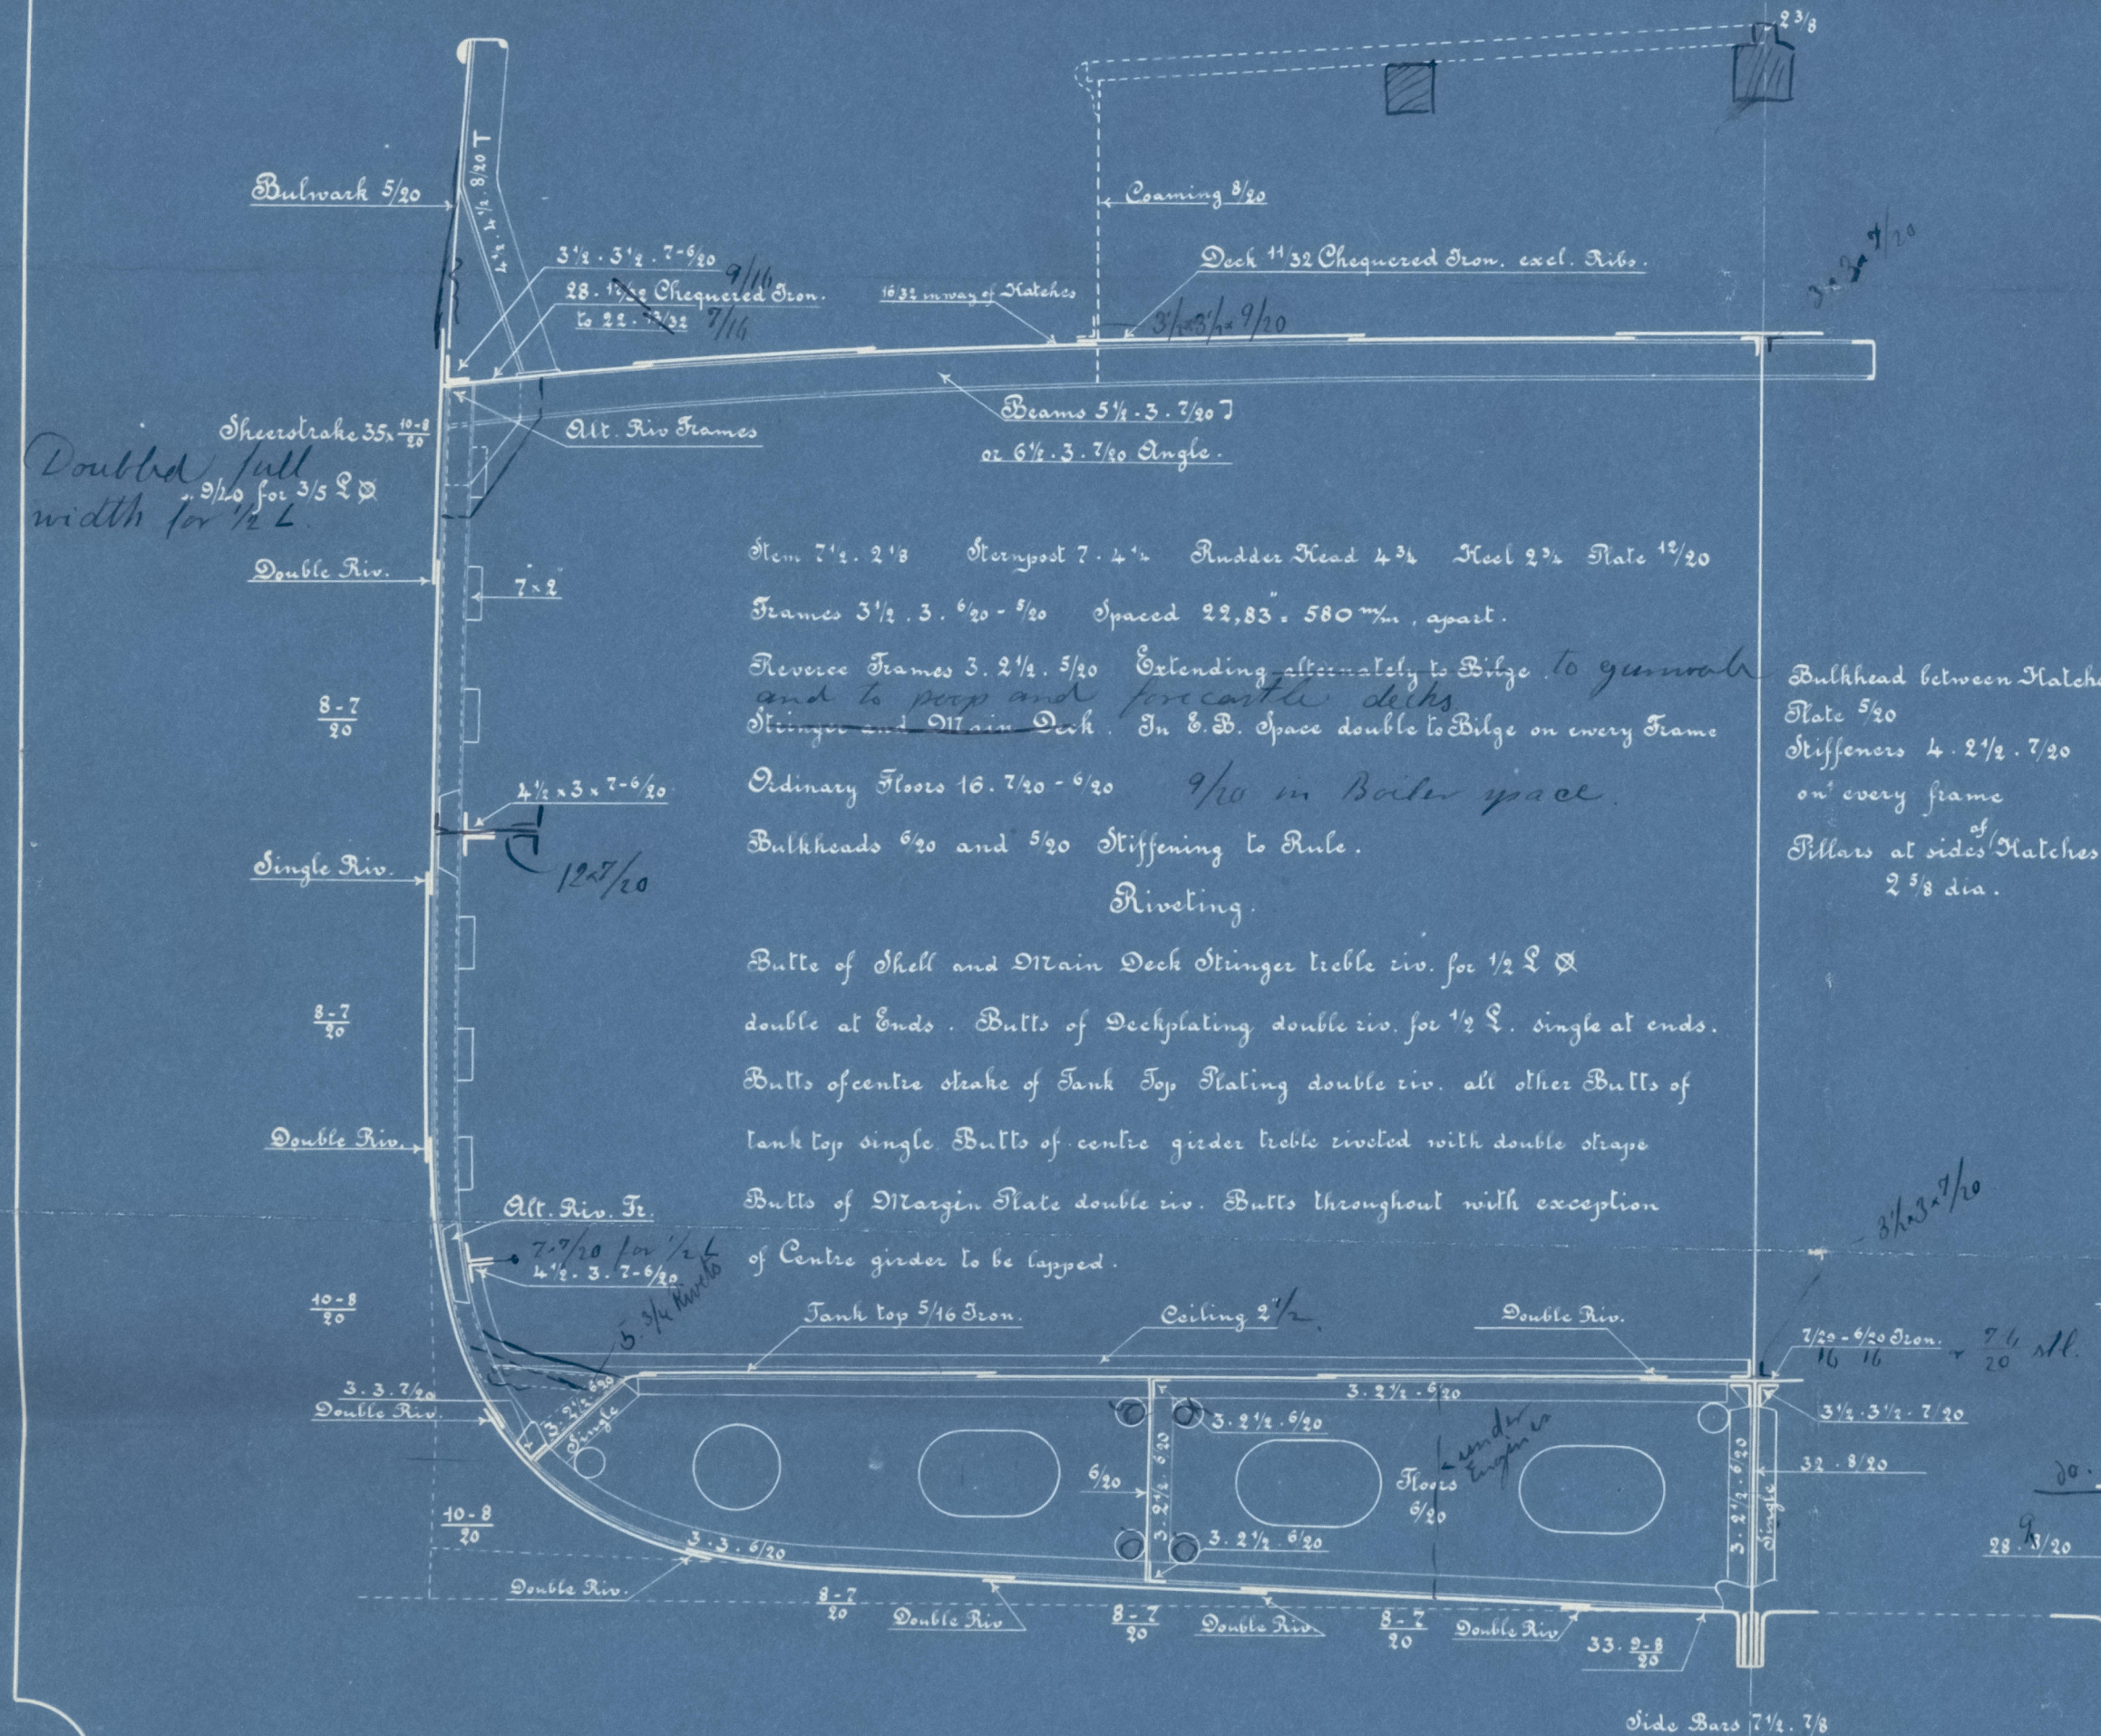

Section thro Boiler Space.

Sections	
Boop 54.0' long.	9. 10 Right.
Forecastle 68.0' long	9. 10 "
Equipment	
2nd No.	10998
1/8. 13.75 x 115/193.56	837
Equipment No.	
3 Busses collective weight 28 cwt	Stockless. 54 1/4
1 Steam.	2 1/2 ex. Stock. 5 1/4
1 Ridge.	2 1/2 "
240 faths 1 1/2 stud chain cable.	"
75 "	1 1/2 steam chain
90 1/2 "	9 5/4 lowline Steam
90 "	6" Hammer "
90 "	5 1/2 wavy "

Height of Engine Seat

Rev. St. Doubled to Bilge

Floors in Boiler Space 16. 8/20

" " Engine 7/20

11 2/10

4 1/2 x 3 1/2

All Keelson & Stringer Bars 4 1/2. 3. 7-6/20

Copy of Plan
approved 11/1/99.


STN 1152-0015 1/2

S.S. U. 500
Midship - Section.
Scale 1/25


Length (Lloyd's) 193' - 6 1/2"
Breadth moulded 30' - 2"
Depth moulded 14' - 1 1/4"
Draft to top of keel 12' - 0"

Class 100 A1 * A+C.F. Lloyd's Register.
and 100 A(E)L. Germ. Lloyd.

1/2 Breadth 15.09
1/2 Depth 24.00
Depth 14.73
1st Number 56.82 x 193.56
2nd Number 10998
1/8 = 6.42 1/16 = 13.12

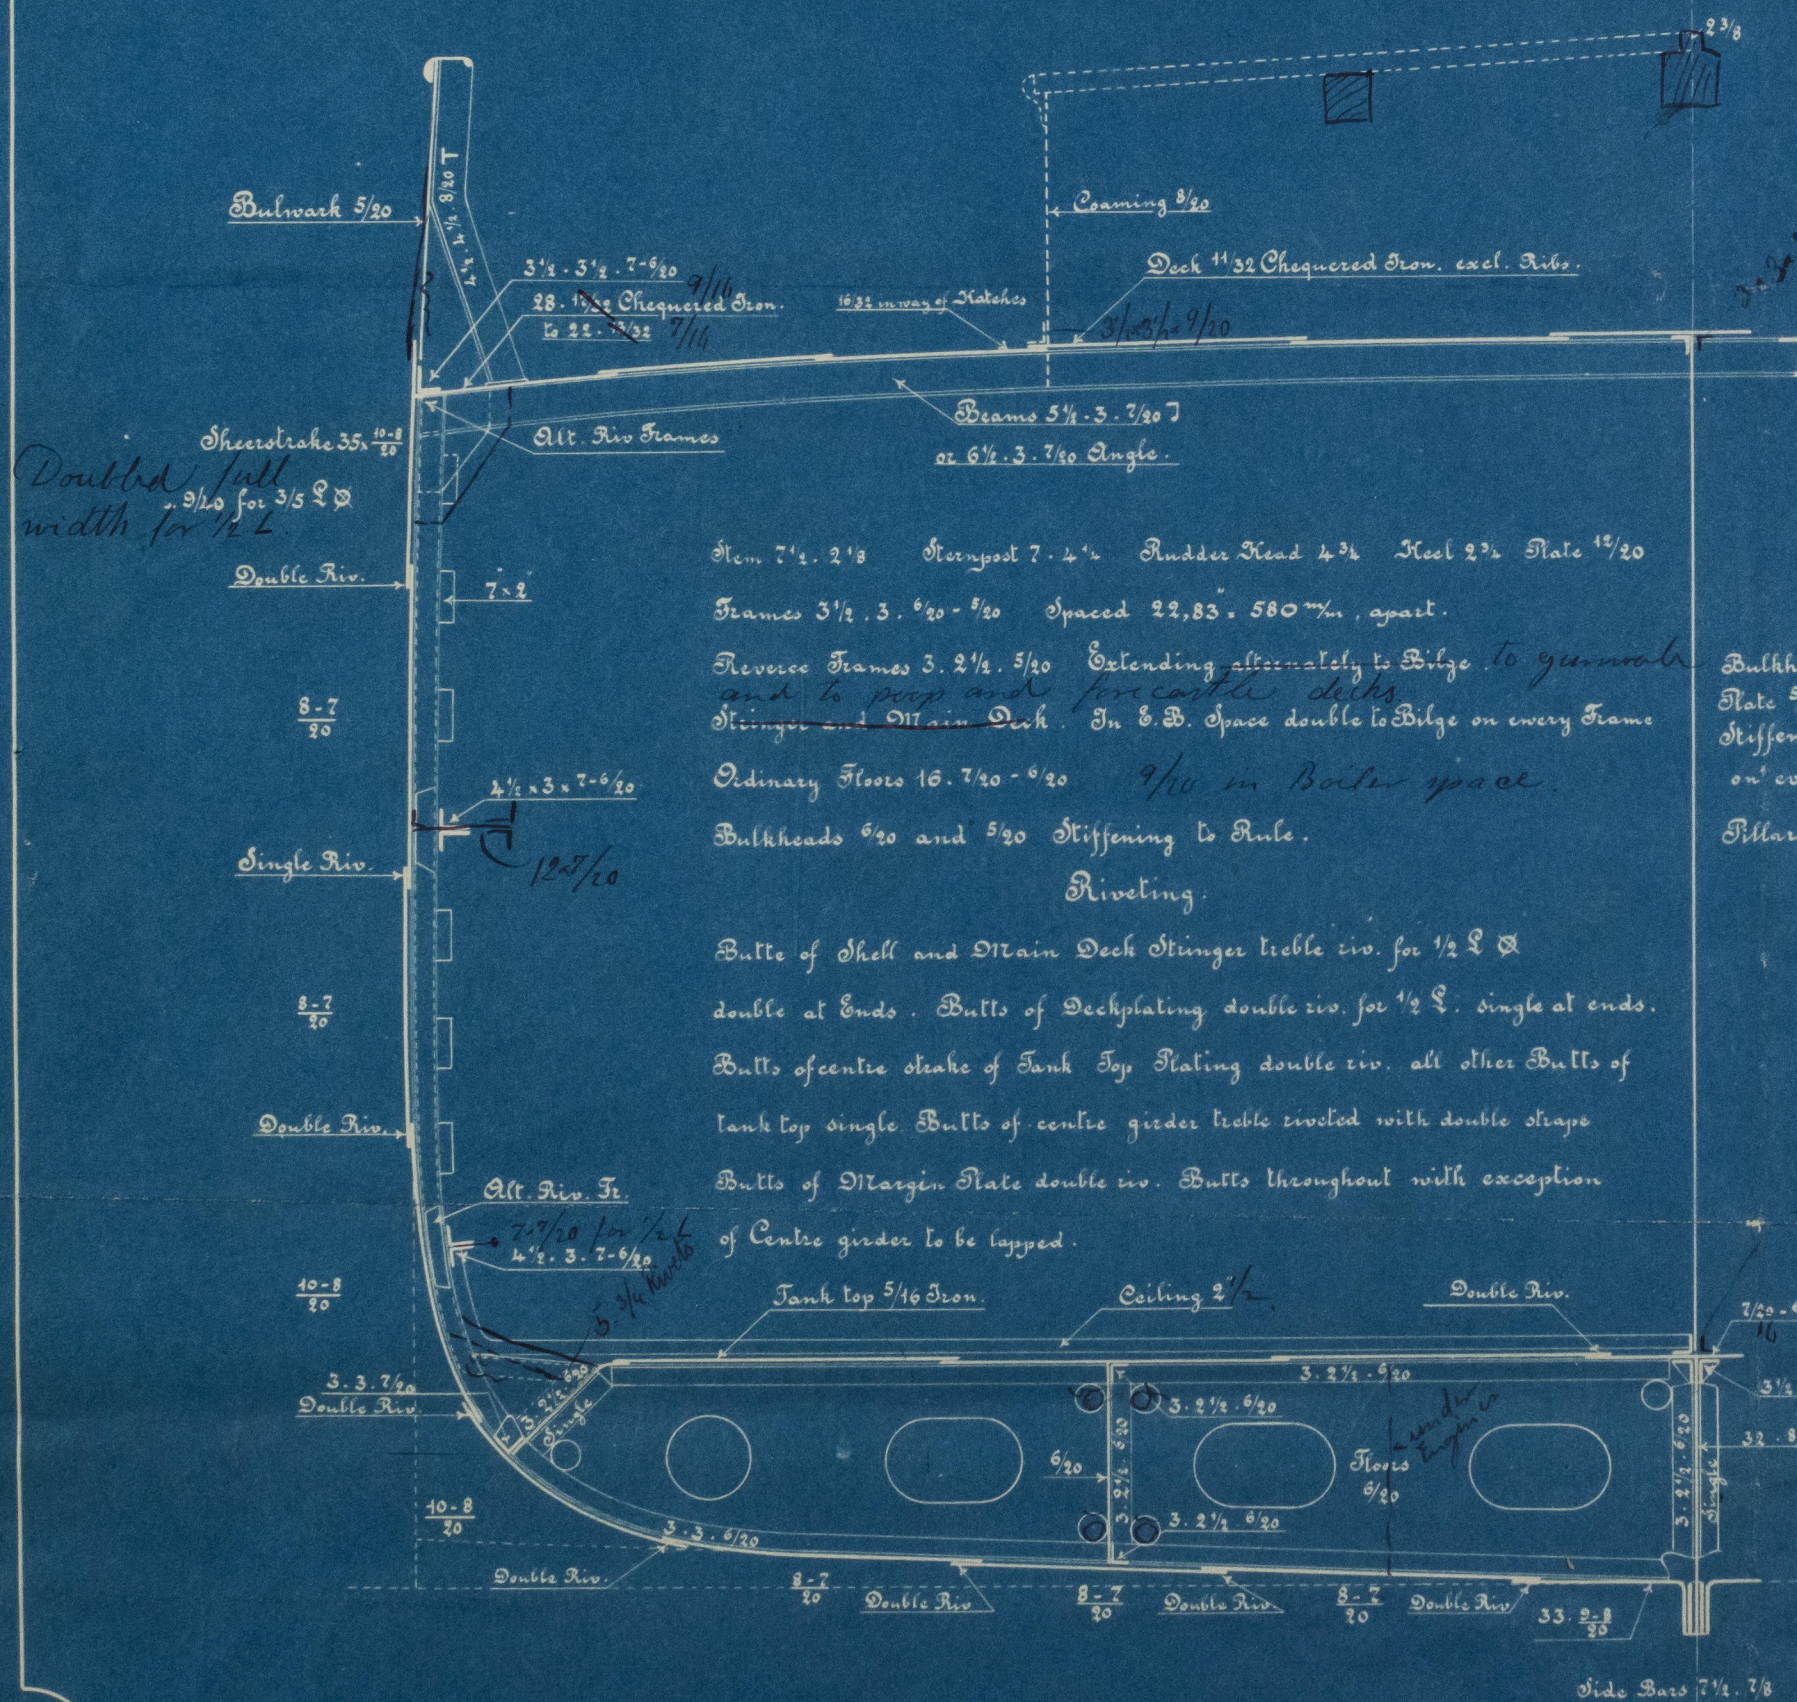

Section thro Boiler Space.

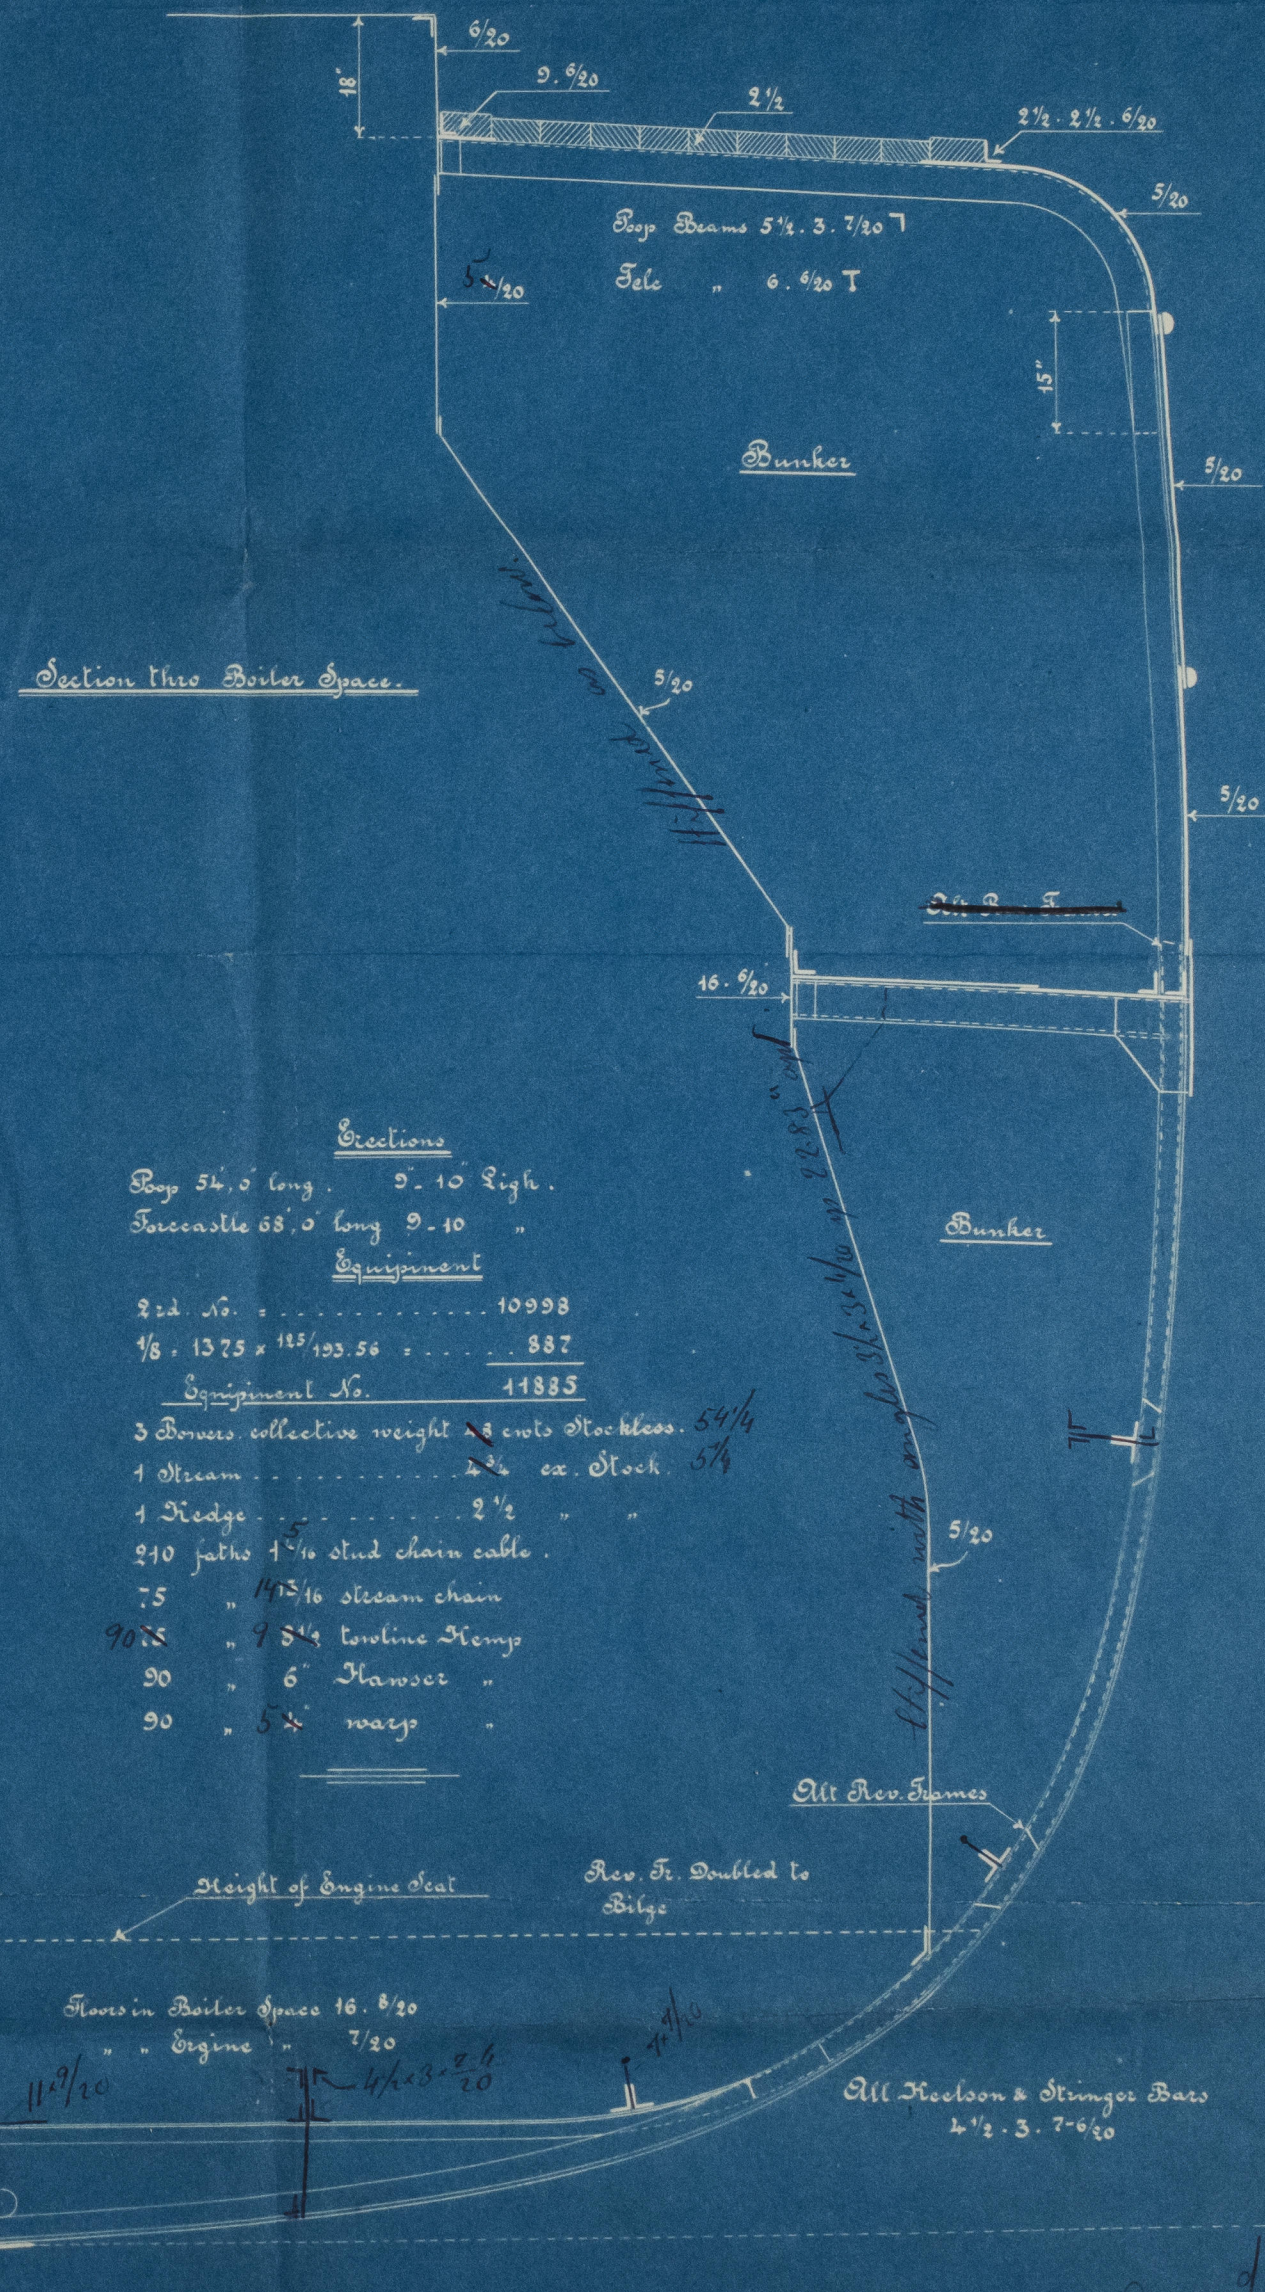

Sections
Boys 54' long. 5' - 10' High.
Forecastle 68' long 9' - 10' "
Equipment
2nd No. 10998
1/8 = 13.75 x 193.56 = 887
Equipment No. 11885
3 Bows, collective weight 28 cwt. Stockless. 54 1/4
1 Steam 2 1/2 ex. Stock. 5 1/4
1 Hedge 2 1/2 "
240 faths 1 1/4 stud chain cable.
75 " 1 1/2 1/16 steam chain
90 " 7 5/8 towing steam
90 " 6" Hawser "
90 " 5 1/2 warp "

Copy of Plan
approved 11/1/99.



Midship Section


S.L. "Imil Berenz
Stn 47.

STN1152-0015 $\frac{1}{2}$




© 2021

Lloyd's Register
Foundation

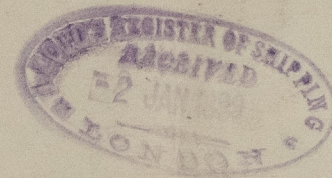

'Ank. 5. 1. 99)

Antw.

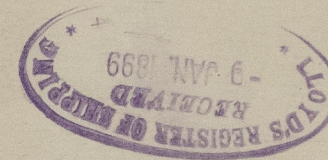

0015

