

S/S. Ressie

Vol. Rept. 170


5.9.
Middup Seeloa. Profile &c



© 2018

Lloyd's Register
Foundation

5.9.91

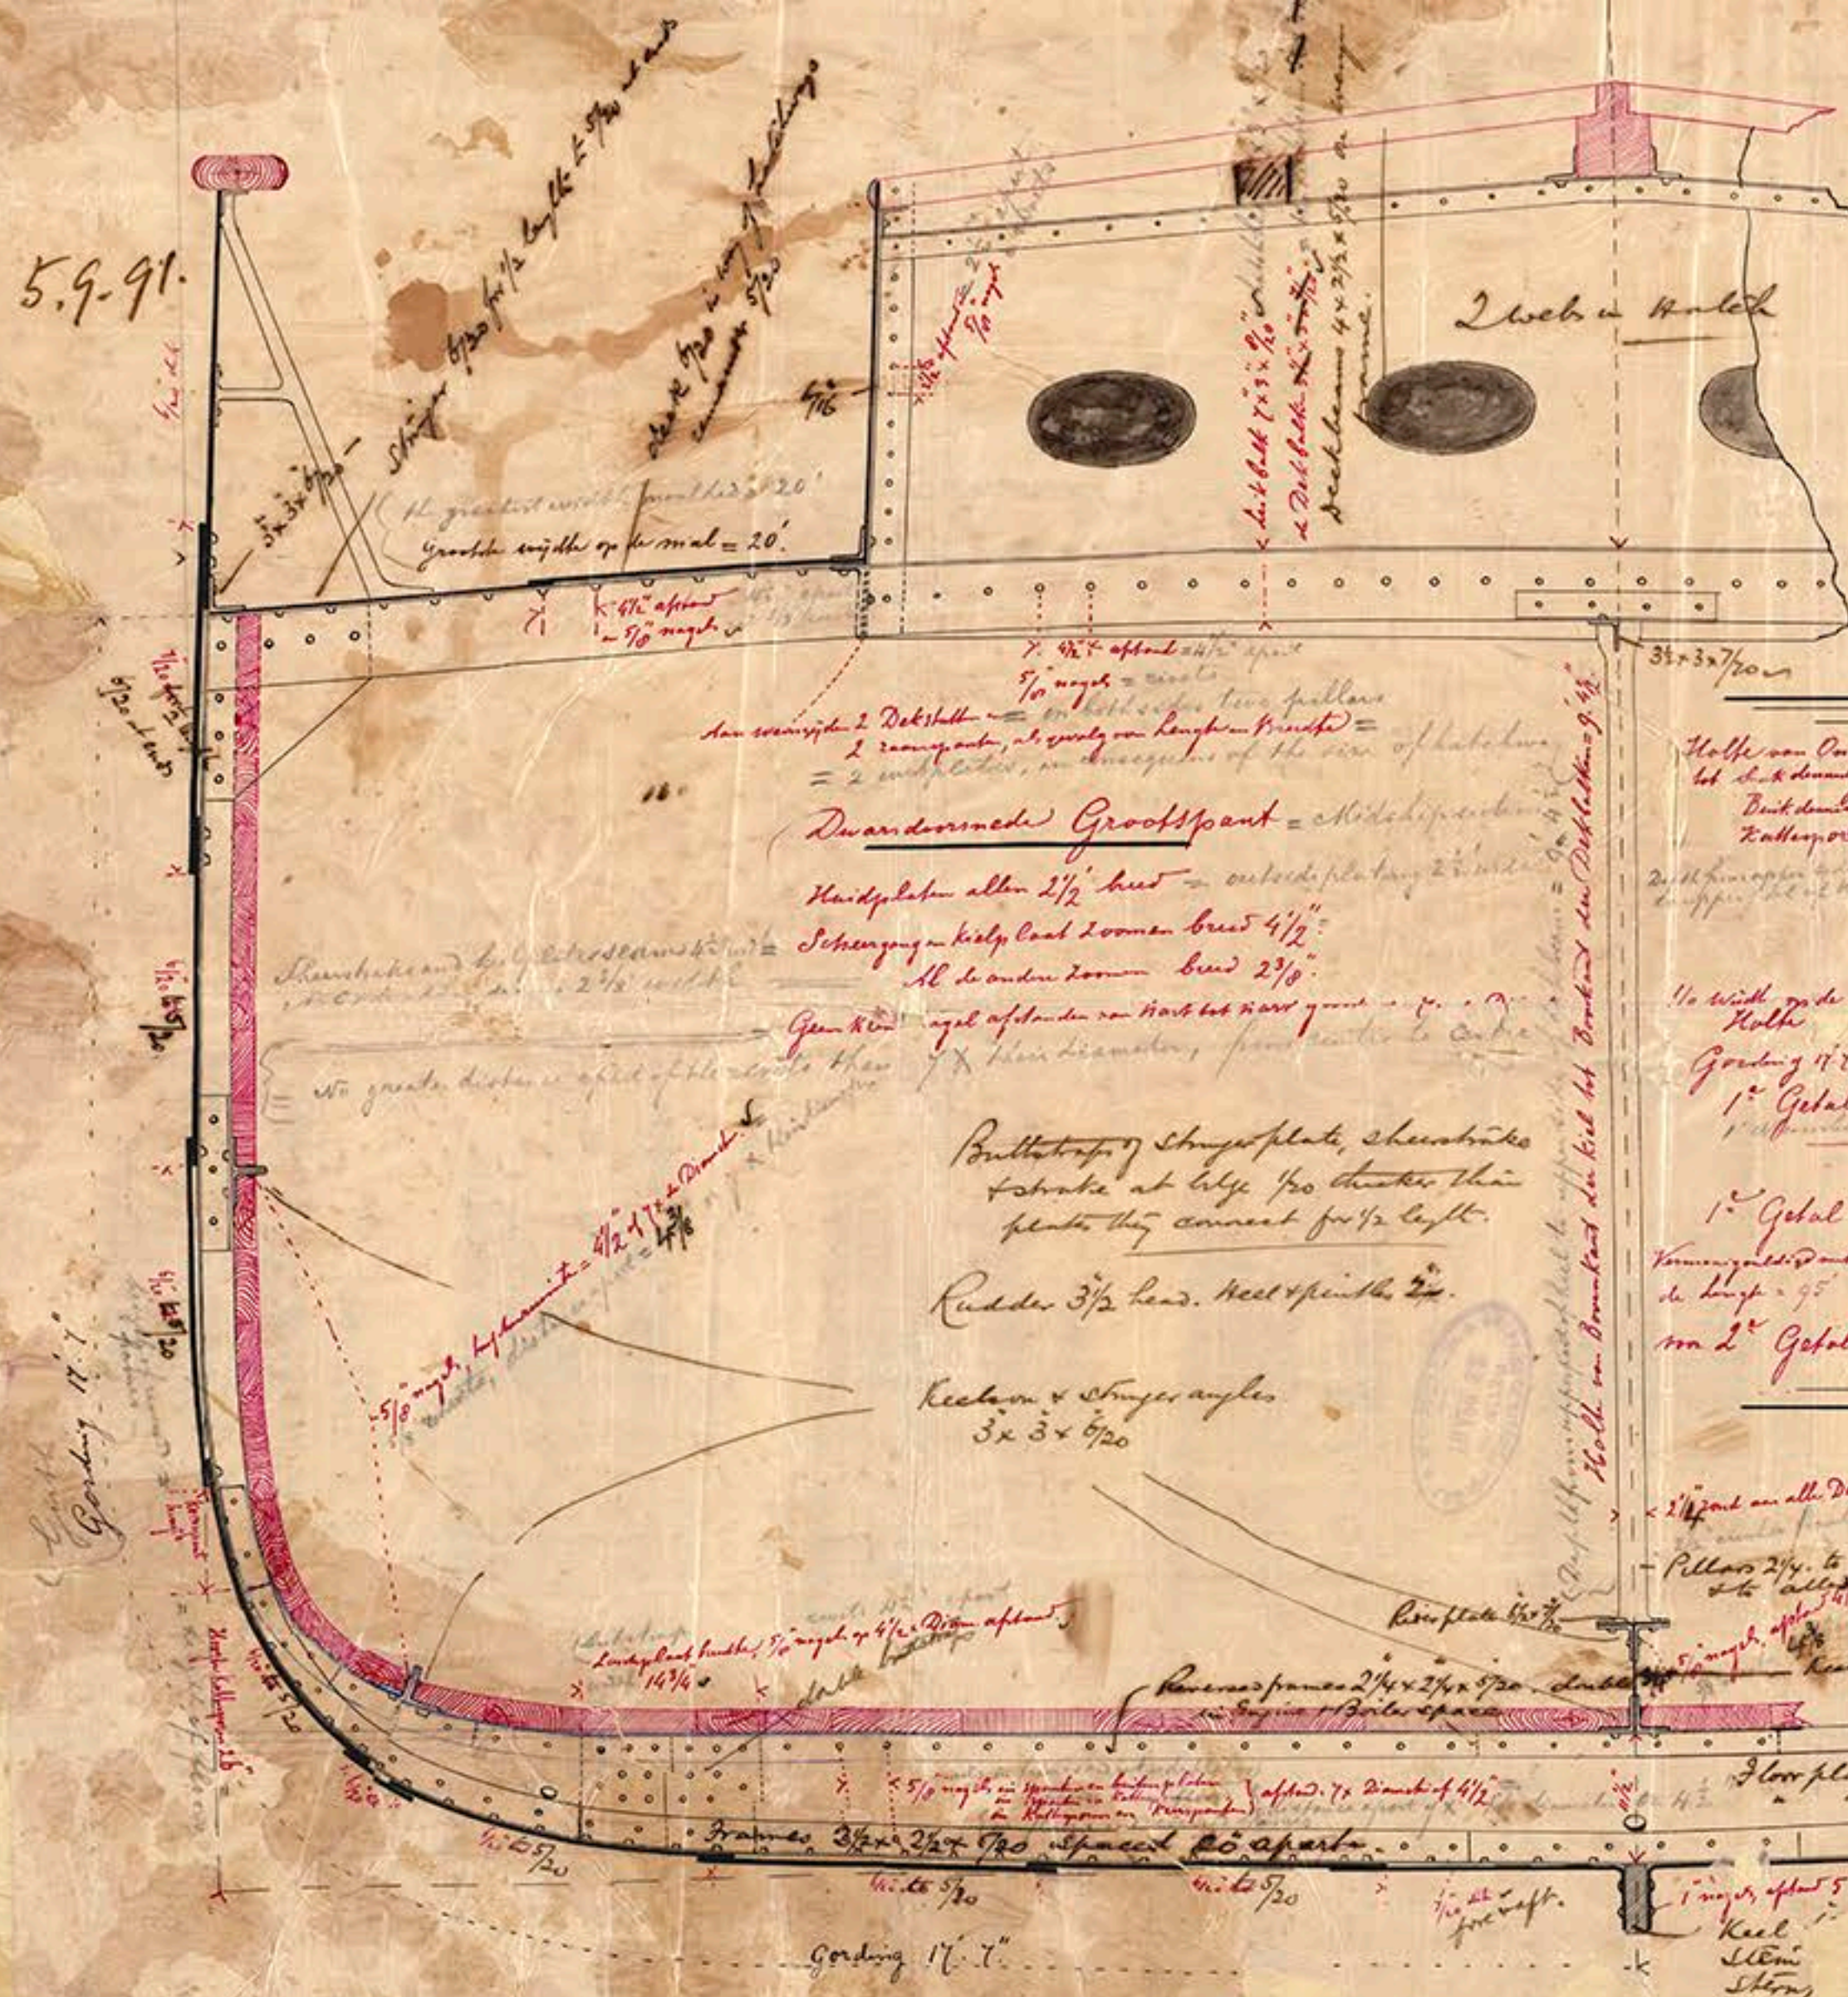


1/10 Scale




1. 12.

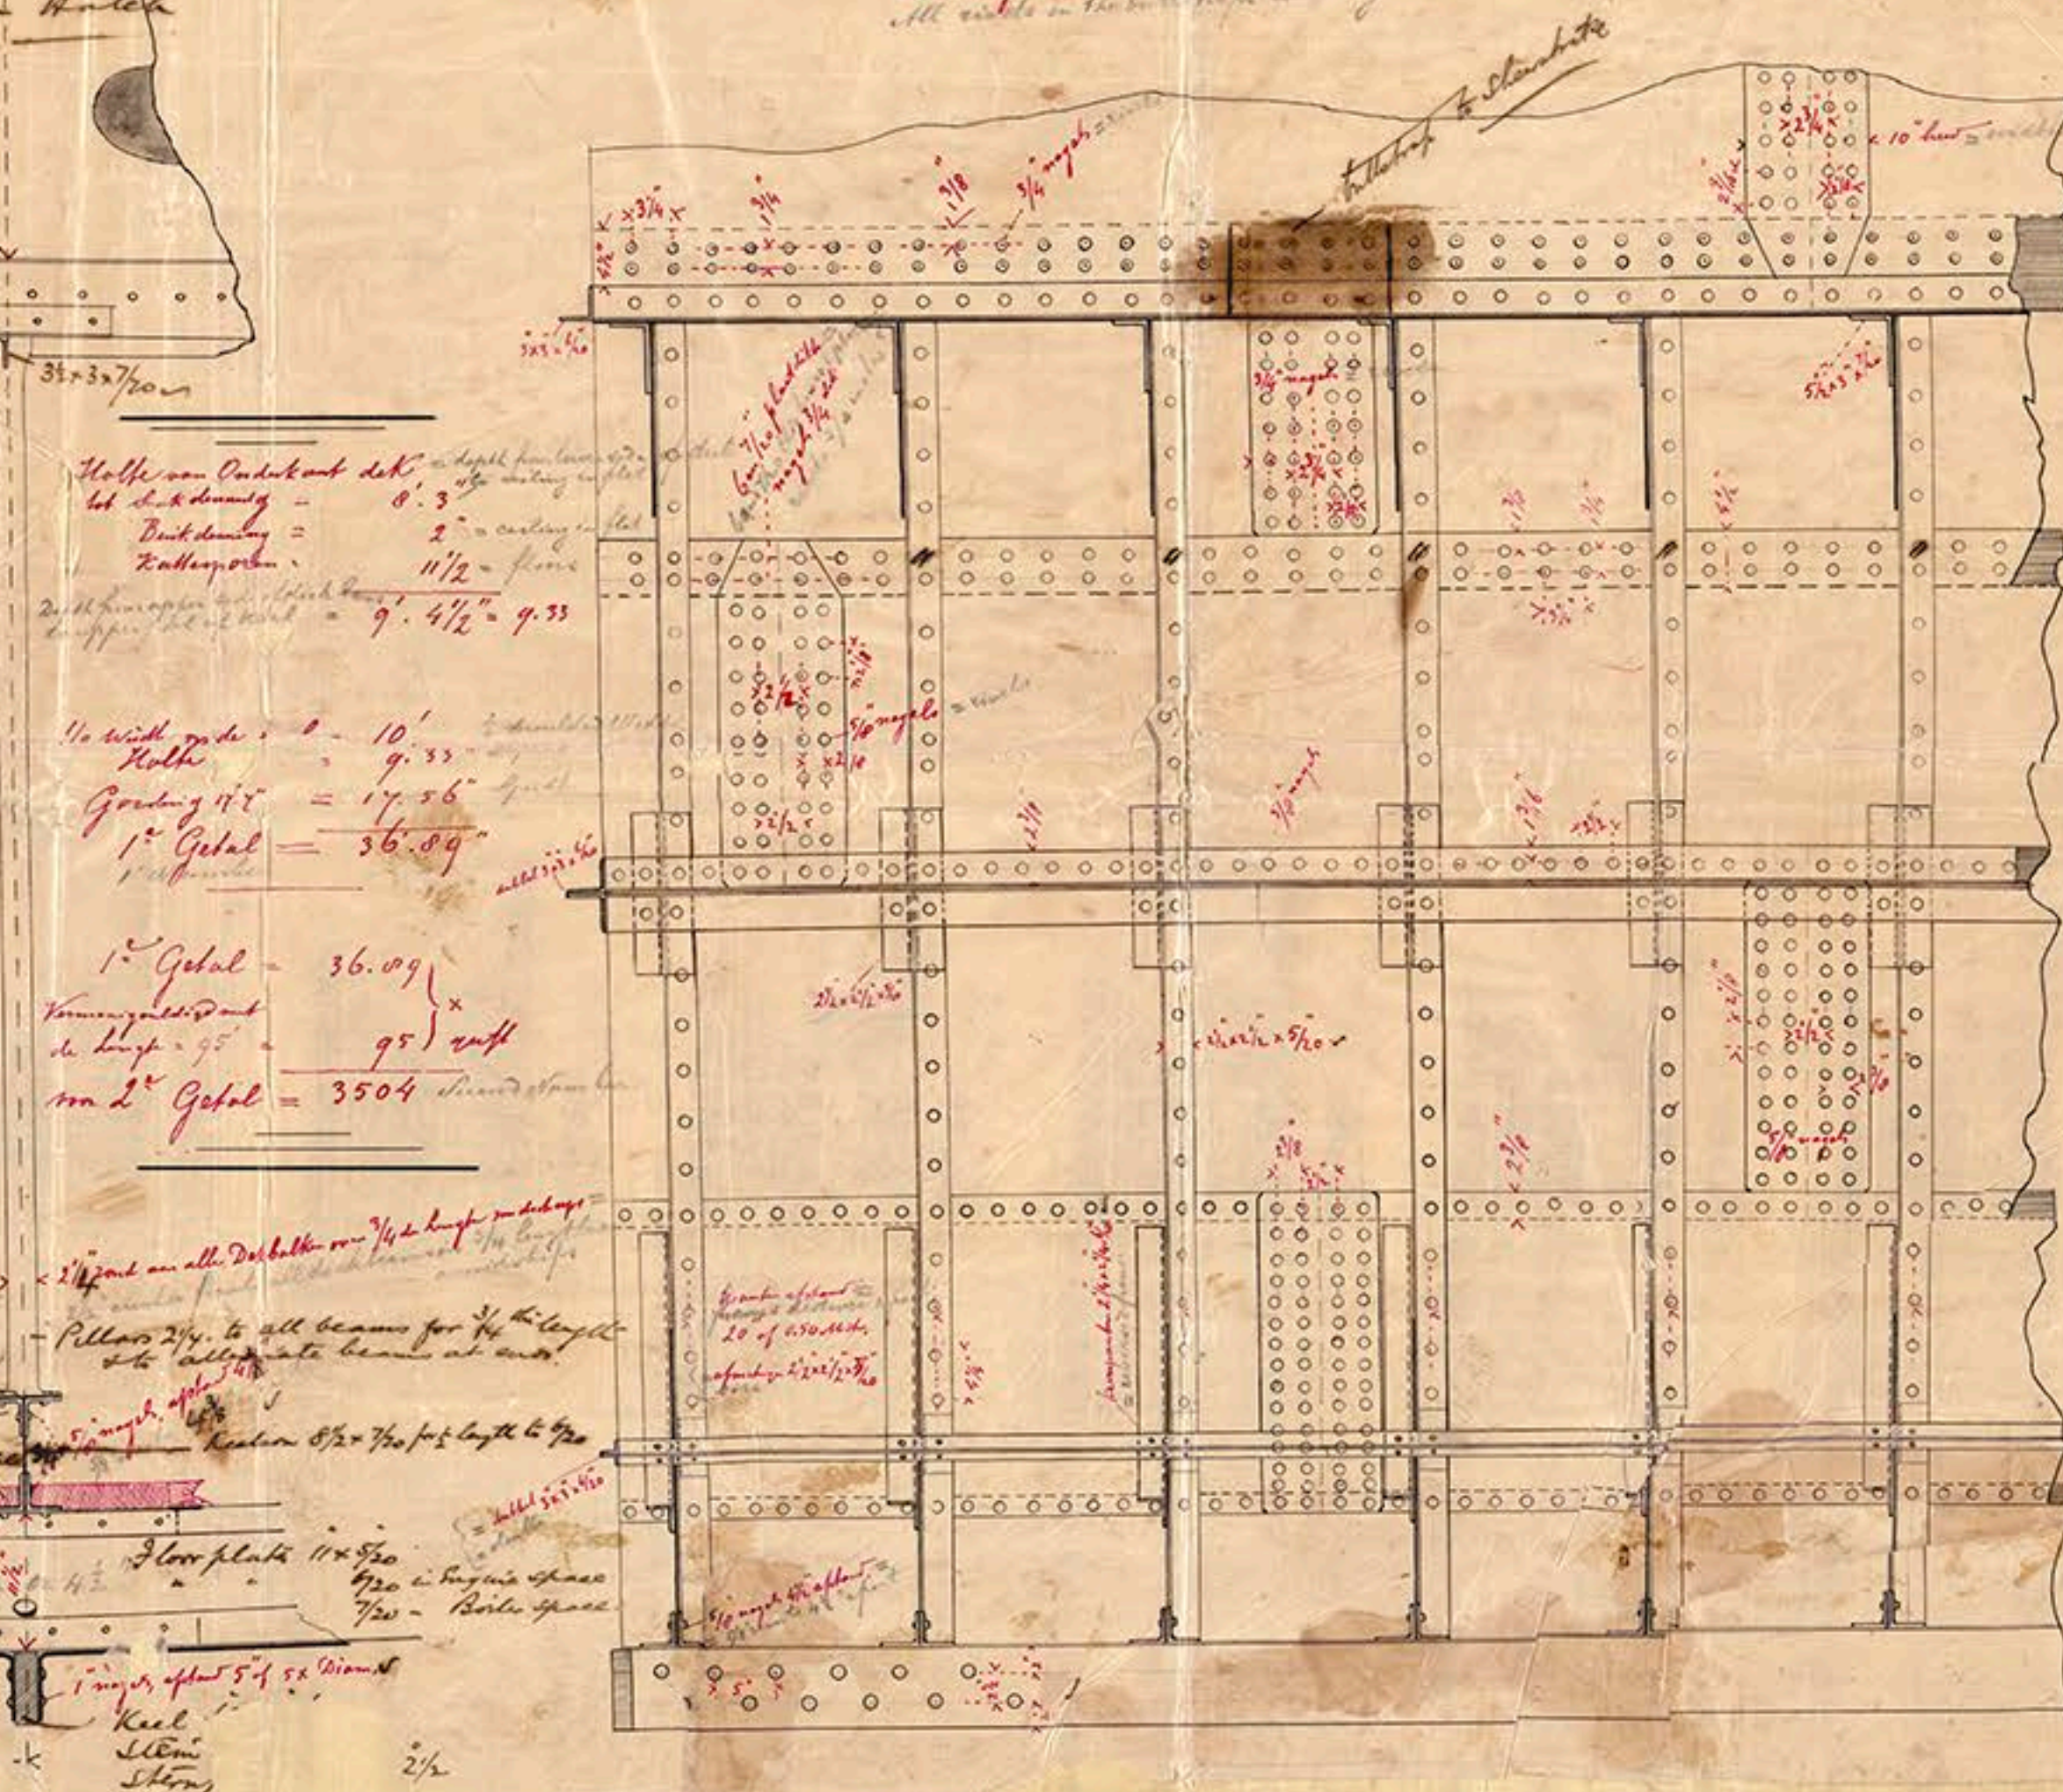

Stalen *Steel*
Goederen Stoomschip. = Cargo Steamer

Long 95 vollen. - Length 95
 Bread 20 - width 20
 depth = 40 8 - 3 diam. 8 ft 3 in
 { 9 querson class 100 A 1
Longueurs de classe 700 A 5.

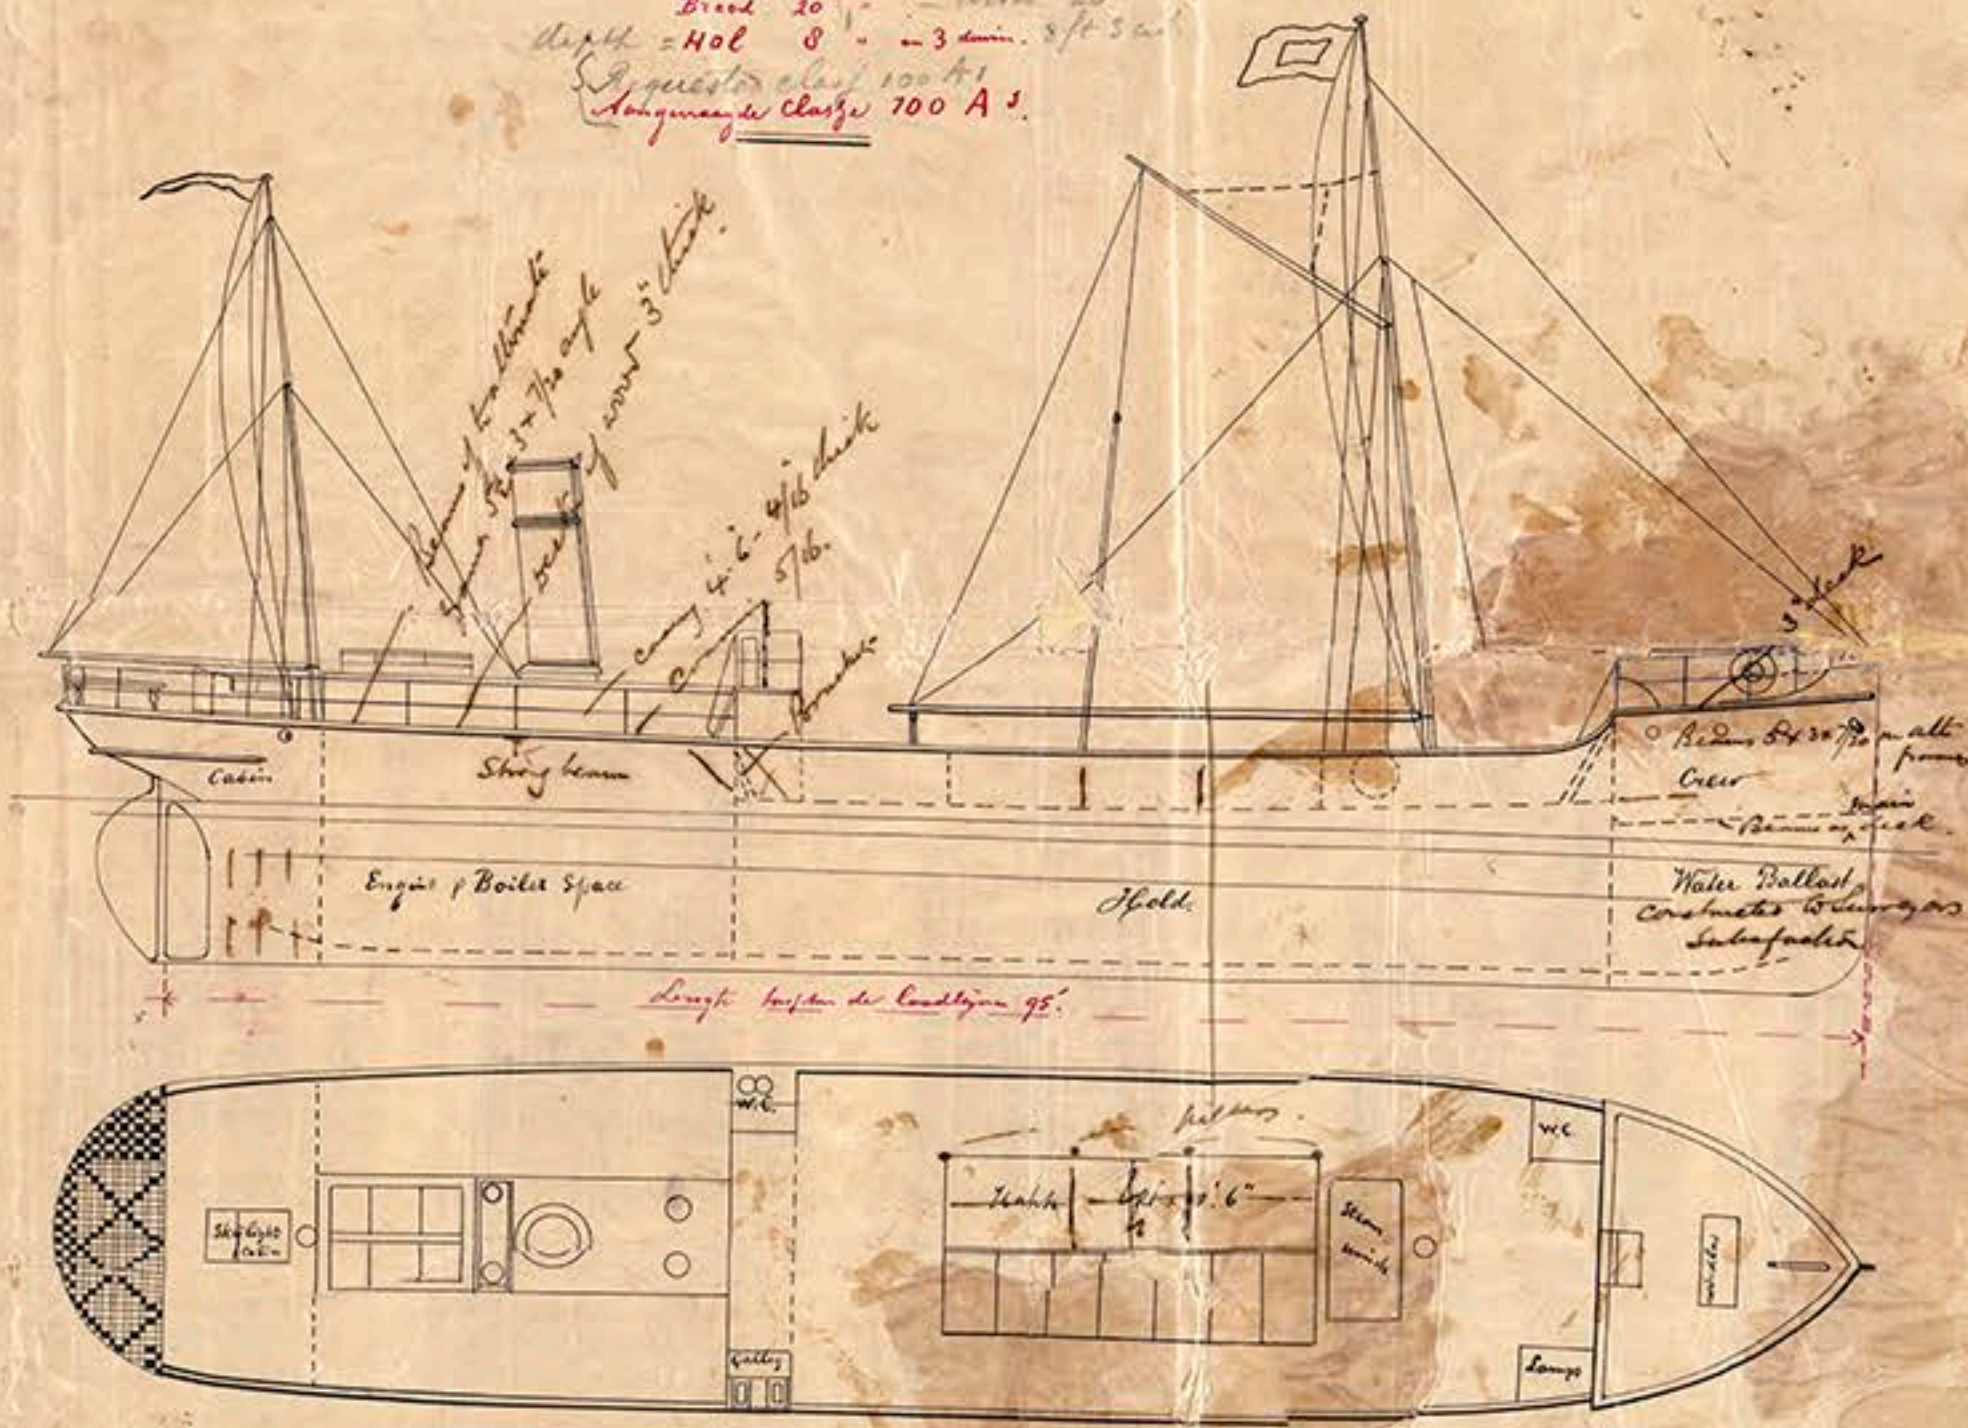

bureau. Visitation 25 Sept. 1891
J. Mulder

 delivered by
 L. H. Jackson
 5/9/91.