








S/S *Bessie*

Vol. 170

For Peak Lark

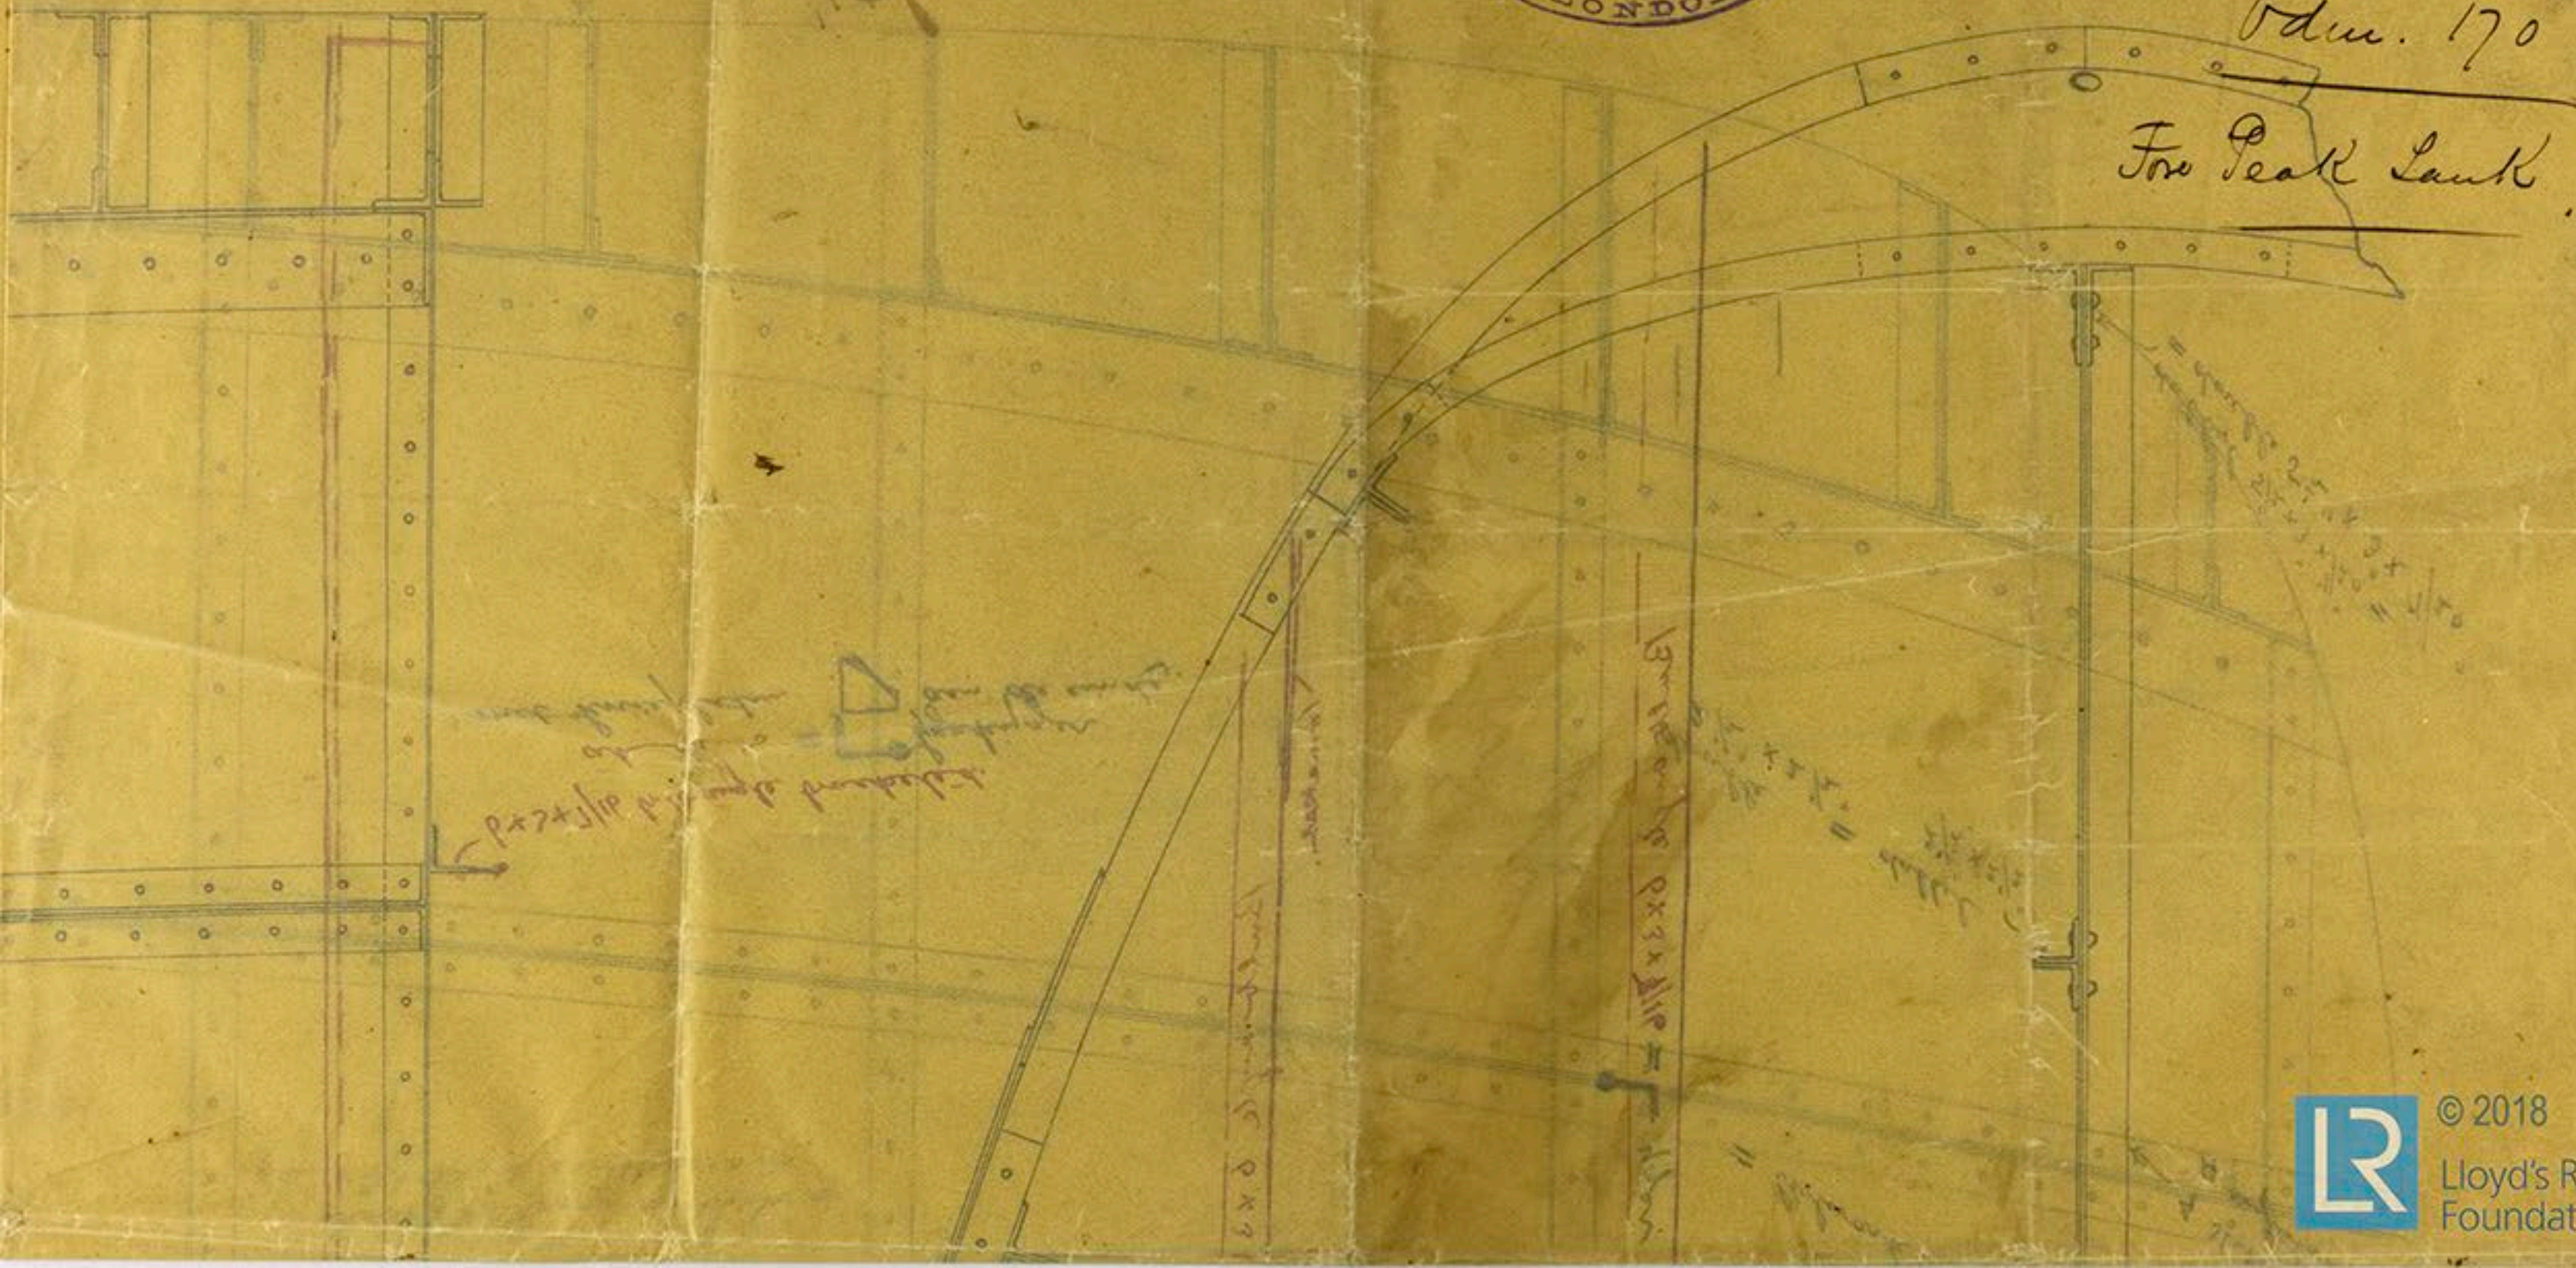

© 2018

Lloyd's Register  
Foundation