




See Ltr to Mfrs:  
*R. Craggs & Sons*  
 15. 12. 93.

N<sup>o</sup> = 90 built by Maulder.

"Rio Ituxy"

Proposed scantling for Promenade deck


Scale  $\frac{3}{16}$

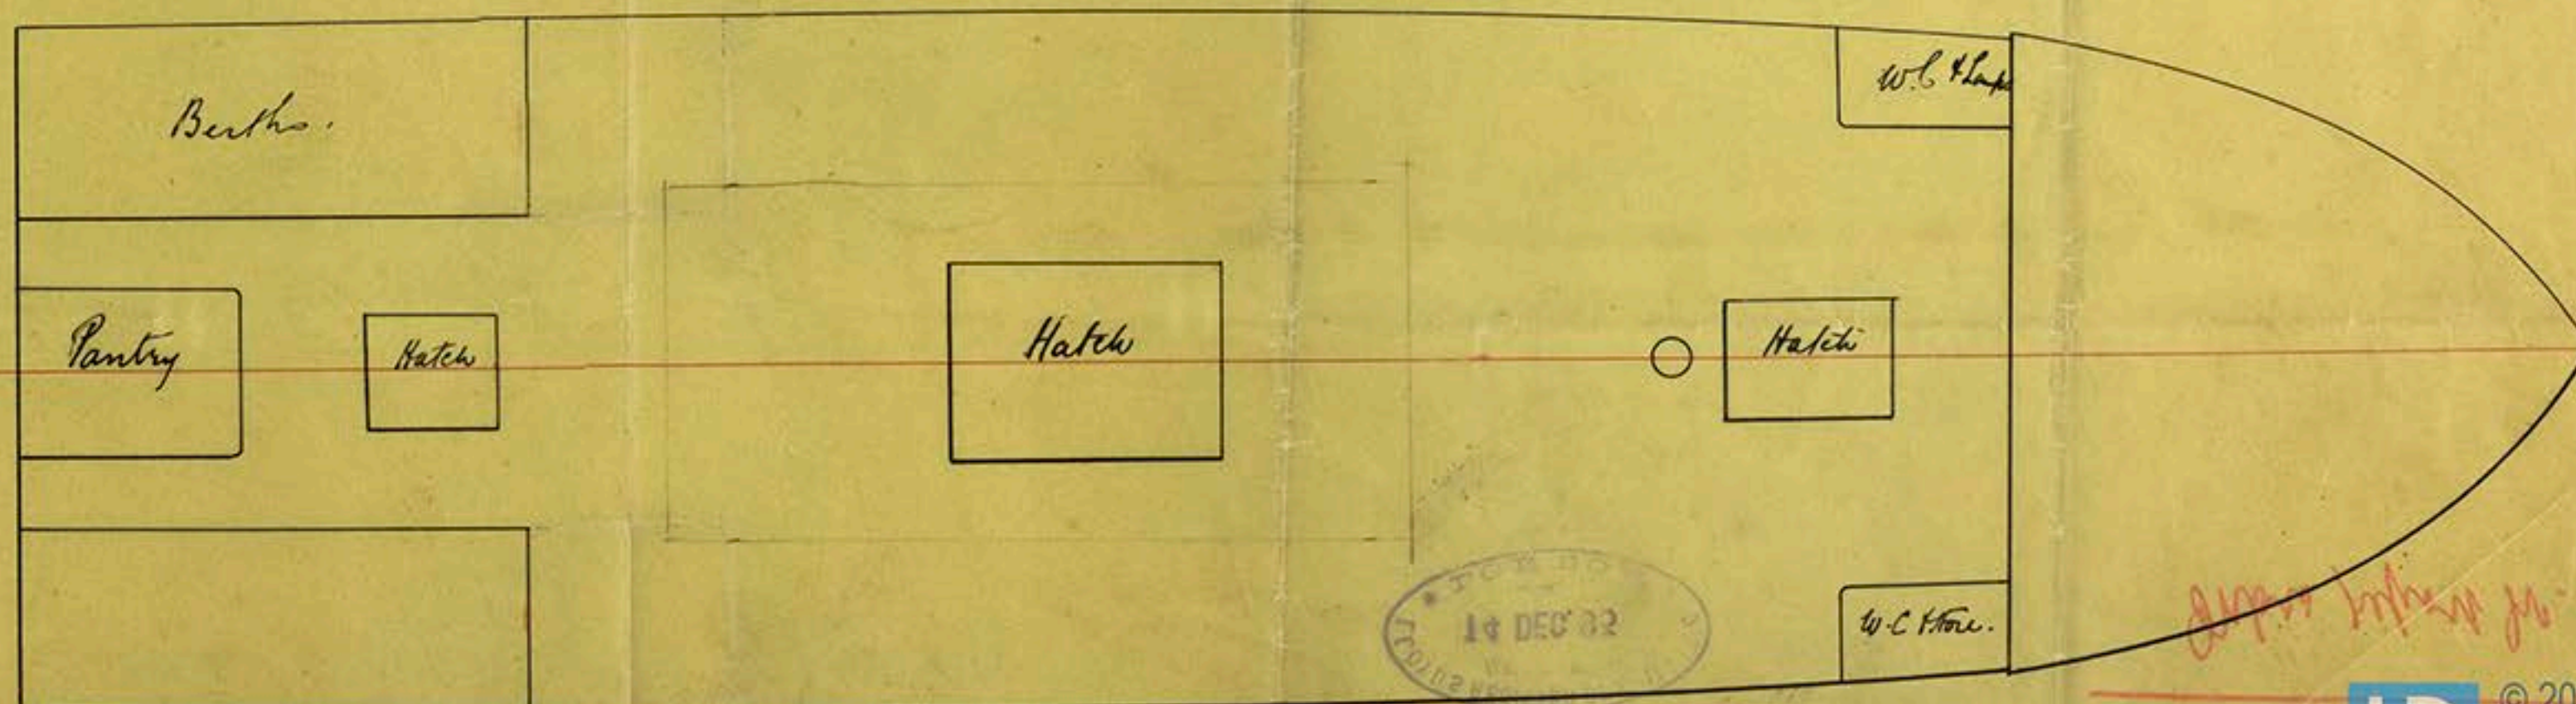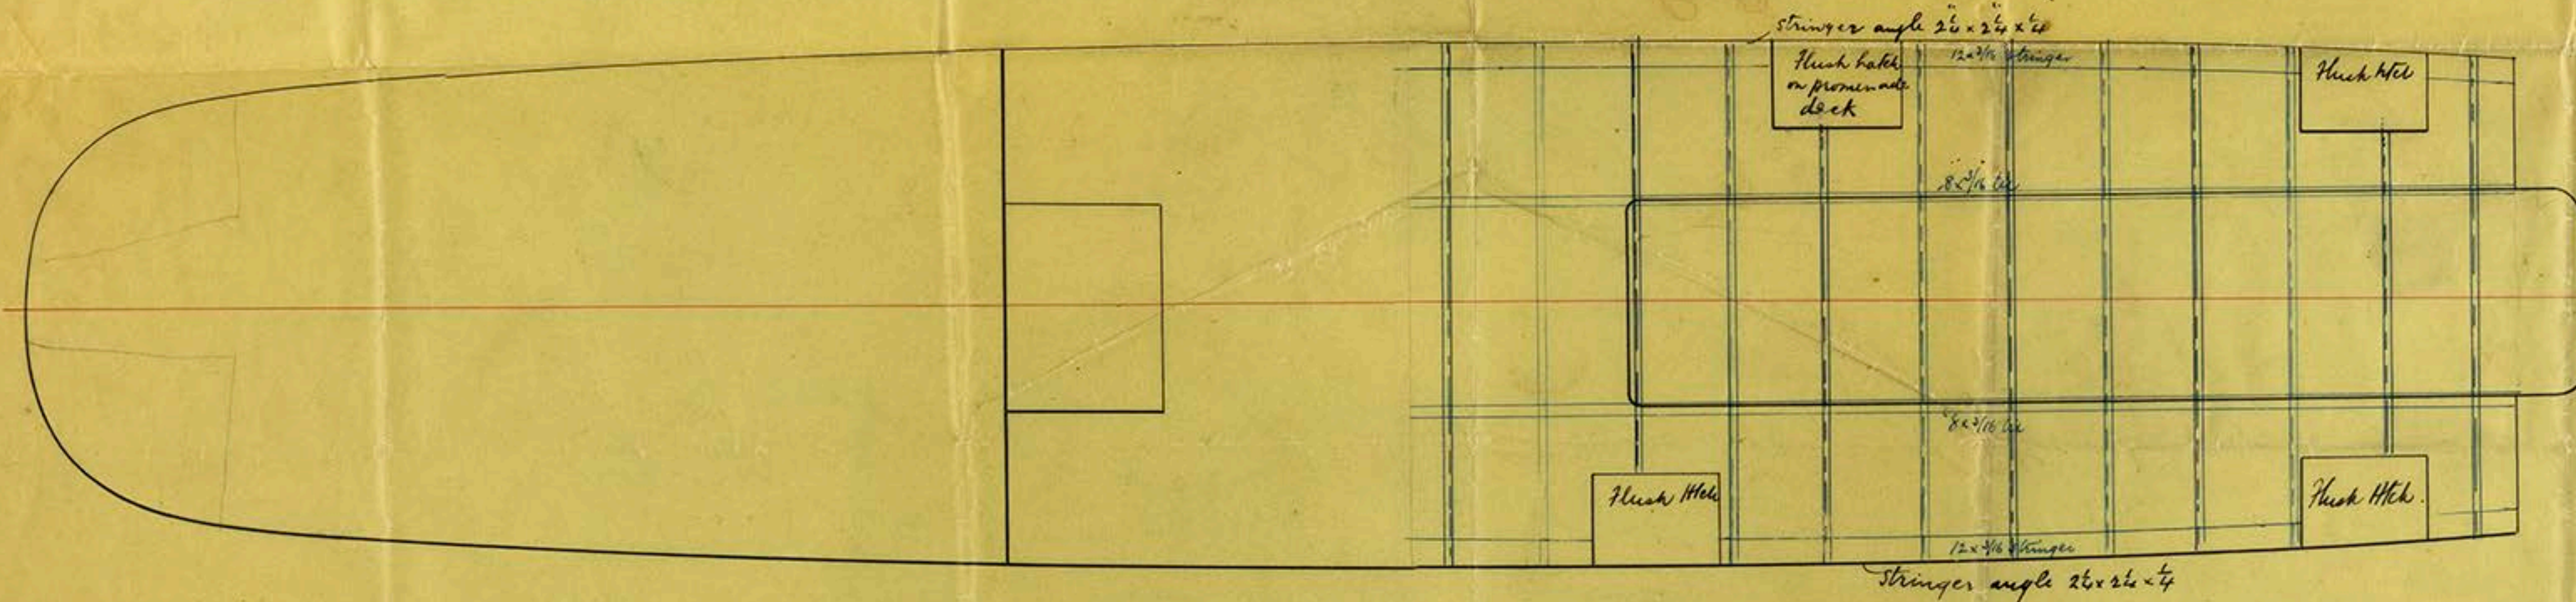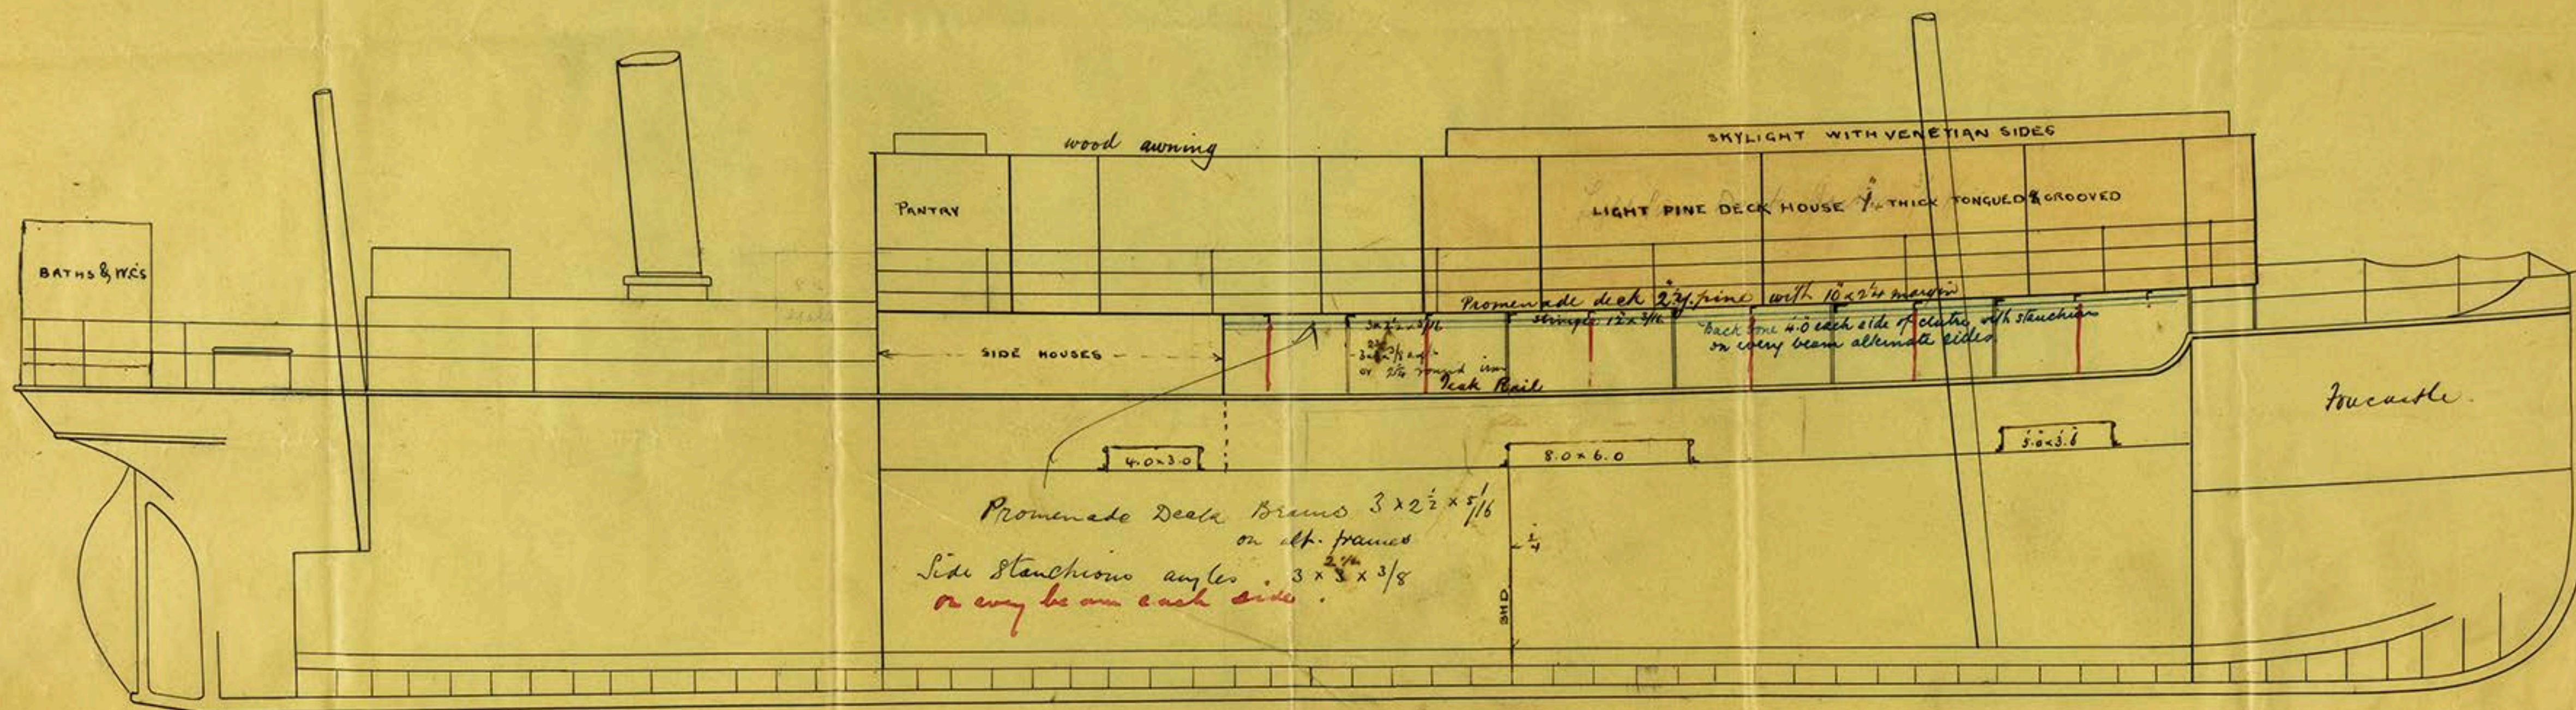



"Rio Itury" S.S.

Index report No. 1160

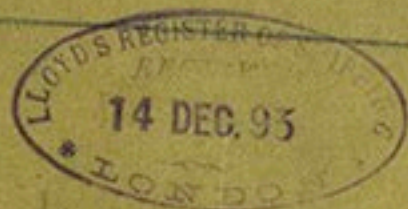

McKen







© 2018

Lloyd's Register  
Foundation