


6<sup>2</sup>  
New proposed  
plan


Scale  $\frac{1}{2}" = 1 \text{ foot}$

5' 0"

4' 6"

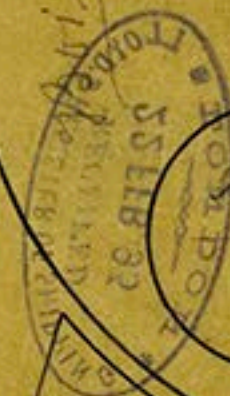

True place

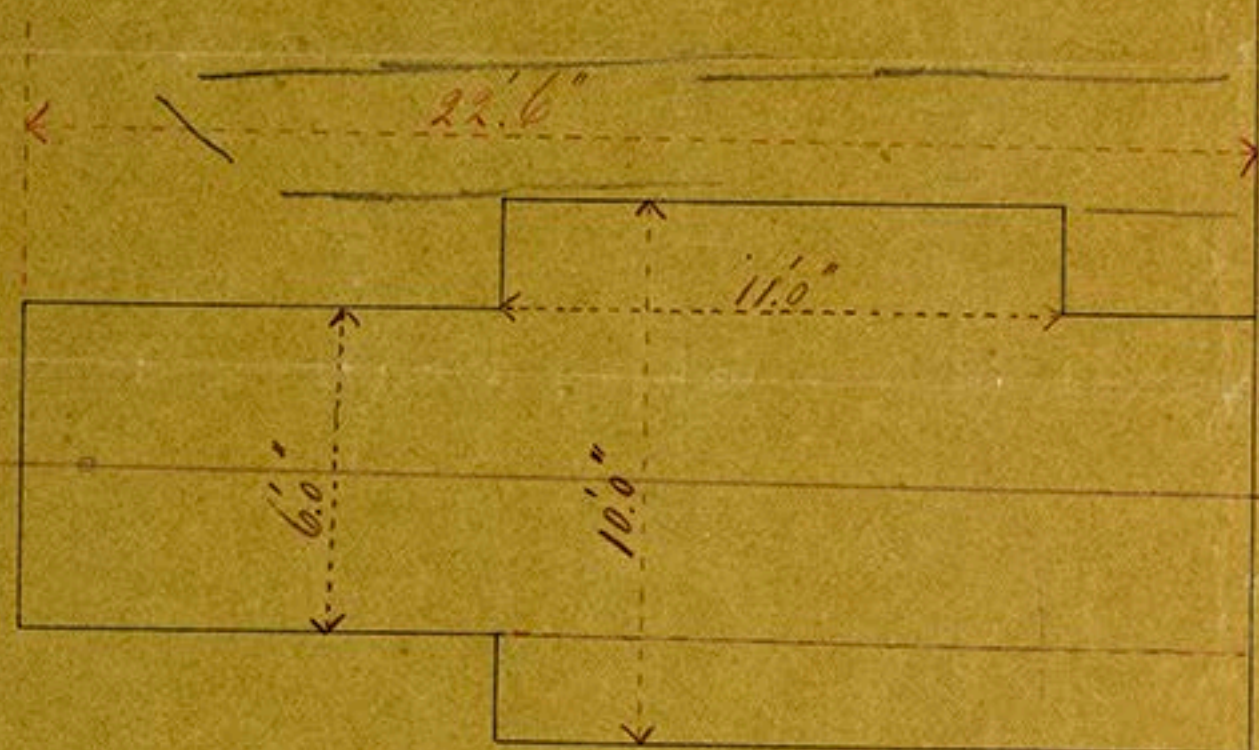

Scale  $\frac{1}{4}" = 1 \text{ foot}$



Approved modification by the  
Committee of Lloyd's Register




© 2018

Lloyd's Register  
Foundation



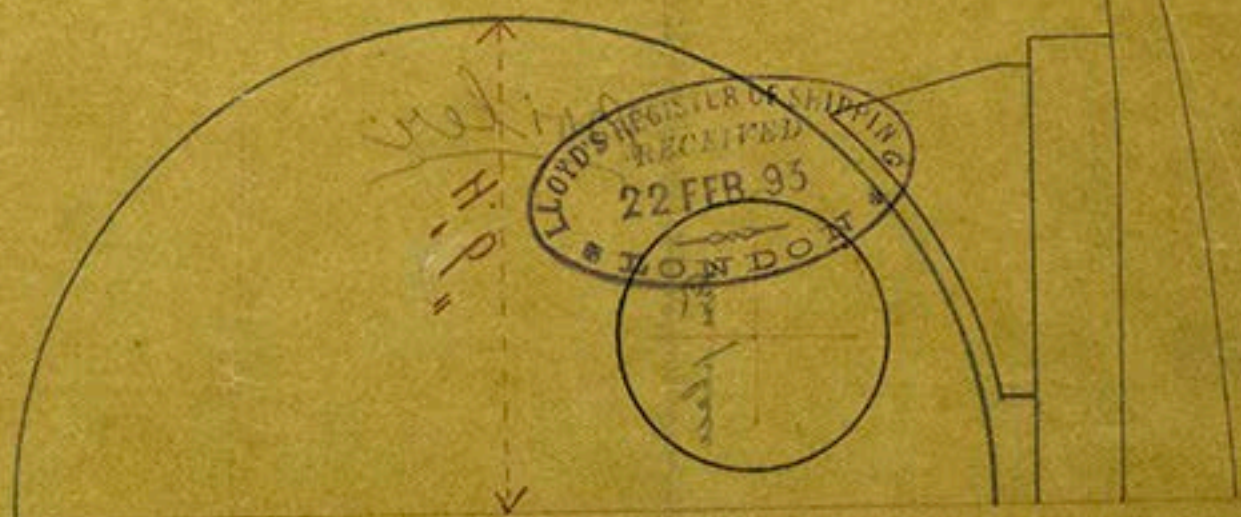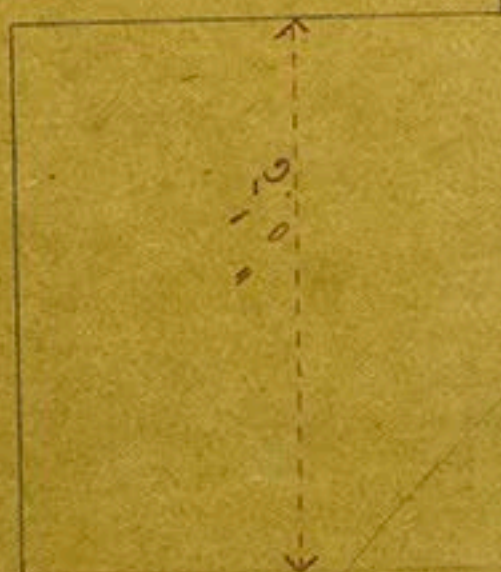


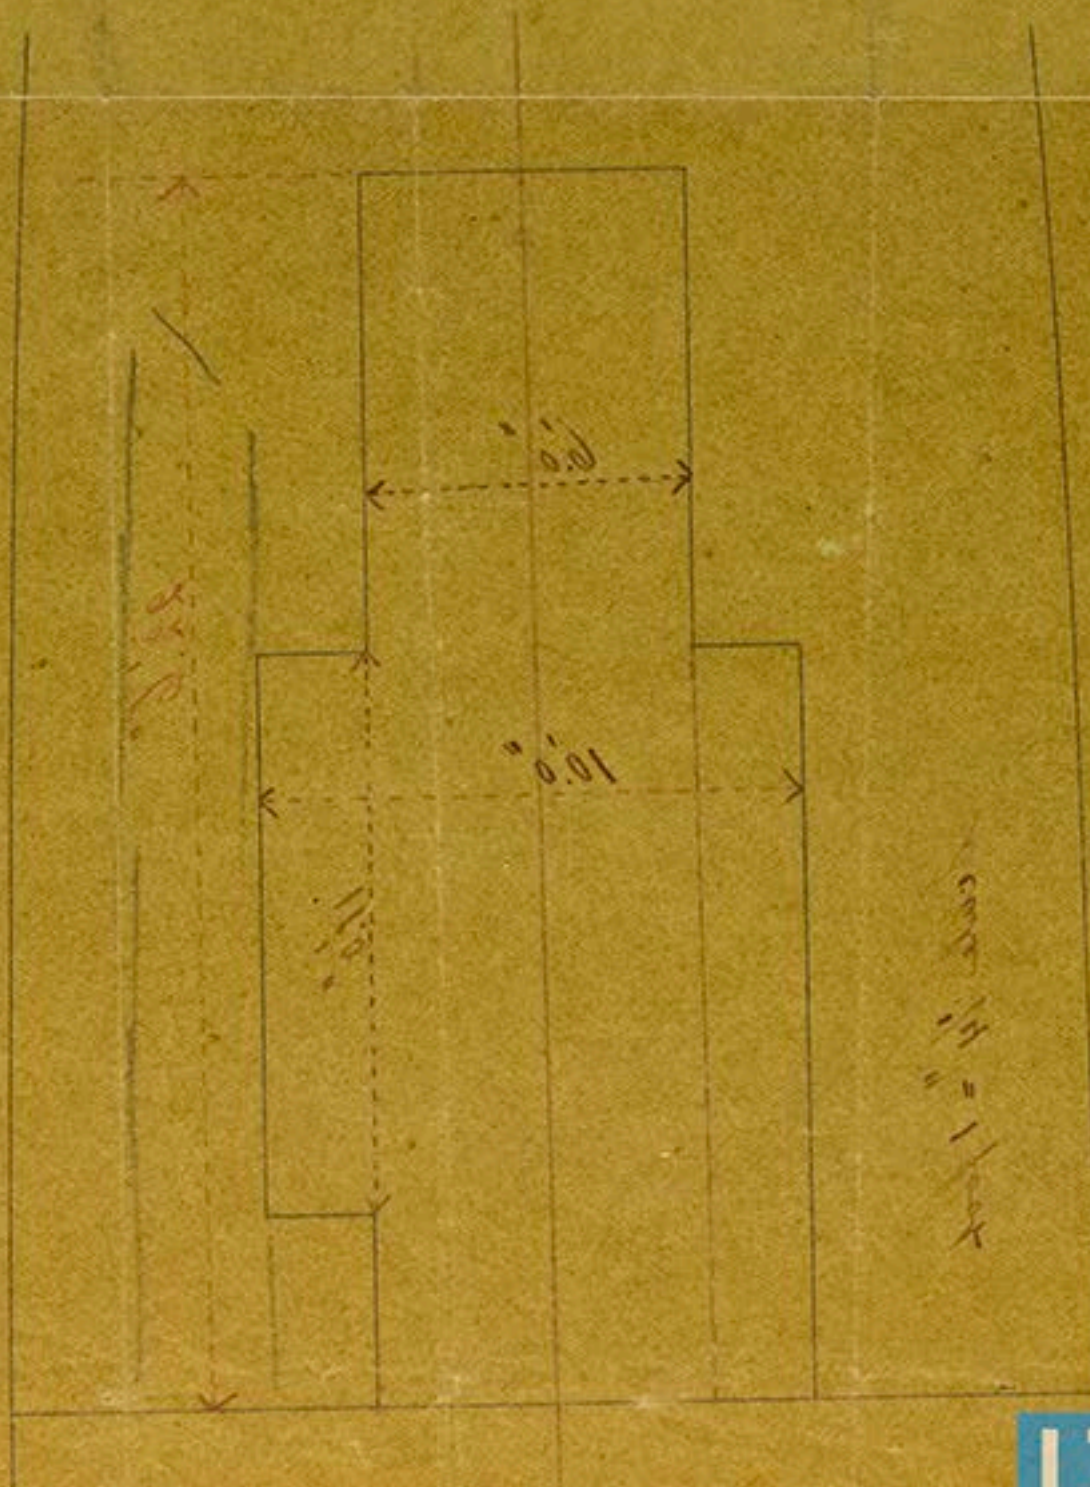


*Handwritten notes and signatures on the right side of the page.*

