



*A<sup>2</sup>*  
*New proposed plan*

*Proposed plan of casing. —*

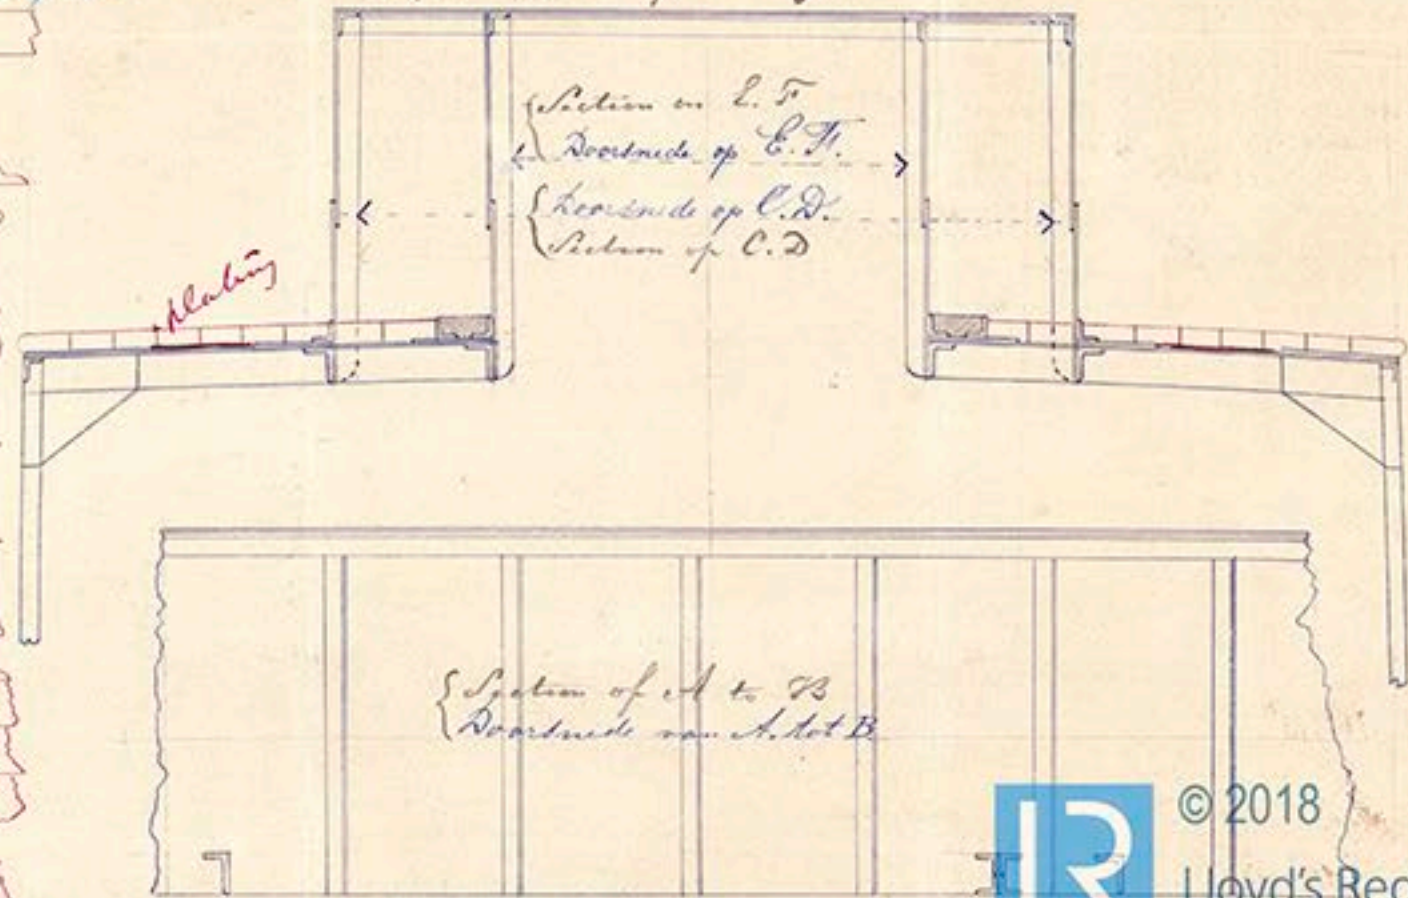

*Approved modification by the Committee of boiler opening*

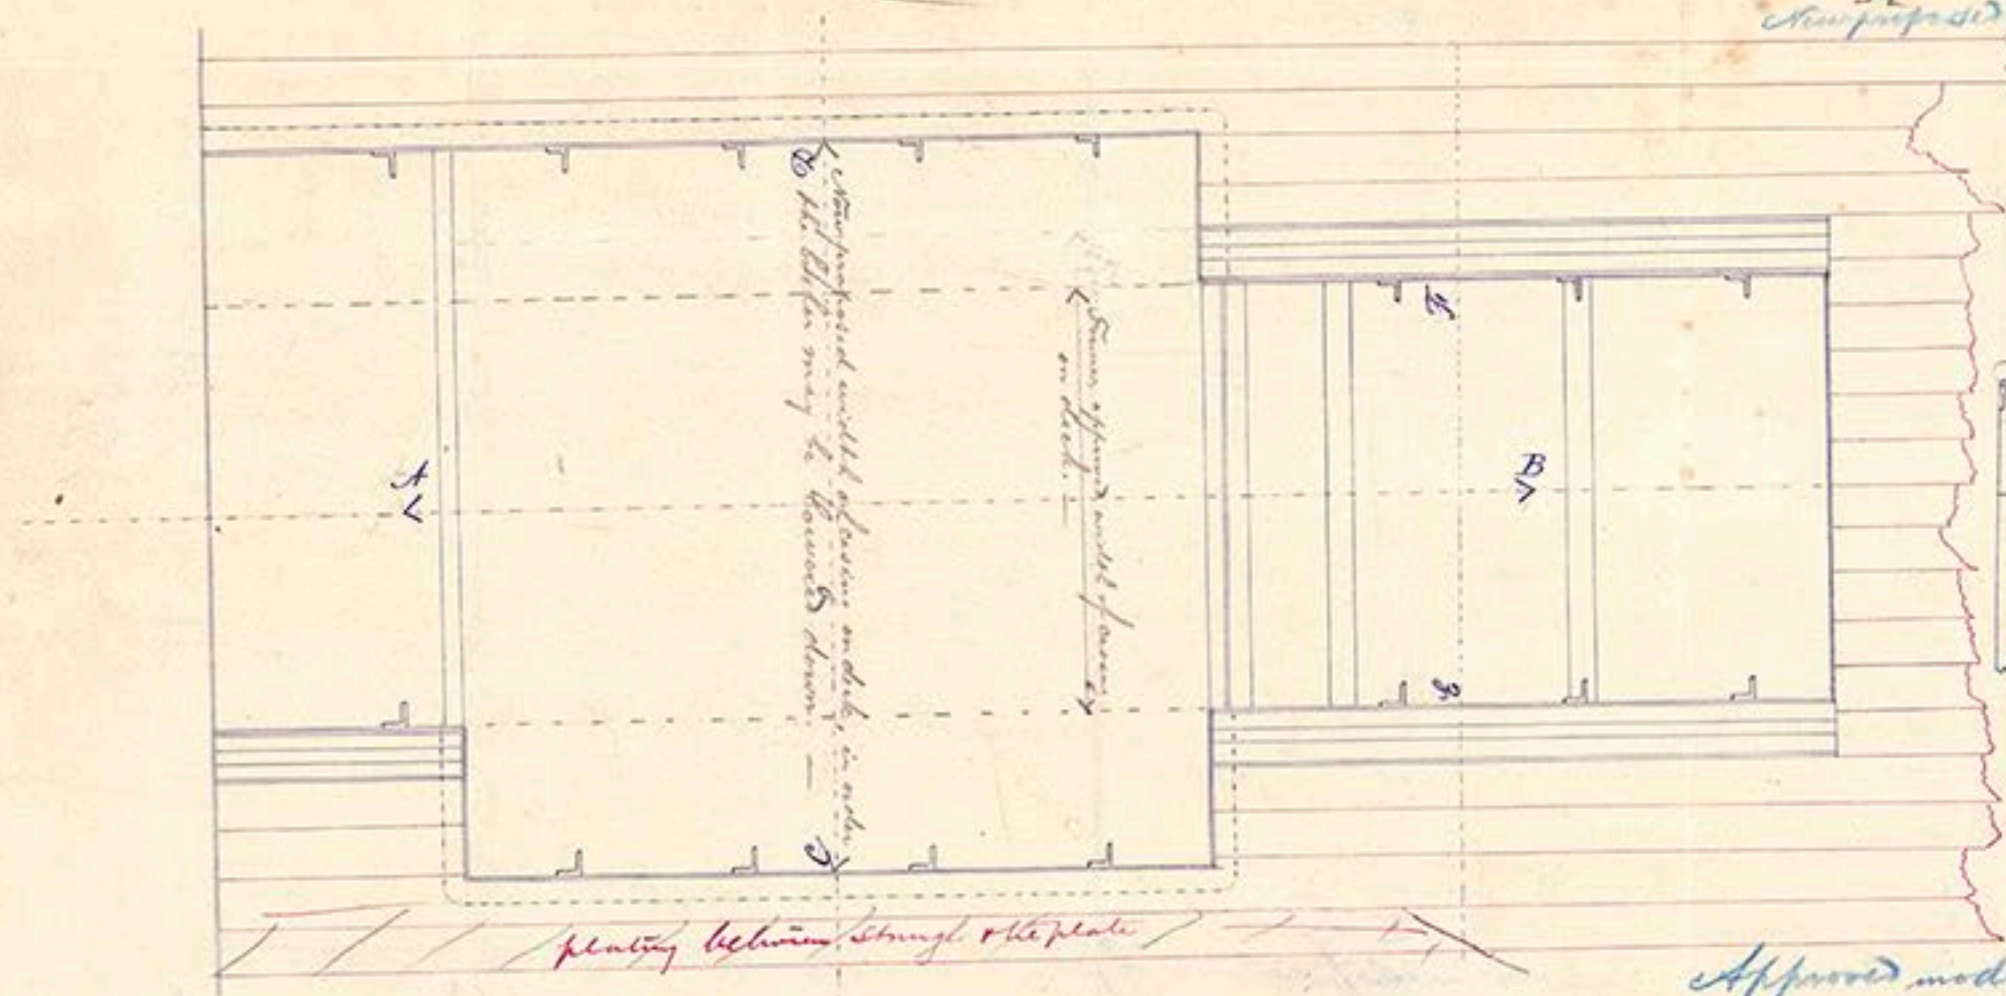

© 2018  
Lloyd's Register  
Foundation