


Approved plan of the Committee  
on the 15<sup>th</sup> Aug 1892, of the Steel steamer  
built at Vlissingen. —

Midship Section - Steam Vessel.

10.8.92  
15.5.92  
28.11.92

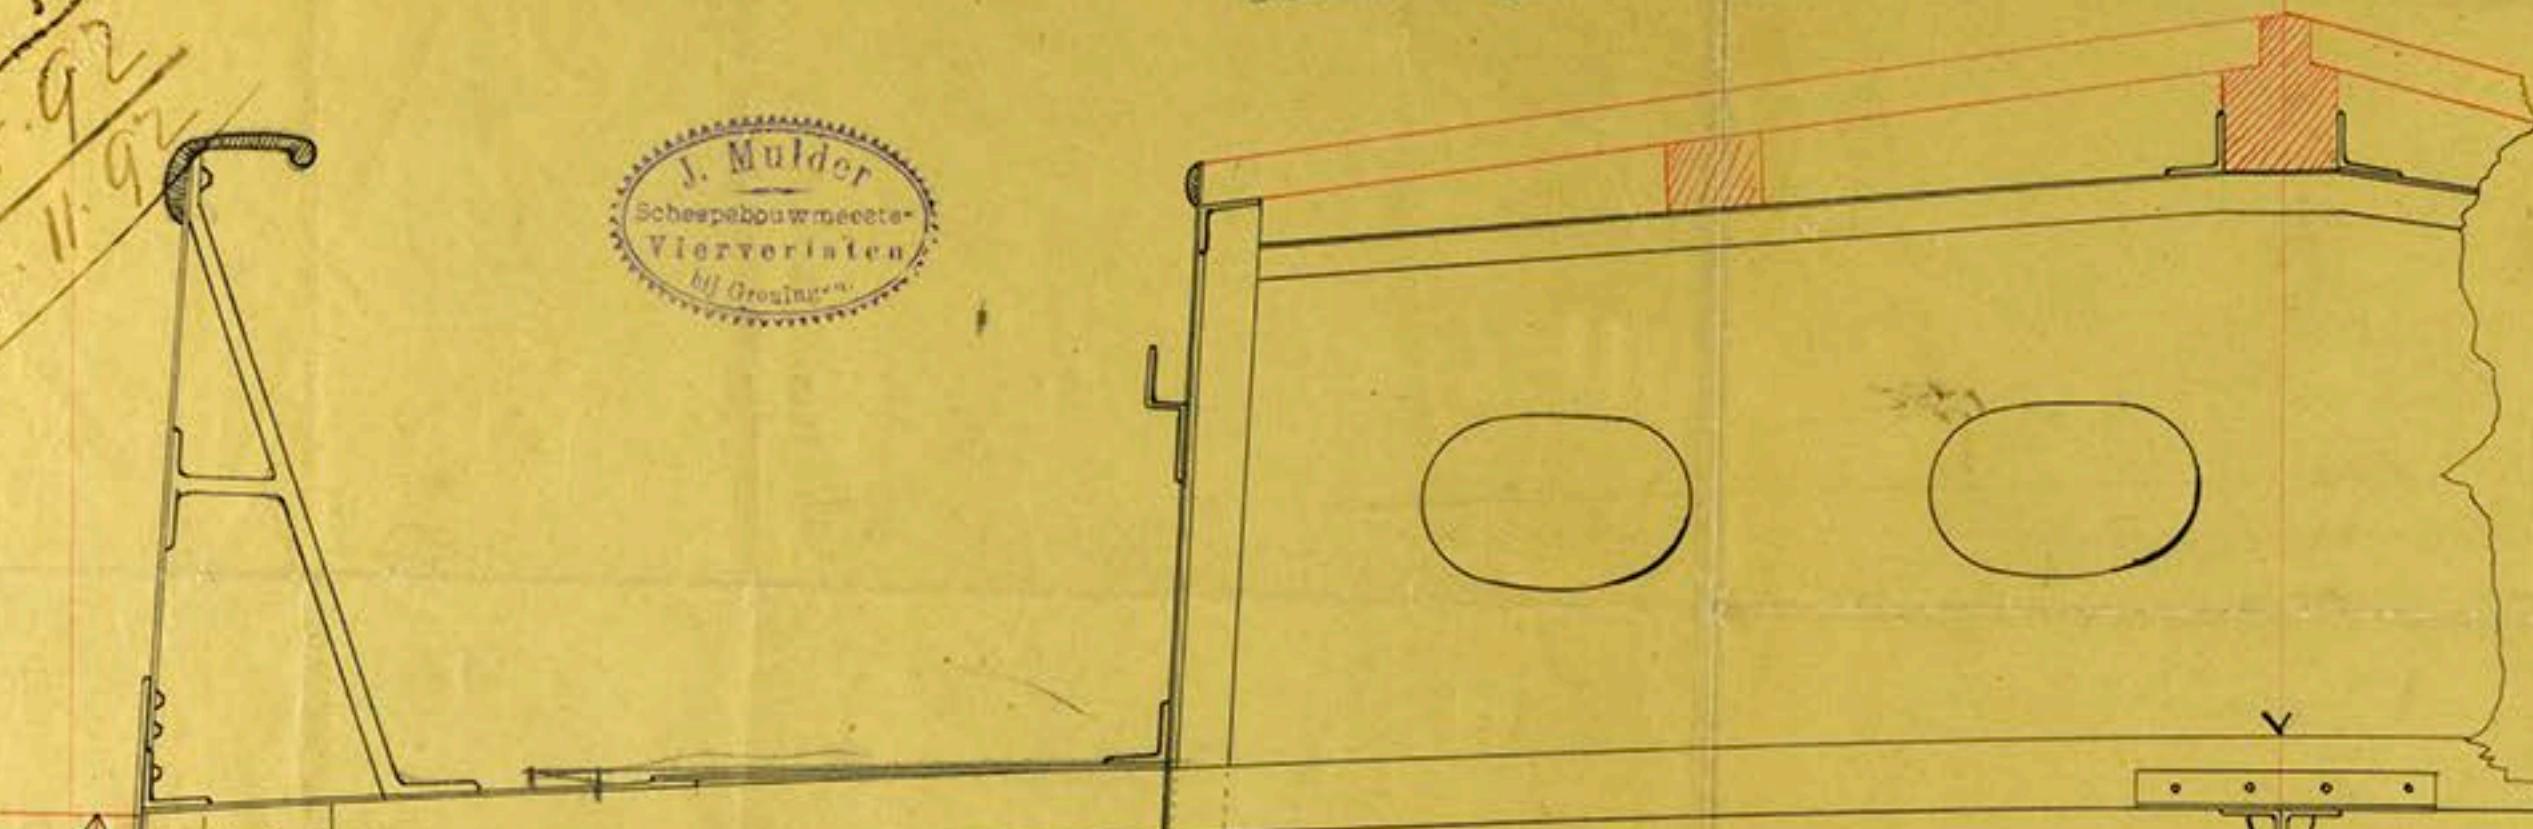

Length 110. 0"  
Breadth 20. 0"  
Depth 10.

Half moulded breadth (at the middle of the length) 10. 0"

Depth from the upper part of the keel to the top of the upper deck beams with the normal round up 10. 0"

The girth of the half midships frame section of the vessel measured from the centre line at the top of the keel to the deck stringer plate 18. 5"

1<sup>o</sup> Number 38.08

2<sup>o</sup> Number 4189

Rudder	$3\frac{1}{2} \times 2$ Iron or $3\frac{3}{4} \times 2\frac{1}{4}$ Steel (at the head)
" heel + pillars	$2\frac{1}{4}$
Steel deck	$\frac{1}{2}$
wood ceiling in hold, kitchen	$2$
Beams, single angle bars	$4 \times 2\frac{1}{2} \times \frac{1}{2}$
Forecastle "	$4\frac{1}{2} \times 3 \times \frac{1}{2}$
Haird quarter deck beams	$5 \times 3 \times \frac{1}{2}$
String plates (10 to 11 depths) & under 8 Breadths in length	$25 \times 6\frac{1}{2}$
Ends	$15 \times \frac{1}{2}$
Pie plates on beams	$7 \times \frac{1}{2}$

All the other building materials and details

concerning construction and workmanship in accordance  
to Lloyd's Rules & Regulations  
for classification 100 A

Spanning of frames	21 inches
Min. frames (all fore & aft)	$3 \times 2\frac{1}{2} \times \frac{1}{2}$
Reversed frames "	$2\frac{1}{2} \times 2\frac{1}{2} \times \frac{1}{2}$
Bulkheads	iron $\frac{1}{16}$
Solid pillars	iron $2\frac{1}{2}$
Floors	$2\frac{1}{2}$
Floors in engine space, kitchen	$1\frac{1}{2}$
Floors in boiler space,	$\frac{1}{2}$
Bar Keel	$6\frac{1}{2} \times \frac{1}{16}$
Stem	$5\frac{3}{4} \times \frac{1}{16}$
Stern frame	$5\frac{3}{4} \times 2\frac{1}{2}$
Garboard strakes	$30 \times \frac{1}{2}$

" " " Ends	$\frac{1}{2}$
Sheerbrace, half length, amidships	$\frac{1}{2}$
" " " Ends	$\frac{1}{2}$
Middle line Keelson	$\frac{1}{2}$ side plate $6\frac{1}{2} \times \frac{1}{20}$
	$9 \times \frac{1}{20}$
	$3 \times 3 \times \frac{1}{20}$
Dimension of angle bars for Stringers in hold and for deck stringer plates	$3 \times 3 \times \frac{1}{20}$

Wash plates for  $\frac{1}{2}$  length

10. 0"

Mulder  
13 Augustus 1892

