

Approved plan of the Committee  
on the 10 Aug 1892, length modified from 105' to 110'.

A

Ln 25/5/92



10.8.92

15.9.92

19.11.92

Steam Vessel 16/5 '92.

~~105.0~~ x 20.0 x 10.0  
110.0

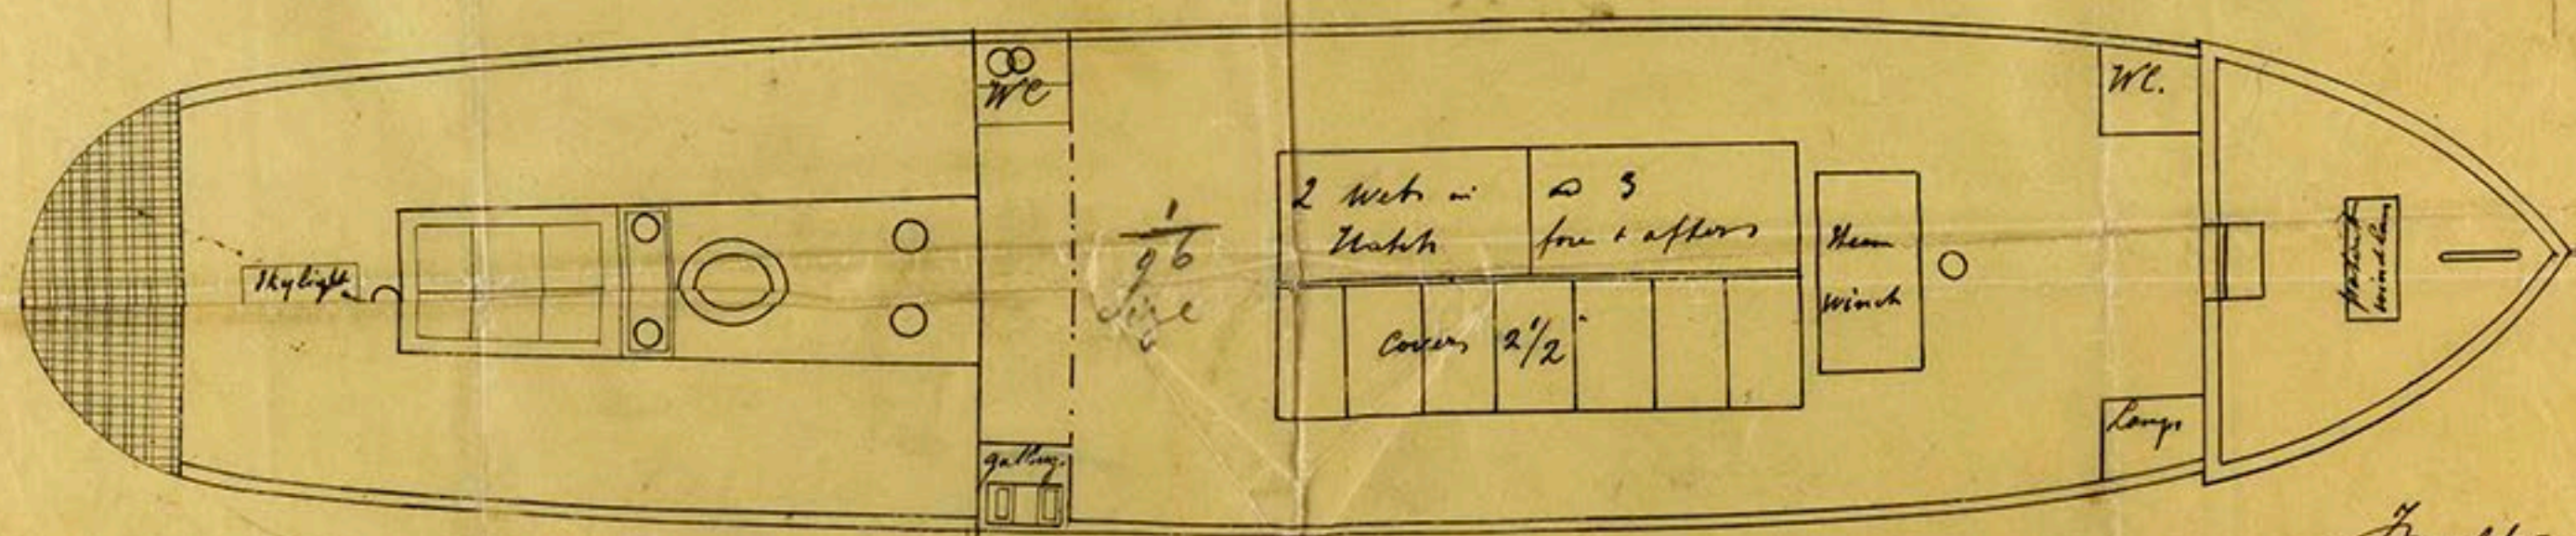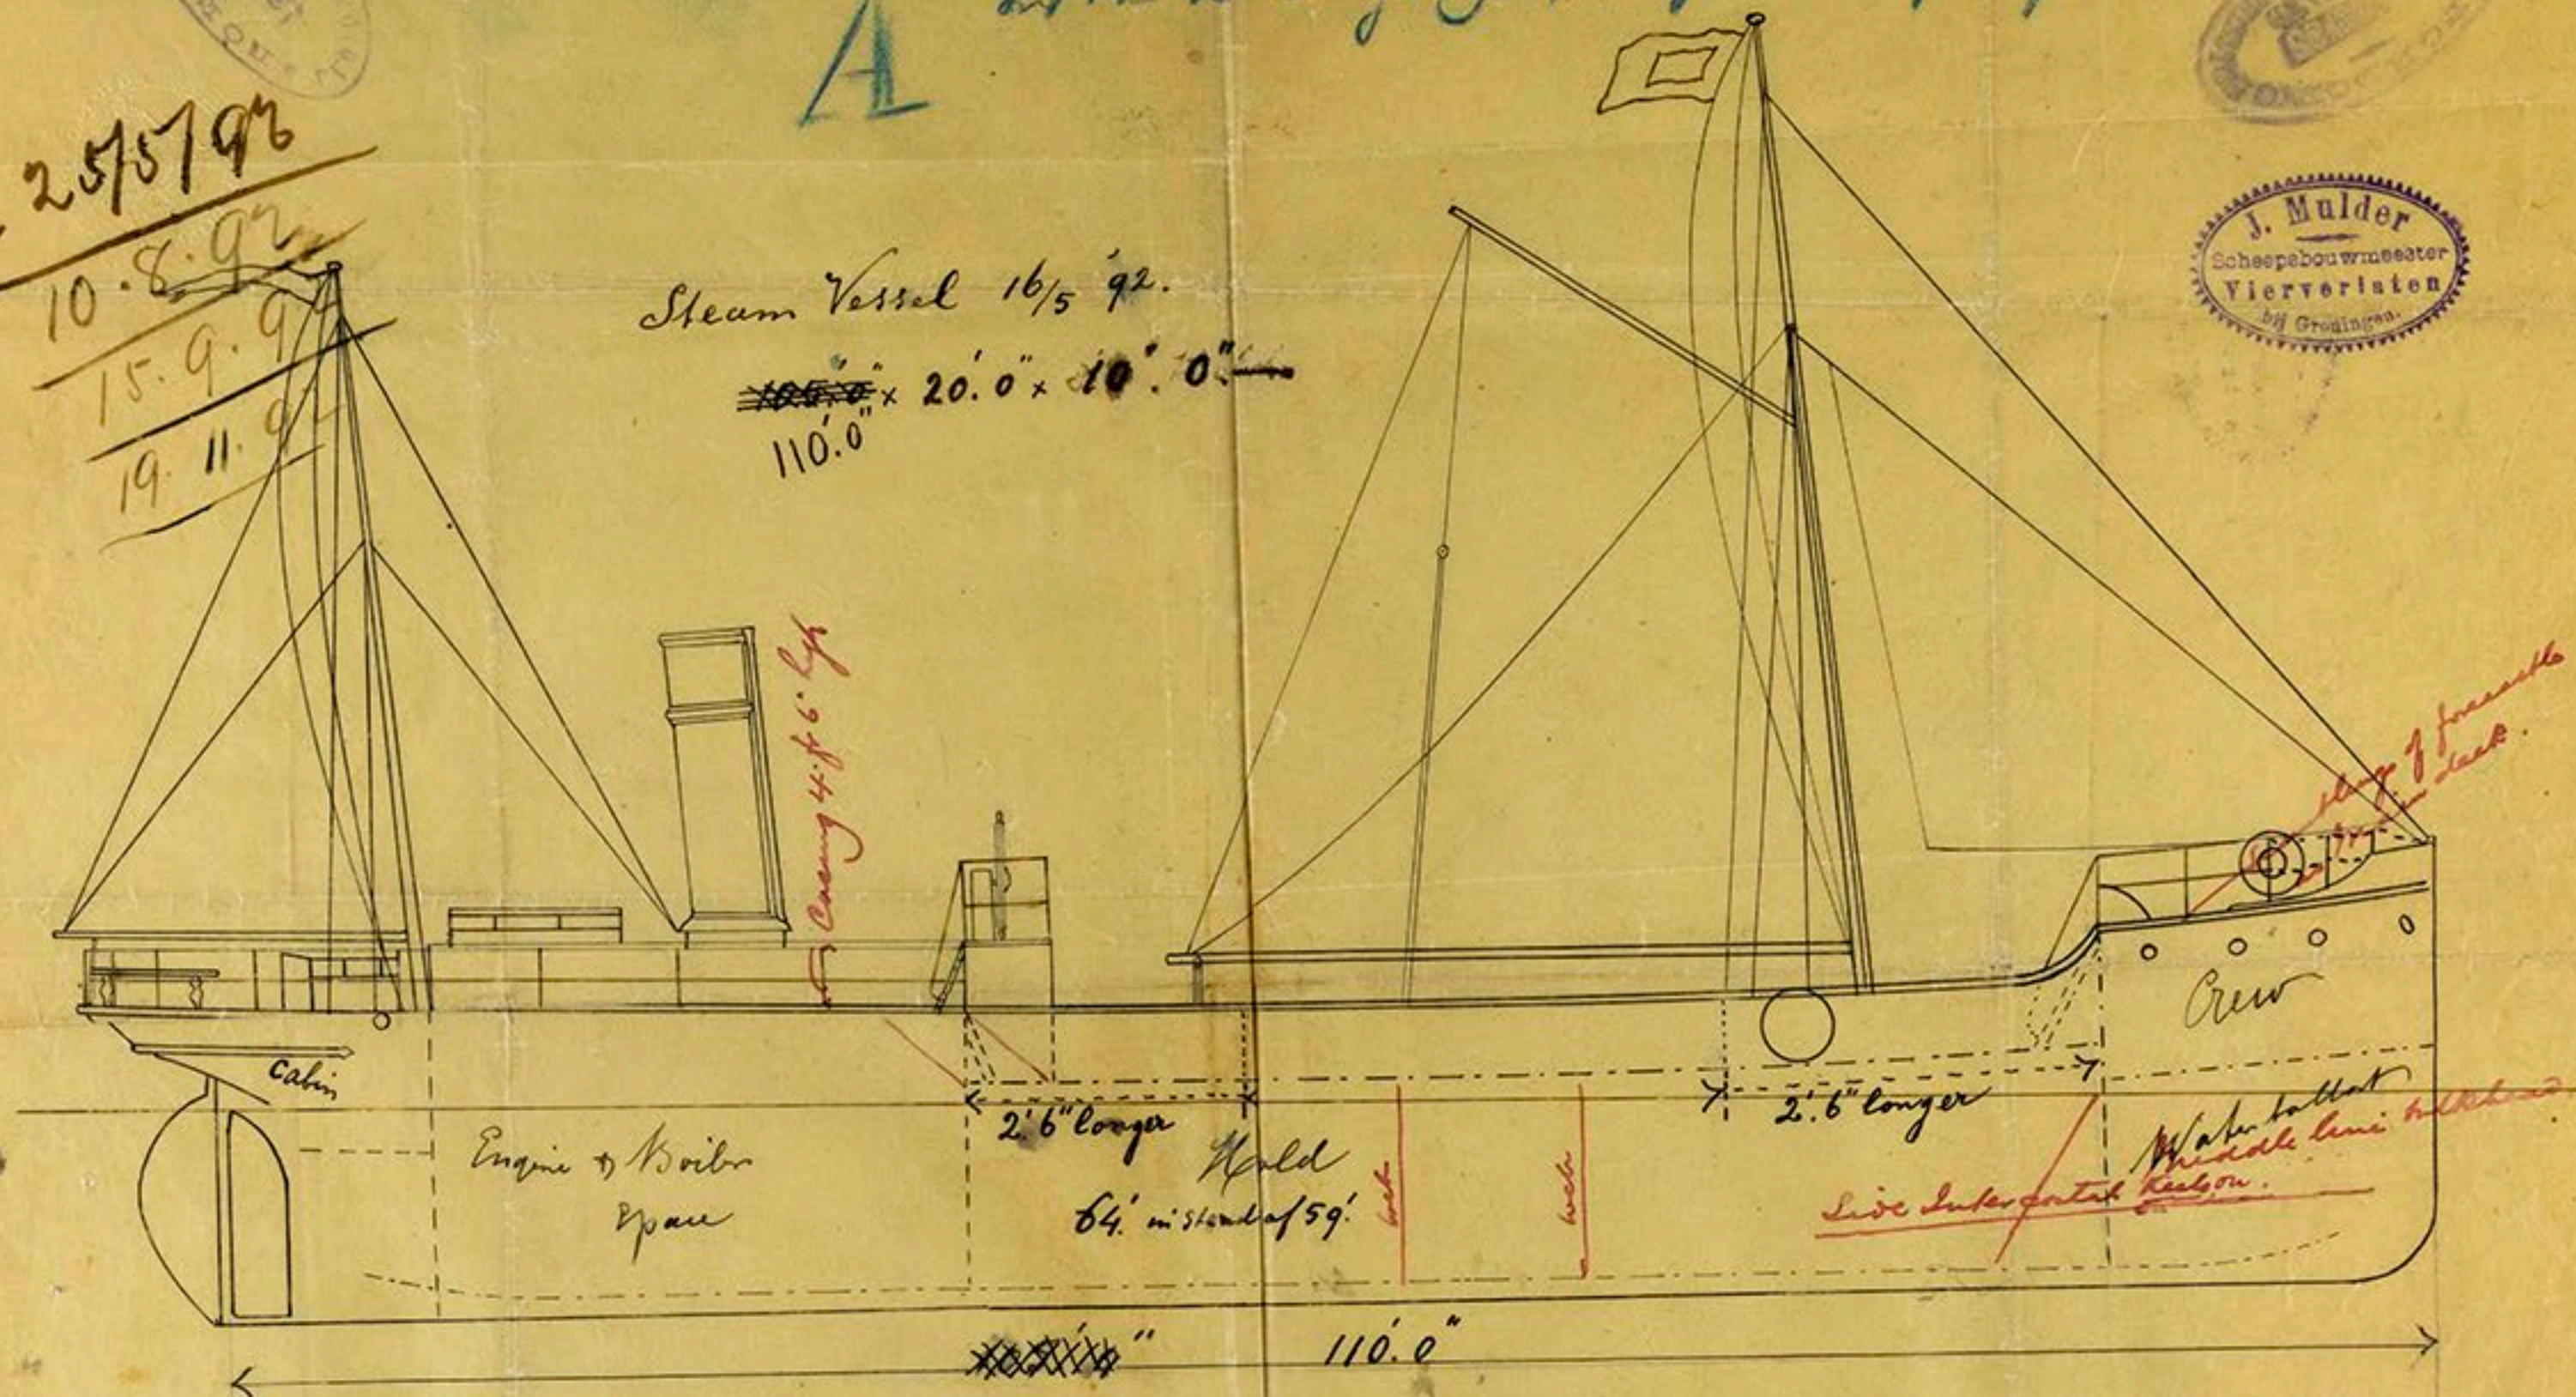

Note, - After the completion of building this vessel the machinery will be fitted on board the England by Mr. Pile & Co - as stated by the builder in his letter to the surveyor at Veen dam; -

Mulder, Viervlieten  
16/4 '92.



© 2018  
Lloyd's Register  
Foundation