

N.E.M.E. Coy
No
362.

S Mulder
of Groningen's
No 90




© 2018

Lloyd's Register
Foundation

WORKS

Plate $5/8 + 3/64$ "
Rivet holes 1" dia
Pitch of Rivets 4"

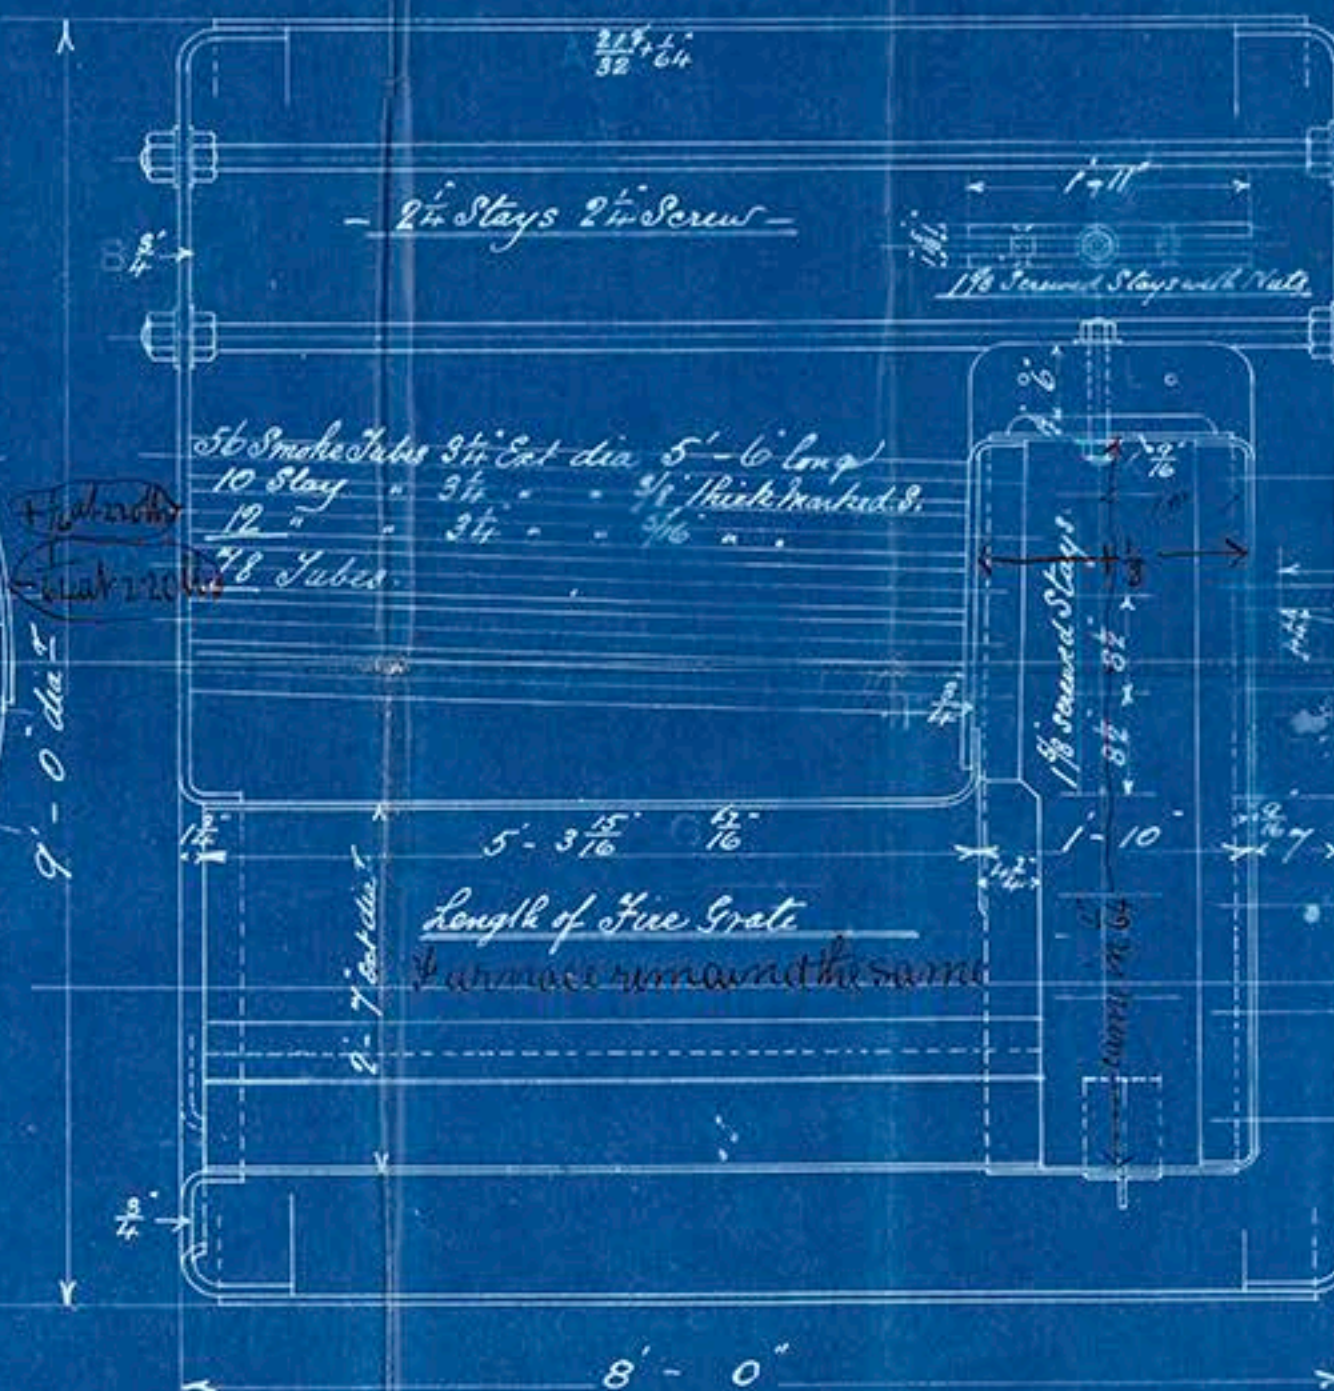

LR CONTRACT 362