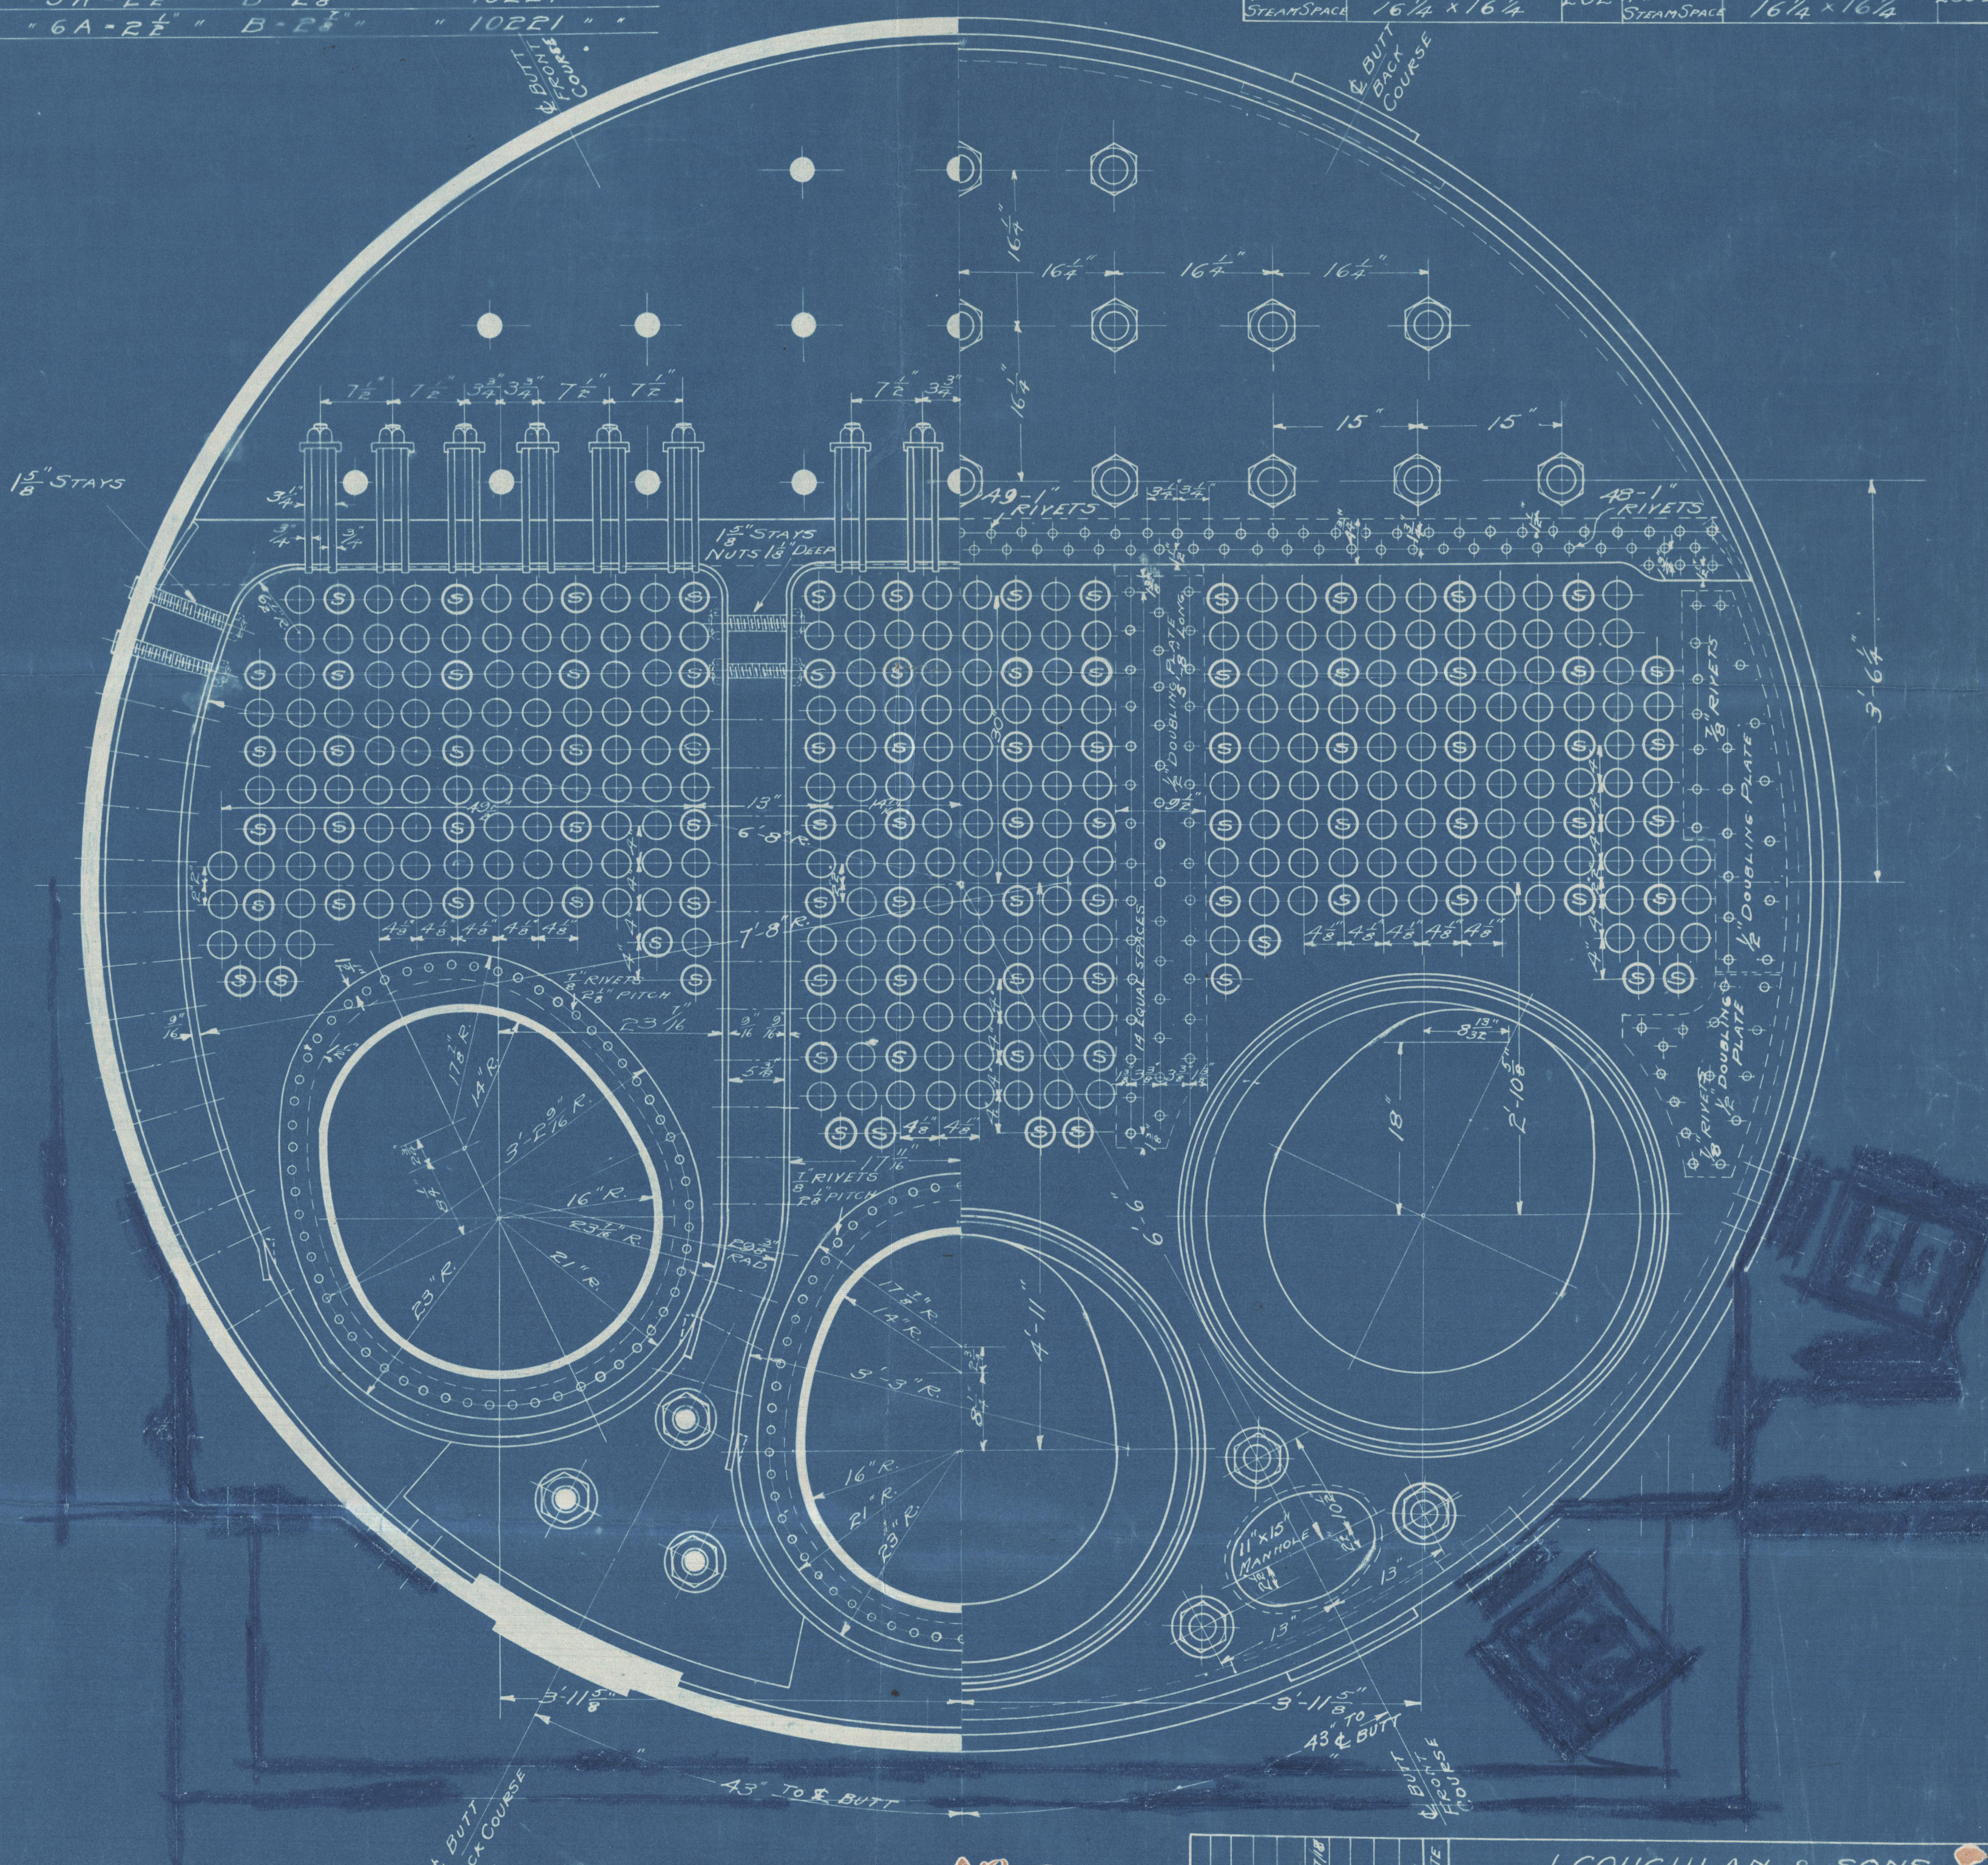


4"x6" HANDHOLE  
ON BOTH SID  
OF BOILER.

OMIT THIS RIVET ON  
BOTH SIDES OF  
BOILER FOR WATER  
NOZZLES.

OMIT THESE 2 RIVETS ON OTHER  
SIDE OF BOILER ONLY, FOR  
BOTTOM BLOW NOZZLE.

[illegible]


FOR BOILER MOUNTINGS, AND INTERNAL FITTINGS  
SEE DRG. N<sup>o</sup> 248 E.


--



J. Coughlan & Sons

Hull No. 8, "Benderuch"

S.S. "War Convoy" ex.



Main Boilers

N.B.

Built for Hull No. 4 & Installed in No. 8

11/4/19 EWS



Ver. Rpt. No. 729.

W10-0049



© 2020

Lloyd's Register  
Foundation