

17 MAR 1938

PROPOSED M V. *N^o 1016 + 1017* MIDSHIP SECTION.

SCALE 1/2" = ONE FOOT.



DIMENSIONS - 528'-0" B.P. x 70'-0" MLD. x 43'-4 1/2" MLD. TO UPPER D_K (SHELTER D_K).

TO CLASS 100 A.I. WITH FREEBOARD.

DRAFT CORRESPONDS TO A COMPLETE SUPERSTRUCTURE VESSEL HAVING A TONNAGE OPENING.

NUMERALS.

D	(43'-4 1/2" - 8'-4 1/2" + 8'-0")	45.00
L x D	(528.00 x 43.00)	22704
L x (B+D)	528.00 (70+43)	59664
L/D	528.00 / 43.00 & 528.00 / 51.42	12.17 & 10.27
d		14.80

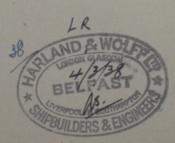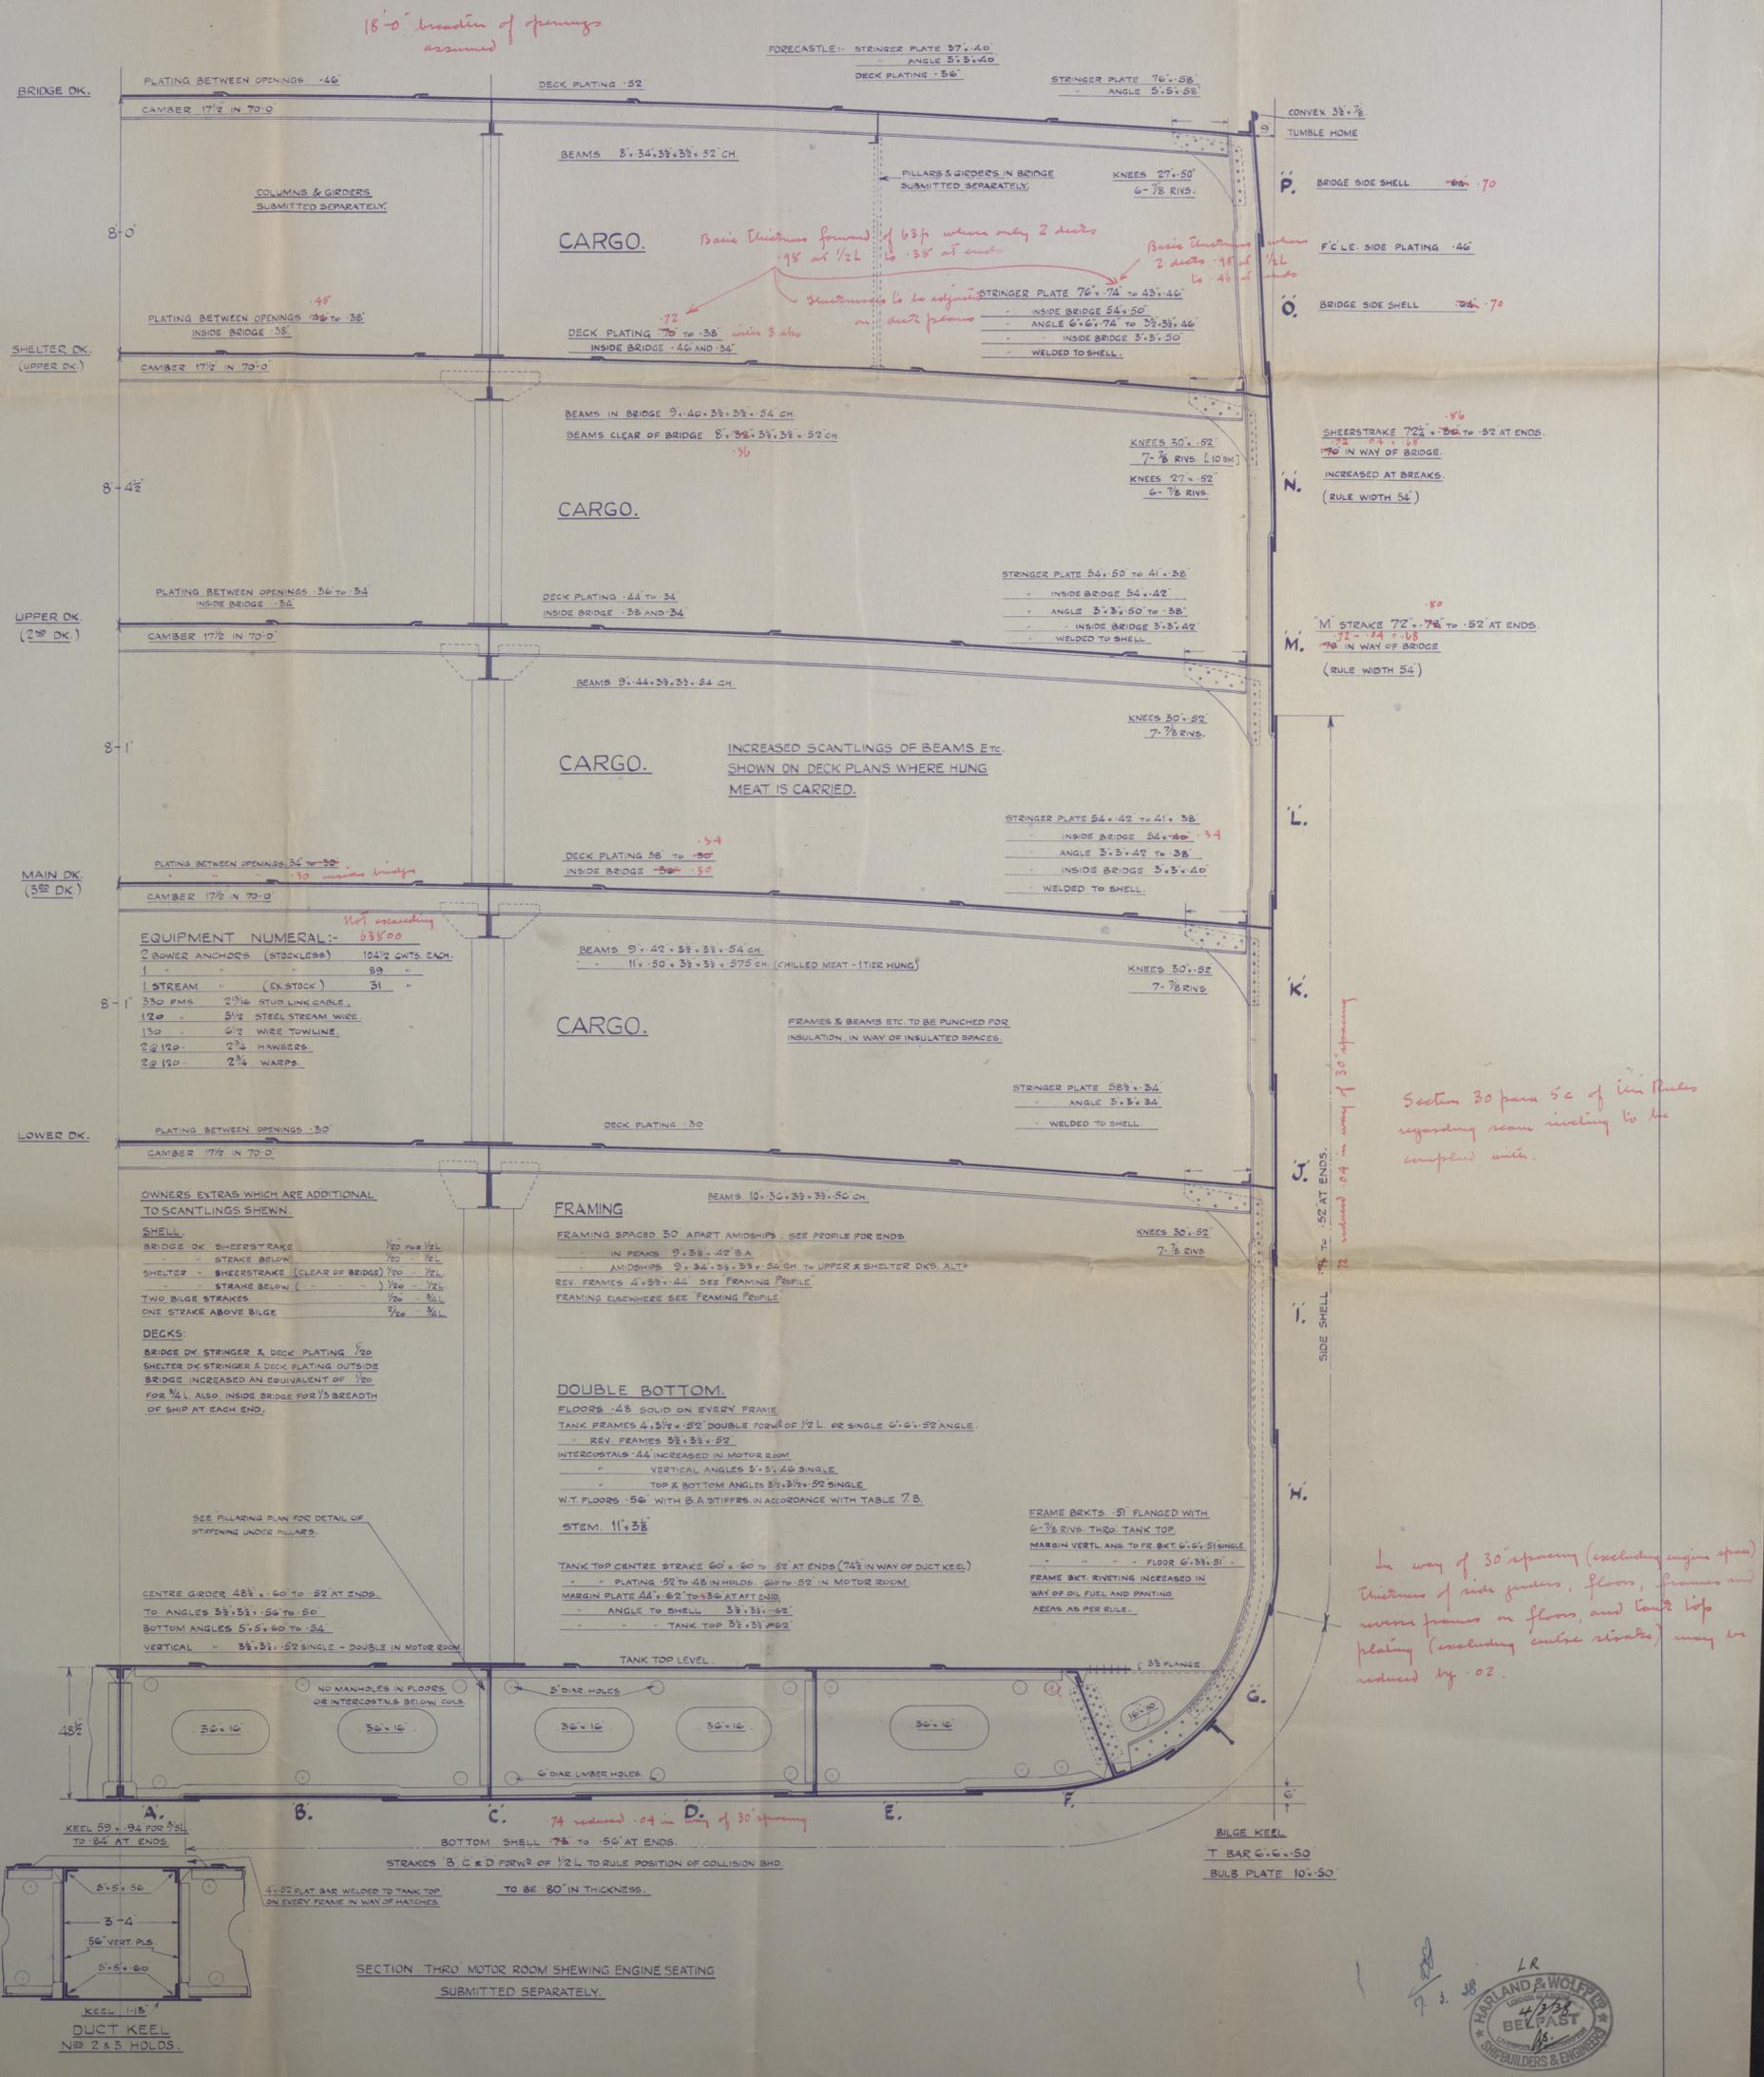

32

HARLAND & WOLFF LTD.
BELFAST

No. 1016/17

TITLE MIDSHIP SECTION

DATE APPROVED 17.3.38

(SEE AMENDED PLAN)

W100-0073



© 2019

Lloyd's Register
Foundation