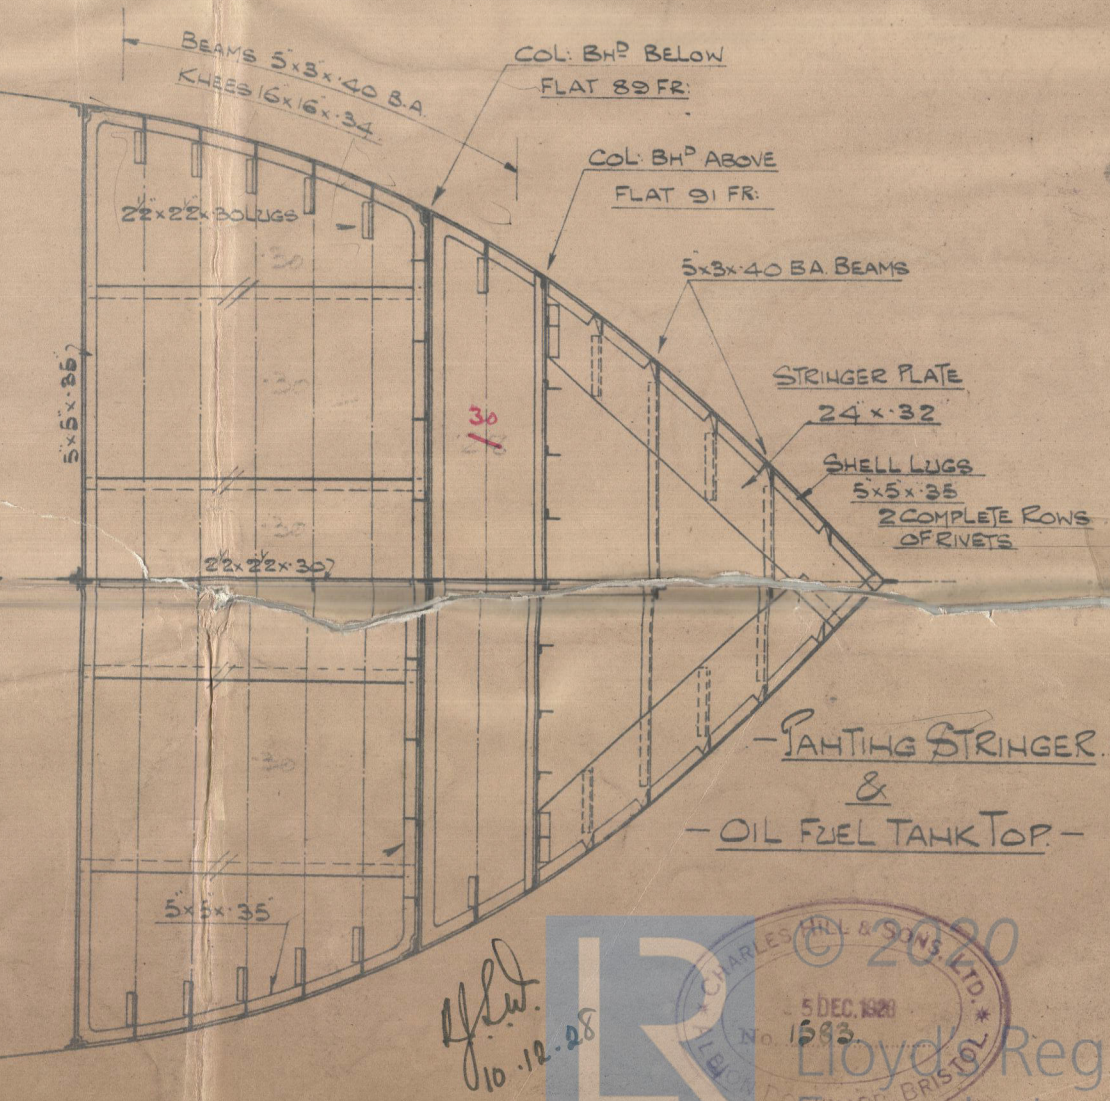
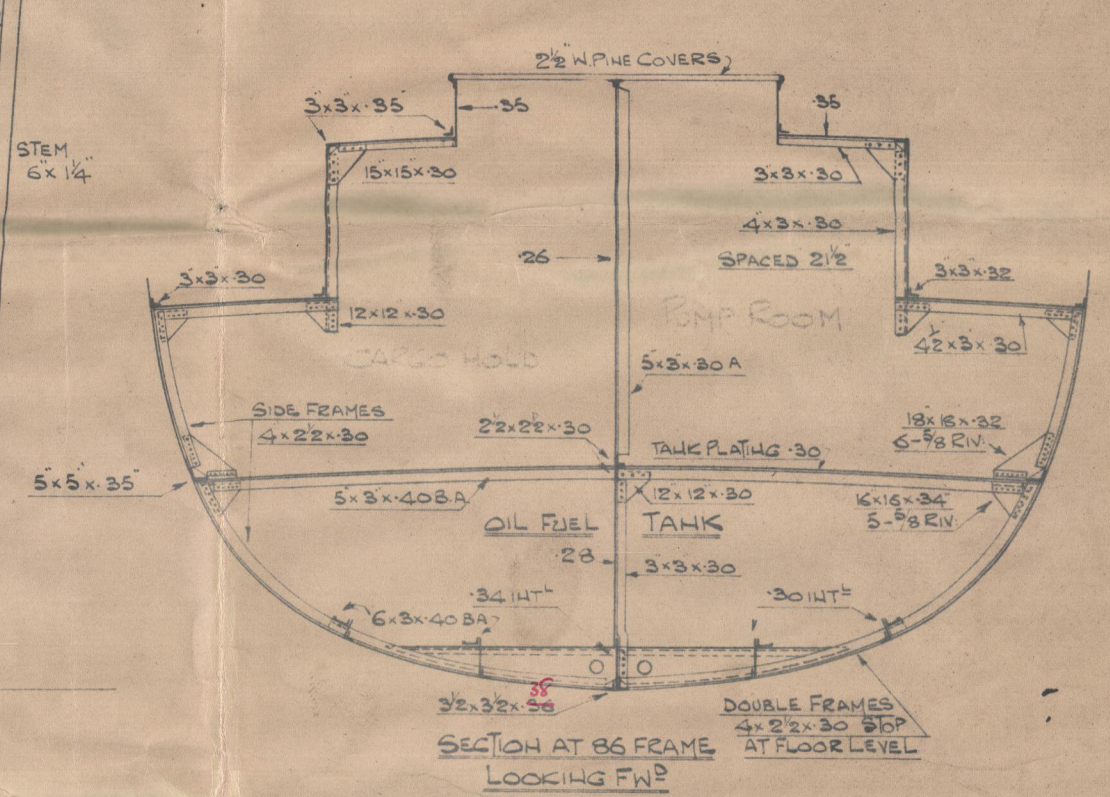
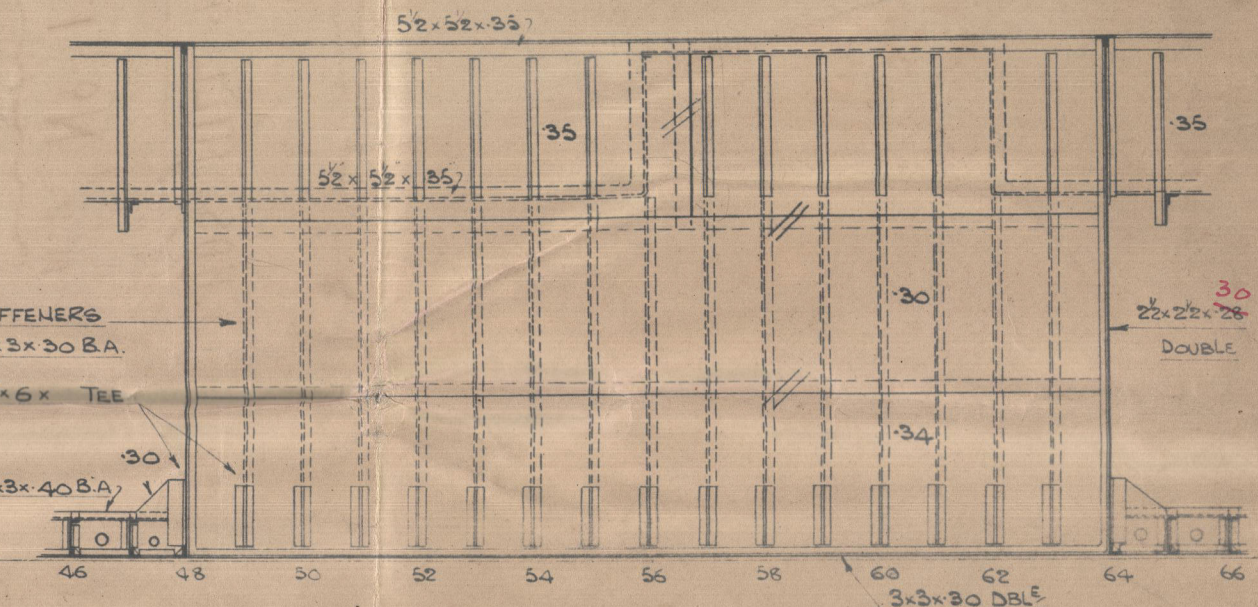


-M.Y. NO 173-
-STEEL ARRANGEMENT-

TO CLASS 100.A.1. CARRYING PETROLEUM IN BULK
ML² DIMENSIONS: 17'-6" x 31'-6" x 11'-0" (5'-0" TRUNK)

$$\frac{L \times (B+D)}{D} = \frac{7543.75}{16.13} = 467.7$$


CHAS. HILL & SONS LTD.,

M.V. No 173

(Steel Arrangement)

Profile & Deck.



Ukhomol

Brs 12282

RETAIN



© 2020

Lloyd's Register
Foundation