

Lloyd's Register of Shipping.


JAN 18 1938

Ship's Name "PEARLEAF"

Official No. 140269

Memorandum of alterations reported since ship was surveyed for assignment of Load Lines in Hong Kong

- (1) New partial bulkheads, plating .30", stiffeners 3"x 3"x .30" angles, spaced 30" now fitted, enclosing openings in forecastle bulkhead as shown in sketch below. Forecastle bulkhead now has "No openings".
- (2) Two steel companions 4'-6" x 3'-4" x 6'-6" high, plating .30" suitably stiffened, fitted on forecastle deck leading to crew's quarters. Watertight doors of steel, strongly constructed, can be operated from both sides, sill 12".

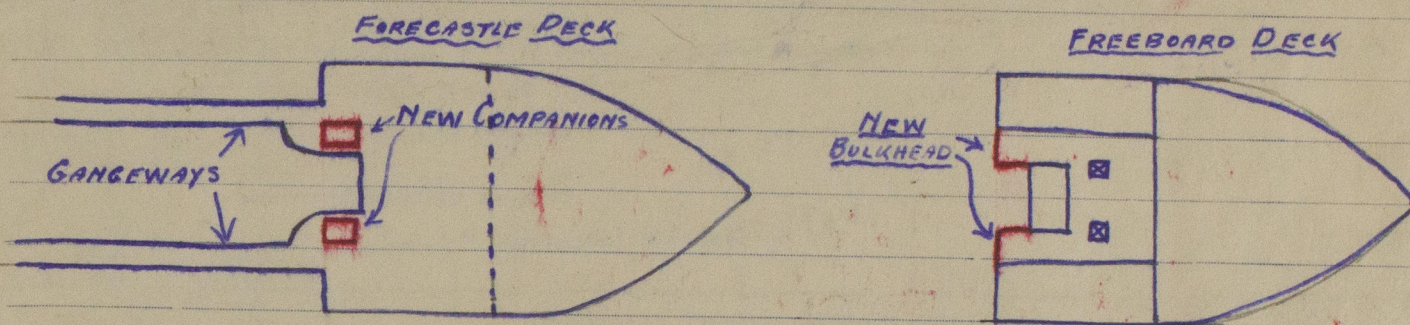

Chas. R. Rowcliffe

Computation amended and new certificates issued.

Noted

31 JAN 1938