

RECD NEW YORK JUN 1 1918

# Lloyd's Register of Shipping.

## SURVEYS FOR FREEBOARD.—STEAM SHIPS. No. 2725

W1002-0164

25592.

PARTICULARS RELATING TO ALL STEAM SHIPS EITHER FLUSH DECKED, OR WITH TOP GALLANT FORECASTLES, SHORT POOPS AND BRIDGE HOUSES DISCONNECTED, OR WITH TOP GALLANT FORECASTLES HAVING LONG POOPS, OR RAISED QUARTER DECKS CONNECTED WITH BRIDGE HOUSES, OR OTHERWISE.

*Sum 1B.C. to 2: W.W.BRUE*
 Port of Survey Philadelphia  
 Date of Survey While Building  
 Name of Surveyor R.D. Cairns.

 Ship's Name.  
S.S. SABINE SUN

 Port of Registry  
 Philadelphia  
 U.S.A.

 Official  
 Number.  
 ✓

 Gross  
 Tonnage.  
 ✓

 Date of Build.  
Building

 Particulars of Classification.  
 +100 A.T. Carrying Petroleum  
 in bulk (Contemplated)

Number in Register Book

Registered dimensions from Ship's Register.	LENGTH.	BREADTH.	DEPTH.	UNDER DECK TONNAGE.
	429.3	59.23 ✓	31.4 to assumed line	6537.17
Length on LOADLINE.	430.0	✓ Frame Depth 9 ✓ Ceiling + .20 ✓ Rule " 7 ✓ Sheer + .18 ✓ - .33 ✓ + .33 in cage battens	Peak 3 incl. Tanks	+43 future assumed line stop of tank
CORRECTED DIMENSIONS.	430.0	59.23 ✓	31.80 ✓	6580.17. ✓

 Co-efficient of fineness.....  
 Any modification necessary  
 [Para. 4 (a) to (e)]\*  
 Co-efficient as corrected .....

 81 ✓  
 ✓  
 ✓

7.37

 Sheer { Stem ..... 112.37 } 168.49 ÷ 2 = 84.249 Mean 20  
 at Sternpost ... 58.12 ✓ 20  
 Sheer at  $\frac{1}{8}$  of the length from Stem 33 ✓ 49 ÷ 2 = 24.5 Mean 20  
 Sternpost 16 ✓ 45.63 ✓  
 Gradual mean Sheer plotted 44.64 ✓ 6.61 (for London P.D.)  
 Standard mean Sheer [Table, Para. 18] 53 ✓ Correction  
 Difference 7.87 - 3.99 ÷ 4 = + 1.75 ✓  
 § If limited as Para. 18 (f) .....  
 No shear for 172' amidships = 40%.  
 Sheer correction is as given by London for the sister vessel  
 Rise in Sheer { At front of bridge house ..... At after end of forecastle ..... }  
 from amidships At front of bridge house ..... At after end of forecastle ..... ✓  
 [Para. 18 (e)] ✓

 Fall in Sheer  
 Para. 18 (d)      ÷ 2 = ✓  
 Length uncovered ..... Correction

## ALLOWANCE FOR DECK ERECTIONS:

 Freeboard, Table C ..... 5 - 9.15 ✓  
 Correction for Length, if required (Para. 12, 13, and 14) ..... + 2.5 ✓  
 6 - 0.23 ✓  
 Freeboard by Table A. corrected for sheer, and for length, if required (Para. 12, 13, and 14) ..... 9 - 8.20 ✓  
 Difference ..... 3 - 4.99 ✓  
 Percentage as below ..... 31.16% ✓  
 - 13.55 ✓  
 13.63 ✓

 Correction for R. Q. Dk. if engine and boiler openings not covered by bridge house (Para. 11) ..... 13.40 ✓  
 Allowance for Deck Erections ..... - 13.55 ✓

 Length.      Length allowed.      Height.  
 Forecastle ..... 40.38' ..... 40.38' ..... 8'0"  
 Bridge House ..... 36.46 ..... 36.46 ✓ ..... 8'0"  
 † Raised Qr. Dk. ..... ✓ .....  
 Poop ..... 133.0 ..... 133.0 ✓ ..... 8'0"  
 Total ..... 209.84 ✓  
 Length of Ship ..... 430 ✓ = 488 ✓  
 Corresponding percentage  
 (Para. 12, 13, or 14) ..... 31.16% ✓

**FREEBOARD** recommended amidships from centre of Disc to top of Statutory Deck Line, Wood (Iron) Deck:

 Fresh Water Line ..... above centre of Disc .....  
 Indian Summer Line ..... " ..... "  
 Winter Line ..... below " ..... "  
 Winter North Atlantic Line ..... " ..... "

 \* If the frames, skin planking, or ceiling are of unusual thickness the breadth of vessel to inside of ceiling should be reported if possible.  
 † In vessels obtaining an allowance for deck erections under Para. 11 where the sheer drops abeam amidships the height of the R.Q.D. is to be taken from the level of the top of the amidship beam.  
 § In flush-decked vessels the total standard mean sheer means the sheer measured at the stem and stern-post. In vessels having poops and forecastles, it means the sheer measured at points distant one eighth of the vessel's length from stem and stern-post.

lm.11.15. T.

 Moulded Depth as measured ..... 33' - 3" ✓  
 NOTE — If the depth is measured when vessel is afloat, the details of measurement should be reported.

## CORRECTION FOR LENGTH.

 Length of Ship on Loadline ..... 430.0 ✓  
 Length in Table ..... 399.0 ✓  
 Difference ..... 31.0 ✓  
 Correction for 10ft., Table A. ..... 1.65 ✓ Table C. 8 ✓  
 × Difference divided by 10 ..... 5.11 ✓ (if required) 2.48 ✓  
 If  $\frac{1}{10}$ ths length covered divide by 2 ..... + 5 ✓ ..... + 2.5 ✓

## CORRECTION FOR IRON DECK.

 Proportion covered, if less than  $\frac{7}{10}$ ths length covered ..... 4.88  
 Thickness of usual wood deck, less stringer ..... 4.69 = 3.31  
 1.61 - 1/2

## CORRECTION FOR ROUND OF BEAM.

 Breadth at Gunwale amidships ..... 59 ✓  
 Round of Beam ..... 14.34 ✓  
 Normal round ..... 12.34 ✓  
 Difference ..... ✓ ÷ 2 = ..... ✓  
 Proportion of Deck uncovered (Para. 19) ..... ✓

NOTE — The round of beam should be reported on the full breadth of vessel at the gunwale.

 Freeboard, Table A ..... 9 - 1.25 ✓  
 Correction for Sheer ..... 1.84 ✓  
 9 - 3.09 ✓  
 5.11 ✓  
 Correction for Length .....  
 Allowance for Deck Erections ..... 9 - 8.20 ✓  
 1.40 ✓  
 8 - 6.50 ✓

 9 - 1.25 ✓  
 + 1.84 ✓  
 9 - 8.20 ✓  
 - 1.40 ✓  
 8 - 6.50 ✓

Correction for Round of Beam ..... ✓

Correction for fall in Sheer (if any) ..... ✓

 Correction for Iron Deck (if required) ..... 1.61 ✓  
 8 - 4.89 ✓

 - 1/2 ✓  
 8 - 4.89 ✓

 Additions for non-compliance with provisions of  
 Para. 11 (d) and (e) + ..... ✓

Other Corrections (if any) ..... ✓

RE TAIR

 Winter Freeboard .....  
 Summer Freeboard ..... 6 ✓  
 Indian Summer Freeboard .....  
 N. A. Winter Freeboard .....  
 8 - 4.34 ✓  
 7 - 10.34 ✓  
 7 - 4.34 ✓


 Correction necessary because clearside amidships, measured in accordance with the Statute is not taken at the intersection of the steel iron deck with side. + 1/2 ✓

 Winter Freeboard from deck line ..... 8 - 6.5 ✓  
 Summer " " " ..... 8 - 0.5 ✓  
 Indian Summer " " " ..... 7 - 6.5 ✓  
 N. A. Winter " " " .....  
 8 - 0.5 ✓  
 6.5 ✓  
 6.5 ✓


State dimensions of freeing port area on back of this form.

The Surveyor should state whether the fall in sheer as reported is measured relatively to the straight line of keel or to the water line. If measured relatively to water line the vessel's draft at time of survey, and also the usual load draft forward and aft should be reported.

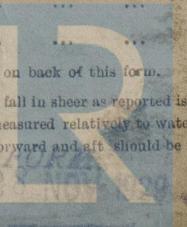

Do all the Frames extend to the top height in the Poop? Yes  
 To what height do the Reverse Frames extend? Raised Quarter Deck?  
 Has the Poop or Raised Quarter Deck an efficient Iron Bulkhead at the fore end? Bridge House?  
 Give particulars of the means for closing the openings in Bulkhead. Longitudinal Fanning  
 Is the Poop or Raised Quarter Deck connected with the Bridge House? No  
 Give particulars of the means for closing the openings in Bulkhead. No openings  
 What is the thickness of the Bridge Front plating? 1/8" and Coaming plate? 1/8"  
 Give scantlings and spacing of the Stiffeners. 10 x 32 x 32 x 32 1/2" 43" apart in line with deck longitudinal  
 Are bracket plates fitted at each end of the Stiffeners? Yes. Are hor'l. brackets fitted connecting Bridge Bulk'd. with Bulwarks? Yes.  
 Has the Bridge House an efficient Iron Bulkhead at the after end? Yes.  
 How are the openings closed? Two openings 5' 3" x 3' 1/2" closed with hotted plates. Bolts 3 1/2" apart through  
 Bulwark plates doors made watertight.  
 Is the Forecastle at least as high as the main or top-gallant rail? Yes. Has the Forecastle an efficient Iron or Wood Bulk'd. at after end? Side houses.  
 Are the Engine and Boiler openings covered by a Bridge, Poop, Raised Quarter Deck, or enclosed by a Strong Iron or Steel Deckhouse? Covered by Poop & Casing on top of same.  
 If the openings are not so protected are the exposed parts of the Casings efficiently constructed?  
 Give thickness of plating; scantlings and spacing of Stiffeners  
 What is the height of the exposed Casings?  
 Are suitable means provided for closing all openings in them in bad weather?

Position and Size.	10' 8 1/2" x 15' 3"	9' 5" x 4' 6" at hatch	5' 5" x 6' 0" x 4' 0" at hatch	Coal hatch on Poop		
Item.	Ship.	Rule.	Ship.	Rule.	Ship.	Rule.
COAMING. Height above top of DECK	30	30	Steel hinged covers	30	30	
Thickness { Sides.....	.44	.44	fastened with	.375	.44	
Ends.....	.44	.44	Drop bolts spaced about 15' apart	.375	.44	
SHIFTING BEAMS OR WEB PLATES.	Number .....	v	Criton .38 thick	Steel hinged covers .38 thick stiffened - fastened with drop bolts about 15' apart.	Gum Marsdale 18x15	
* FORE AND AFTERS.	Number .....	3			Steel	
Material .....	Section and Scantlings .....	1/8x50x1 1/2". Dr				
HATCHES Thickness .....	3	3			3	
Remarks .....	v	v			v	

\* The depth of Fore and Afters should be stated from the underside of the hatches in all cases.

(If the sill of the lowest side scuttle will be less than 6 inches above the Indian Summer Load Line if assigned under the tables, state vertical distance from top of deck at side amidships to lower edge of lowest side scuttle.)

The following information is to be given in all Cases of vessels dealt with under Paras. 11, 12 (under 15 feet Moulded depth) and under Shelter Deck Rules.  
What is the thickness of the Bridge Sheerstrake?

Strake between Main and Bridge Sheerstrakes?

Delete the words { The Crew are, are not, berthed in the bridge house.  
that do not apply { The arrangements to enable them to get backwards and forwards from their quarters are, are not satisfactory.


Length of Bulwarks in well

Area of Freeing Ports required by Para. 11 (e) each side of vessel = Sq. ft.

Ft. Tenths. Ft. Tenths. No. { Freeing Ports = Sq. ft.

x x (each side of vessel)

Total deficiency or excess = Sq. ft.

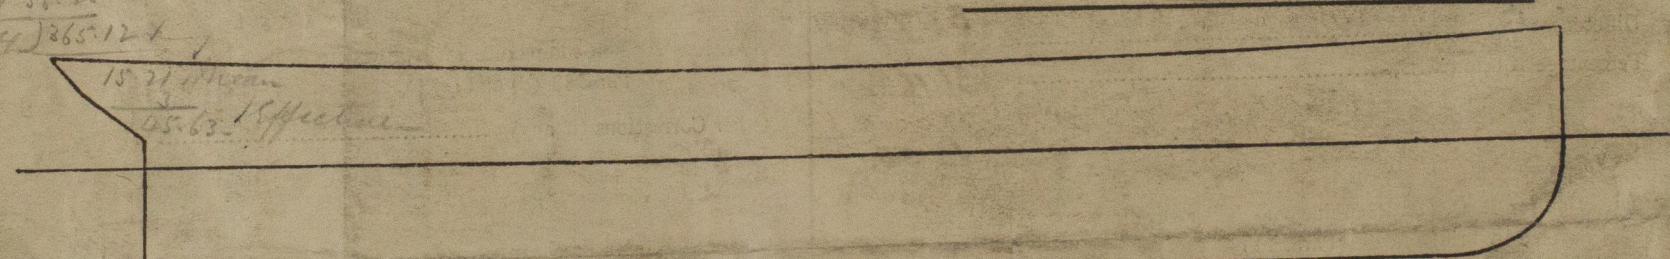

Show hereon line of Floors or Tank Top with position of any Breaks in same; also height of Peak Tank tops, &c., &c.

State any special features in the construction of the Vessel This vessel is built on the longitudinal system

is a sister vessel to the S.S. "Chester Sun" R.R. No. 2689. Copies of the  
App. plans are in the London Office. Freeboard Report herewith. Sketch of Sheer Curve also  
inclosed herewith.

Owners Sun S.A.C. Chester  
Builder

" Address

Fee £ 50/- will be charged Received by me  
on first entry - 10.10.5



© 2020

Lloyd's Register  
Foundation