

36 JUL 1942
32247
32247

U. 738


Lloyd's Register of Shipping.

Ship's Name M/V "Schuykill"

Official No. 148358

Memorandum of alterations reported since ship was surveyed for assignment of Load Lines
in January, 1942.

The fore & aft gangways have been stiffened by fitting
3" x 3" x 40" crossed angle bracing longitudinally between alter-
nate pairs of supports

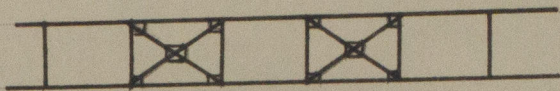

P. D. Crandace

Sunderland 3rd July, 1942.

A copy of the above has been attached to the report C 11 on
board.

Boled
6/7/42