





512

FOR  
CONTRACT  
174-175

NEW YORK SHIPBUILDING CO.  
CAMDEN, N. J., U. S. A.  
BLUE PRINT ROOM

Print No. 19

Made JUL 6 1915

For Dep't 620 YDS




© 2020

Lloyd's Register  
Foundation



New York & B Co  
167-8-70- Phila

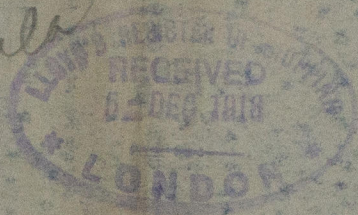

Amended Copy of  
Main Boilers  
Spacing of tubes & tube  
plates.

also. For Contract No 174-175

S/S "Standard Arrow"  
Chla. Rpt. No. 2438.

W1002-0275

178 & 190 - has extra copy  
No. 178-5615-1



© 2020

Lloyd's Register  
Foundation