


S.S. No. 256, 257, & 258

TO CLASS. 100. A.I. LLOYDS. SPECIAL SURVEY.
BUILT OF STEEL.

DIMENSIONS.
LENGTH BETWEEN R.P. 311'-0"
BREADTH MOULDED. 40'-6"
DEPTH MOULDED TO UPPER DECK 21'-9"
" " " " POOP 29'-9"

SCALE 1/8" = 1'

3.8.06

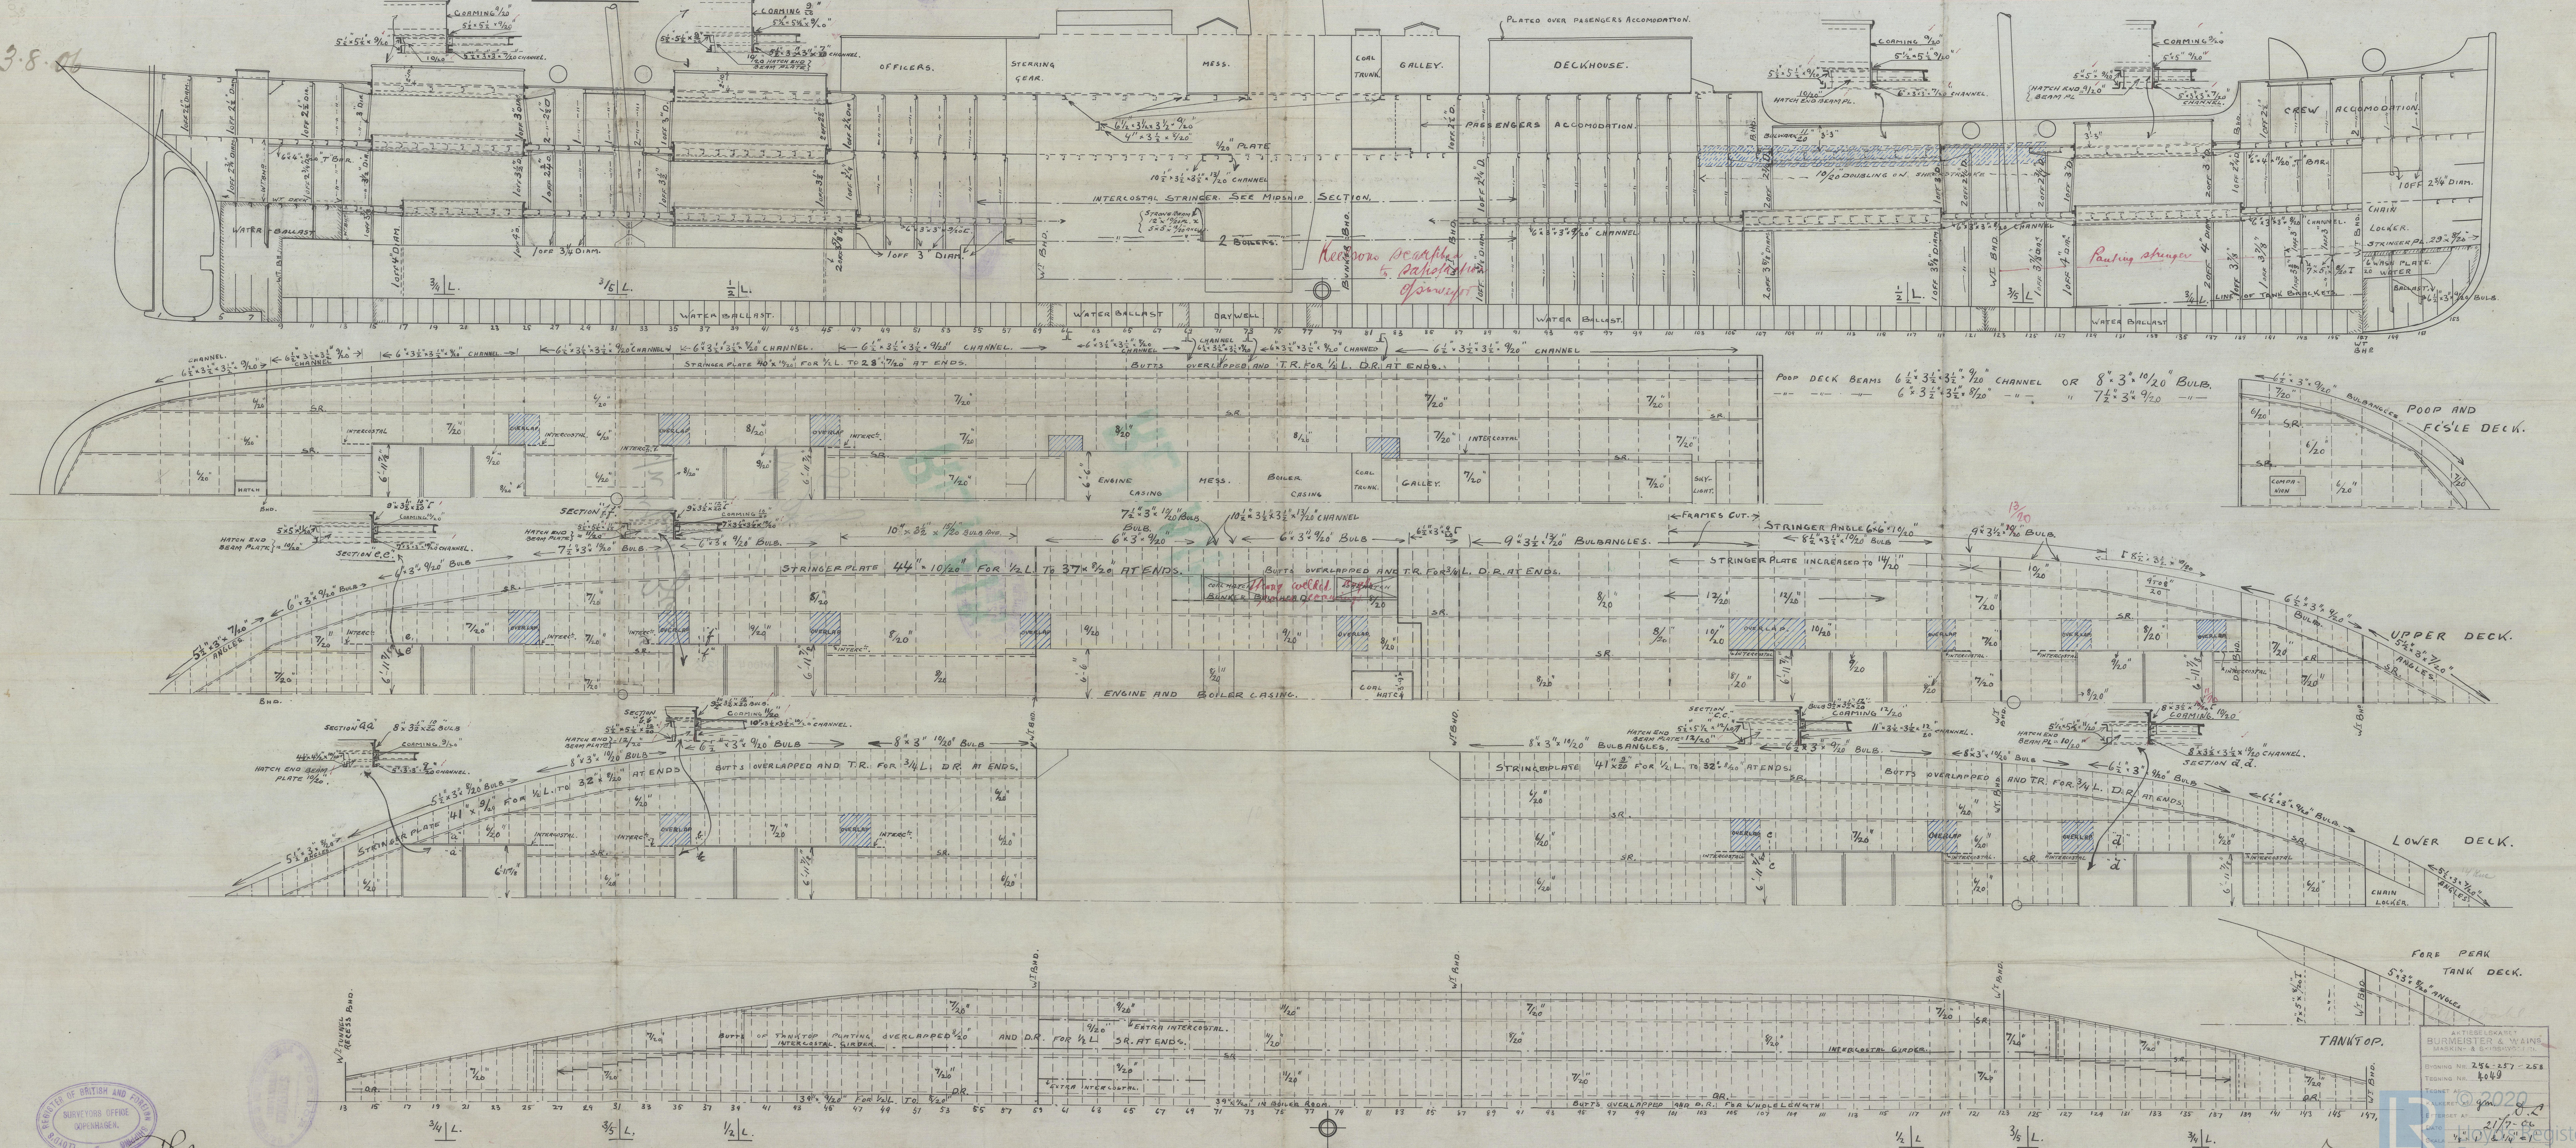

25/7-06
REGISTER OF BRITISH AND FOREIGN
SURVEYORS OFFICE
COPENHAGEN.
J.S.

ANTIEBLSKAST
BURMEISTER & WAIN.
TECHN. NR. 256-257-258
TECHN. NR. 4049
TAKET AT
KØBENHAVN
2/7-06
LLOYDS PROFILE

W1004-0133

52/1-000



[Handwritten signature]



W1004-0133



© 2020

Lloyd's Register
Foundation

256, 257 & 258.

n/n "Har Zion"

Mickera
St Jan

W1004-0133

Lloyd's Register
Foundation