

Lloyd's Register of British & Foreign Shipping.

SURVEYS FOR FREEBOARD.-STEAM SHIPS.

7315

23443

PARTICULARS RELATING TO ALL STEAM SHIPS EITHER FLUSH DECKED, OR WITH TOP GALLANT FORECASTLES, SHORT POOPS AND BRIDGE HOUSES DISCONNECTED, OR WITH TOP GALLANT FORECASTLES HAVING LONG POOPS, OR RAISED QUARTER DECKS CONNECTED WITH BRIDGE HOUSES, OR OTHERWISE.

Port of Survey Belfast
Date of Survey While building
Name of Surveyor J.M. Shewman

Complete shelter deck with fore and aft opening

Ship's Name Star of Victoria

Port of Registry and Nationality Belfast
British

Official Number 132046

Gross Tonnage 9152

Date of Build 1913

Particulars of Classification 100 A1 Contemplated, Shelter deck with freeboard

Number in Register Book 328

Registered dimensions from Ship's Register.	LENGTH.	BREADTH.	DEPTH.	Official Number.
	<u>501.35</u>	<u>63.35</u>	<u>33.68</u>	<u>132046</u>
Length on LOADLINE	<u>499.5</u>	Frame Depth <u>10</u> Rule <u>7</u>	Ceiling <u>82</u> Sheer <u>78</u>	Peak Tanks
CORRECTED DIMENSIONS.	<u>499.5</u>	<u>62.85</u>	<u>34.47</u>	<u>83352</u>

Moulded Depth as measured 36' 6"

NOTE.—If the depth is measured when vessel is afloat, the details of measurement should be reported.

Co-efficient of fineness 77.768
Any modification necessary [Para. 4 (a) to (e)] 02 Cell ovl bottom
Co-efficient as corrected 76.748

Sheer { Stem... 108 1/4 } 173 ÷ 2 = 86.5 Mean 89.54
at { Sternpost... 64 1/2 } 86.129.59
Sheer at 1/2 of the length from { Stem 61 1/2 } 98.5 ÷ 2 = 49.25 Mean 82
{ Sternpost 37 1/2 } 89.54
Gradual mean Sheer Allowed 89.54
Standard mean Sheer (Table, Para. 18) 59.95 Correction 7
Difference 29.6 ÷ 4 = 7.4
§ If limited as Para. 18 (f) 28.07
7.02

Rise in Sheer { At front of bridge house... ✓
from amidships { At after end of forecastle... ✓
[Para. 18 (e)]

Fall in sheer { 1/2 ÷ 2 = 1/4
Para. 18 (d) }
Length uncovered Shelter deck Correction ✓

ALLOWANCE FOR DECK ERECTIONS:—

Freeboard, Table C 6.11.10
Correction for Length, if required (Para. 12, 13, and 14) 9.6.08
Freeboard by Table A, corrected for sheer, and for length, if required (Para. 12, 13, and 14) 9.8.36
Difference 2.6.98
Percentage as below 2.8.57
94.5%
Correction for R. Q. Dk. if engine and boiler openings not covered by bridge house (Para. 11) 29.27
29.3
Allowance for Deck Erections 2.5 1/4
28.82

	Length.	Length allowed.	Height.
Forecastle.....	<u>332.80</u>	<u>332.80</u>	<u>8' 8"</u>
Bridge House.....	<u>4.66</u>	<u>2.33</u>	<u>8' 8"</u>
† Raised Q. Dk.....	<u>162.04</u>	<u>162.04</u>	<u>8' 8"</u>
Poop.....	<u>499.50</u>	<u>497.17</u>	<u>99.5%</u>
Total	<u>499.50</u>	<u>497.17</u>	<u>99.5%</u>
Length of Ship	<u>499.5</u>	<u>499.5</u>	
Corresponding percentage (Para. 11, 12, 13, or 14)	<u>= 94.5%</u>		

FREEBOARD recommended amidships from centre of Disc to top of Statutory Deck Line, Wood (Iron) Deck:—

Placement 20630 Fresh Water Line above centre of Disc
per inch 63 Indian Summer Line
30 ft. moulded draft Winter Line below
24.12.13 Winter North Atlantic Line

† If the frames, skin planking, or ceiling are of unusual thickness the breadth of vessel to inside of ceiling should be reported if possible.
† In vessels obtaining an allowance for deck erections under Para. 11 where the sheer drops abaft amidships the height of the R.Q.D. is to be taken from the level of the top of the amidship beam.
§ In flush-decked vessels the total standard mean sheer means the sheer measured at the stem and stern-post. In vessels having poops and forecastles, it means the sheer measured at points distant one-eighth of the vessel's length from stem and stern-post.

CORRECTION FOR LENGTH.
Length of Ship on Loadline... 499.5
Length in Table... 438.0
Difference... 61.5
Correction for 10ft., Table A... 1.7 Table C.
× Difference divided by 10... 10.45 (if required.)
If 1/10ths length covered divide by 2 5.22 = 5 1/4

CORRECTION FOR IRON DECK.
Proportion covered, if less than 1/10ths length covered Complete shelter all
Thickness of usual wood deck, less stringer... 3 1/2

CORRECTION FOR ROUND OF BEAM.
Breadth at Gunwale amidships... 62' 6"
Round of Beam... 15 1/2
Normal round... 15 1/8
Difference... 1/8 ÷ 2 = 1/16
Proportion of Deck uncovered (Para. 19) ✓

NOTE.—The round of beam should be reported on the full breadth of vessel at the gunwale.

Freeboard, Table A 10.1.10
Correction for Sheer 7.02
9.6.08
Correction for Length + 5.22
9.11.30
Allowance for Deck Erections 2.5.27
7.6.03
Correction for Round of Beam...
Correction for fall in Sheer (if any) ✓
Correction for Iron Deck (if required) 3 1/2
Additions for non-compliance with provisions of Para. 11 (d) and (e) 7.2 1/2
Other Corrections (if any) ✓

Winter Freeboard 7.2 1/2
Summer Freeboard 6.7 1/2
Indian Summer Freeboard 6.0 1/2
N. A. Winter Freeboard 6.0 1/2
Correction necessary because clearside amidships, measured in accordance with the Statute, is not taken at the intersection of the wood or iron deck with side. 1 3/4

Winter Freeboard from deck line 7.4 1/4
Summer " " " 6.9 1/4
Indian Summer " " " 6.2 1/4
N. A. Winter, " " " 6.0 1/2

Amended Tables
March 1906
6.9" 6.9 1/4
8 1/4 8 1/4
7 7
7 7

† State dimensions of freeing port area on back of this form.
‡ The Surveyor should state whether the fall in sheer as reported is measured relatively to the straight line of keel or to the water line. If measured relatively to water line the vessel's draft at time of survey, and also the usual load draft forward and aft, should be reported.

3 Vhs BRS 13/12/13

Copy to BRS 13/12/13

RECEIVED 8/1/14
21.7.22

Do all the Frames extend to the top height in the Poop? *Yes* Raised Quarter Deck? *✓* Bridge House? *Yes* Forecastle? *✓*
 To what height do the Reverse Frames extend? *Deep Channel frames to Gunwale with reverse bar 6' main*
 Has the Poop or Raised Quarter Deck an efficient Iron Bulkhead at the fore end? *Yes*
 Give particulars of the means for closing the openings in Bulkhead *will be closed as per sketch enclosed Portable plates class B*
 Is the Poop or Raised Quarter Deck connected with the Bridge House? *Yes* Has the Bridge House an efficient Bulkhead at the fore end? *✓*
 Give particulars of the means for closing the openings in Bulkhead *✓*
 What is the thickness of the Bridge Front plating? *✓* and Coaming plate? *✓*
 Give scantlings and spacing of the Stiffeners *✓*
 Are bracket plates fitted at each end of the Stiffeners? *✓* Are hor'l. brackets fitted connecting Bridge Bulk'd. with Bulwarks? *✓*
 Has the Bridge House an efficient Iron Bulkhead at the after end? *Yes*
 How are the openings closed? *will be closed as per sketch enclosed Portable plates class B*
 Is the Forecastle at least as high as the main or top-gallant rail? *Yes* Has the Forecastle an efficient Iron or Wood Bulk'd. at after end? *✓*
 Are the Engine and Boiler openings covered by a Bridge, Poop, Raised Quarter Deck, or enclosed by a Strong Iron or Steel Deckhouse? *Shelter deck*
 If the openings are not so protected are the exposed parts of the Casings efficiently constructed? *✓*
 Give thickness of plating; scantlings and spacing of Stiffeners *✓*
 What is the height of the exposed Casings? *✓* Are suitable means provided for closing all openings in them in bad weather? *Yes*
 Are the Weather Deck Hatchways efficiently constructed and at least equal to the requirements of Section 28 of the Rules for 1904-5? Give particulars below:— *Yes*

Position and Size.	19'6" x 18'6" (No 1)		25'8" x 18'6" (No 2)		16'4" x 18'6" (No 3)		23'4" x 18'6" (No 4)		18'8" x 18'6" (No 5)
Item.	Ship.	Rule.	Ship.	Rule.	Ship.	Rule.	Ship.	Rule.	Ship.
COAMING. Height above top of DECK	30"	18	30	18	30	18	30	18	30
Thickness	Sides.....	.44	.44	.44	.44	.44	.44	.44	.44
	Ends.....	.40	.40	.40	.40	.40	.40	.40	.40
SHIFTING BEAMS OR WEB PLATES.	Number	1 web + 3 T beams.	2 webs + 3 beams		1 web + 2 beams		2 webs + 3 beams		2 webs + 3 beams
	Section and Scantlings.....	24 x .40	24 x .40		24 x .40		24 x .40		24 x .40
	Material.....	11 x .55	12 x .55		12 x .55		11 x .55		10 x .55
FORE AND AFTERS.	Number.....								
	Section and Scantlings.....	no	fore and afters						
	Material.....								
HATCHES Thickness	3"		3"		3"		3"		3"
Remarks.....									

* When the Fore and Afters are of wood the depth should be stated from the underside of the hatches.
 (If the sill of the lowest side scuttle will be less than 6 inches above the Indian Summer Load Line if assigned under the tables, state vertical distance from top of deck at side amidships to lower edge of lowest side scuttle.)

The following information is to be given in all Cases of vessels dealt with under Paras. 11, 12 (under 15 feet Moulded depth) and under Shelter Deck Rule

What is the thickness of the Bridge Sheerstrake? *.92* Strake between Main and Bridge Sheerstakes? *.82*

Delete the words { The Crew are, are not, berthed in the bridge house.
 that do not apply { The arrangements to enable them to get backwards and forwards from their quarters are, are not satisfactory.

Length of Bulwarks in well

Area of Freeing Ports required by Para. 11 (e) each side of vessel =

Sq. ft.

Ft. Tenths. Ft. Tenths. No.



x x
x x

Freeing Ports
(each side of vessel)

Sq. ft.

Total deficiency or excess =

Sq. ft.

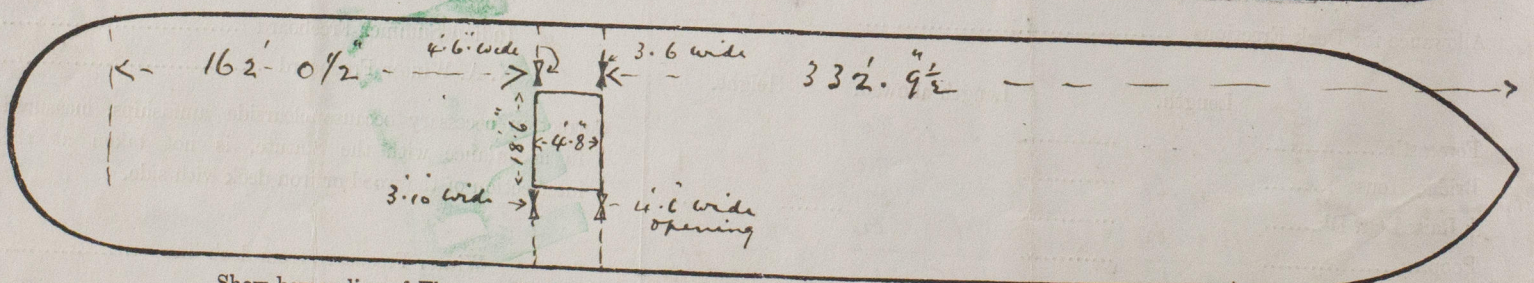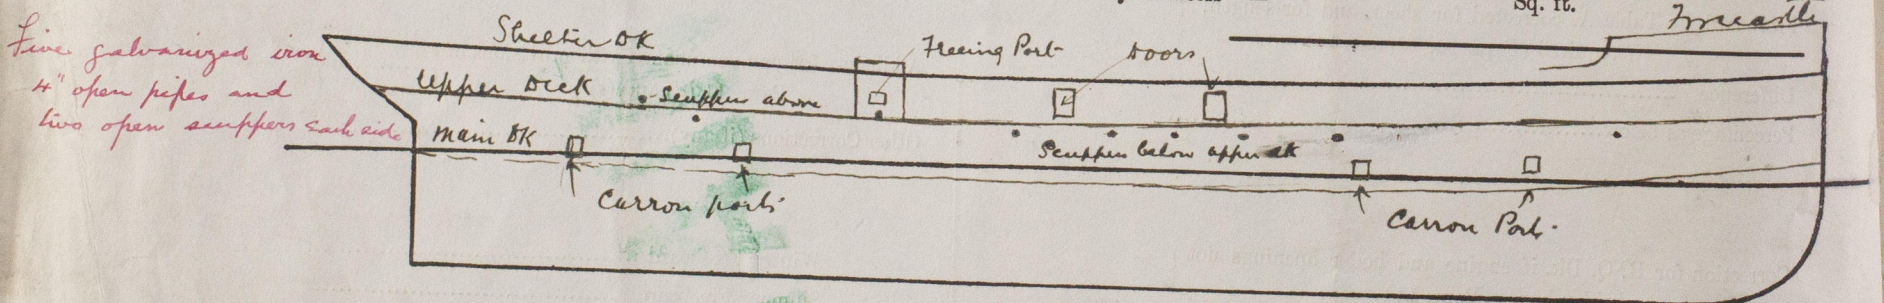

Show hereon line of Floors or Tank Top with position of any Breaks in same; also height of Peak Tank tops, &c., &c.

State any special features in the construction of the Vessel

= 8 1/4"

Owners

Address

Fee £

Received by me



© 2019

Lloyd's Register
Foundation