


24. 5. 12
8. 6. 12
3. 7. 12
23. 8. 12
18 9. 12 (11-329)
24. 12. 12
9. 1. 13
24. 4. 13

— To Class 100.A.1. Lloyds (Shelter Dk) —

— Scale $\frac{1}{2}'' = \text{One Foot.}$ —

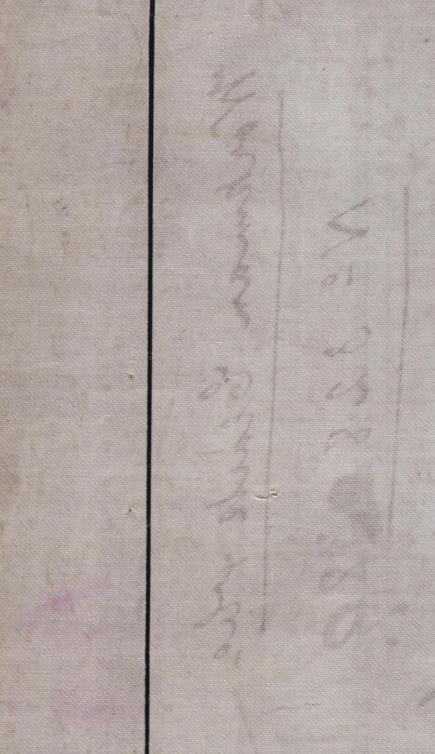

62 x 66 x 95

11 x 45 BULB.

C.B.

29.5.12.

8.6.12.




12


©

W1005-0079

Workman Clark & Co.

N^o 328 329.

Amended Midship Section

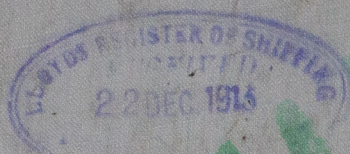

255. Star of Victoria N^o 328

255 Star of England N^o 329

PORT MELBOURNE



© 2019

Lloyd's Register
Foundation

W1005-10079