7459

9/7/15

NORTH EASTERN MARINE ENGINEERING
DRAWING OFFICE
8 - JUL 1915
WALLSEND

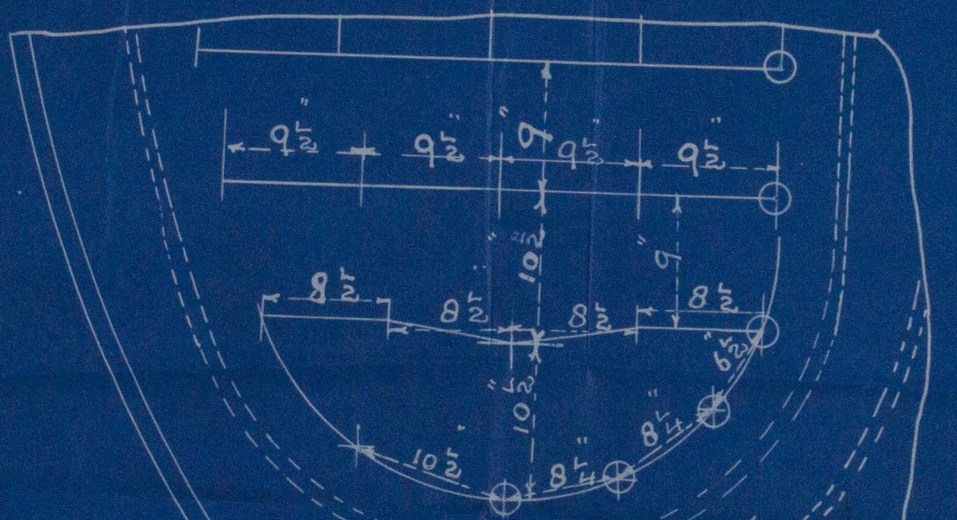

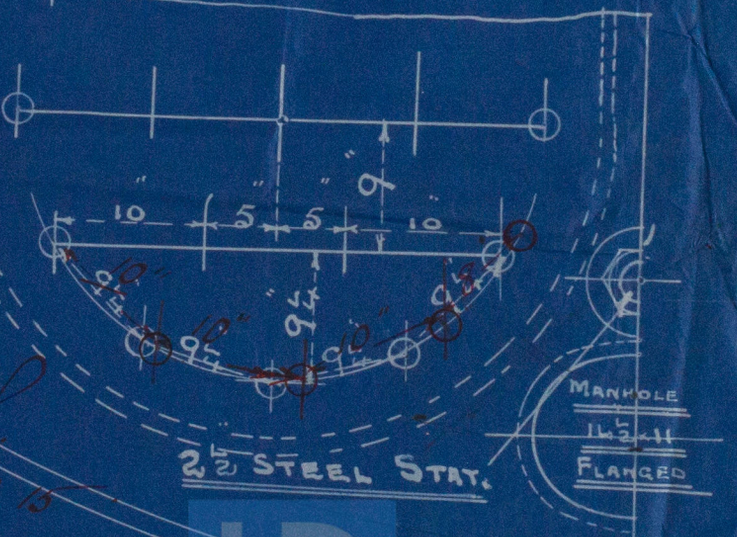

A.R.S. T.H. 9.7.15

CONTRACT. 2241. 2244. 2245.

Lloyds