

PROFILE & DECK PLAN


STEEL SCREW TRAWLER

Nº 523

DIMS. 120'-0" x 21'-6" EX. x 12'-6" MLD.

SCALE $\frac{1}{4}" =$ ONE FOOT.

PLAN No. 1042
FOR ENCLOSURE TO
Messrs Lloyd's Surveyors
Gull FROM
COCHRANE & SONS,
SHIPBUILDERS, SELBY
DATE December 15th 1911 RK

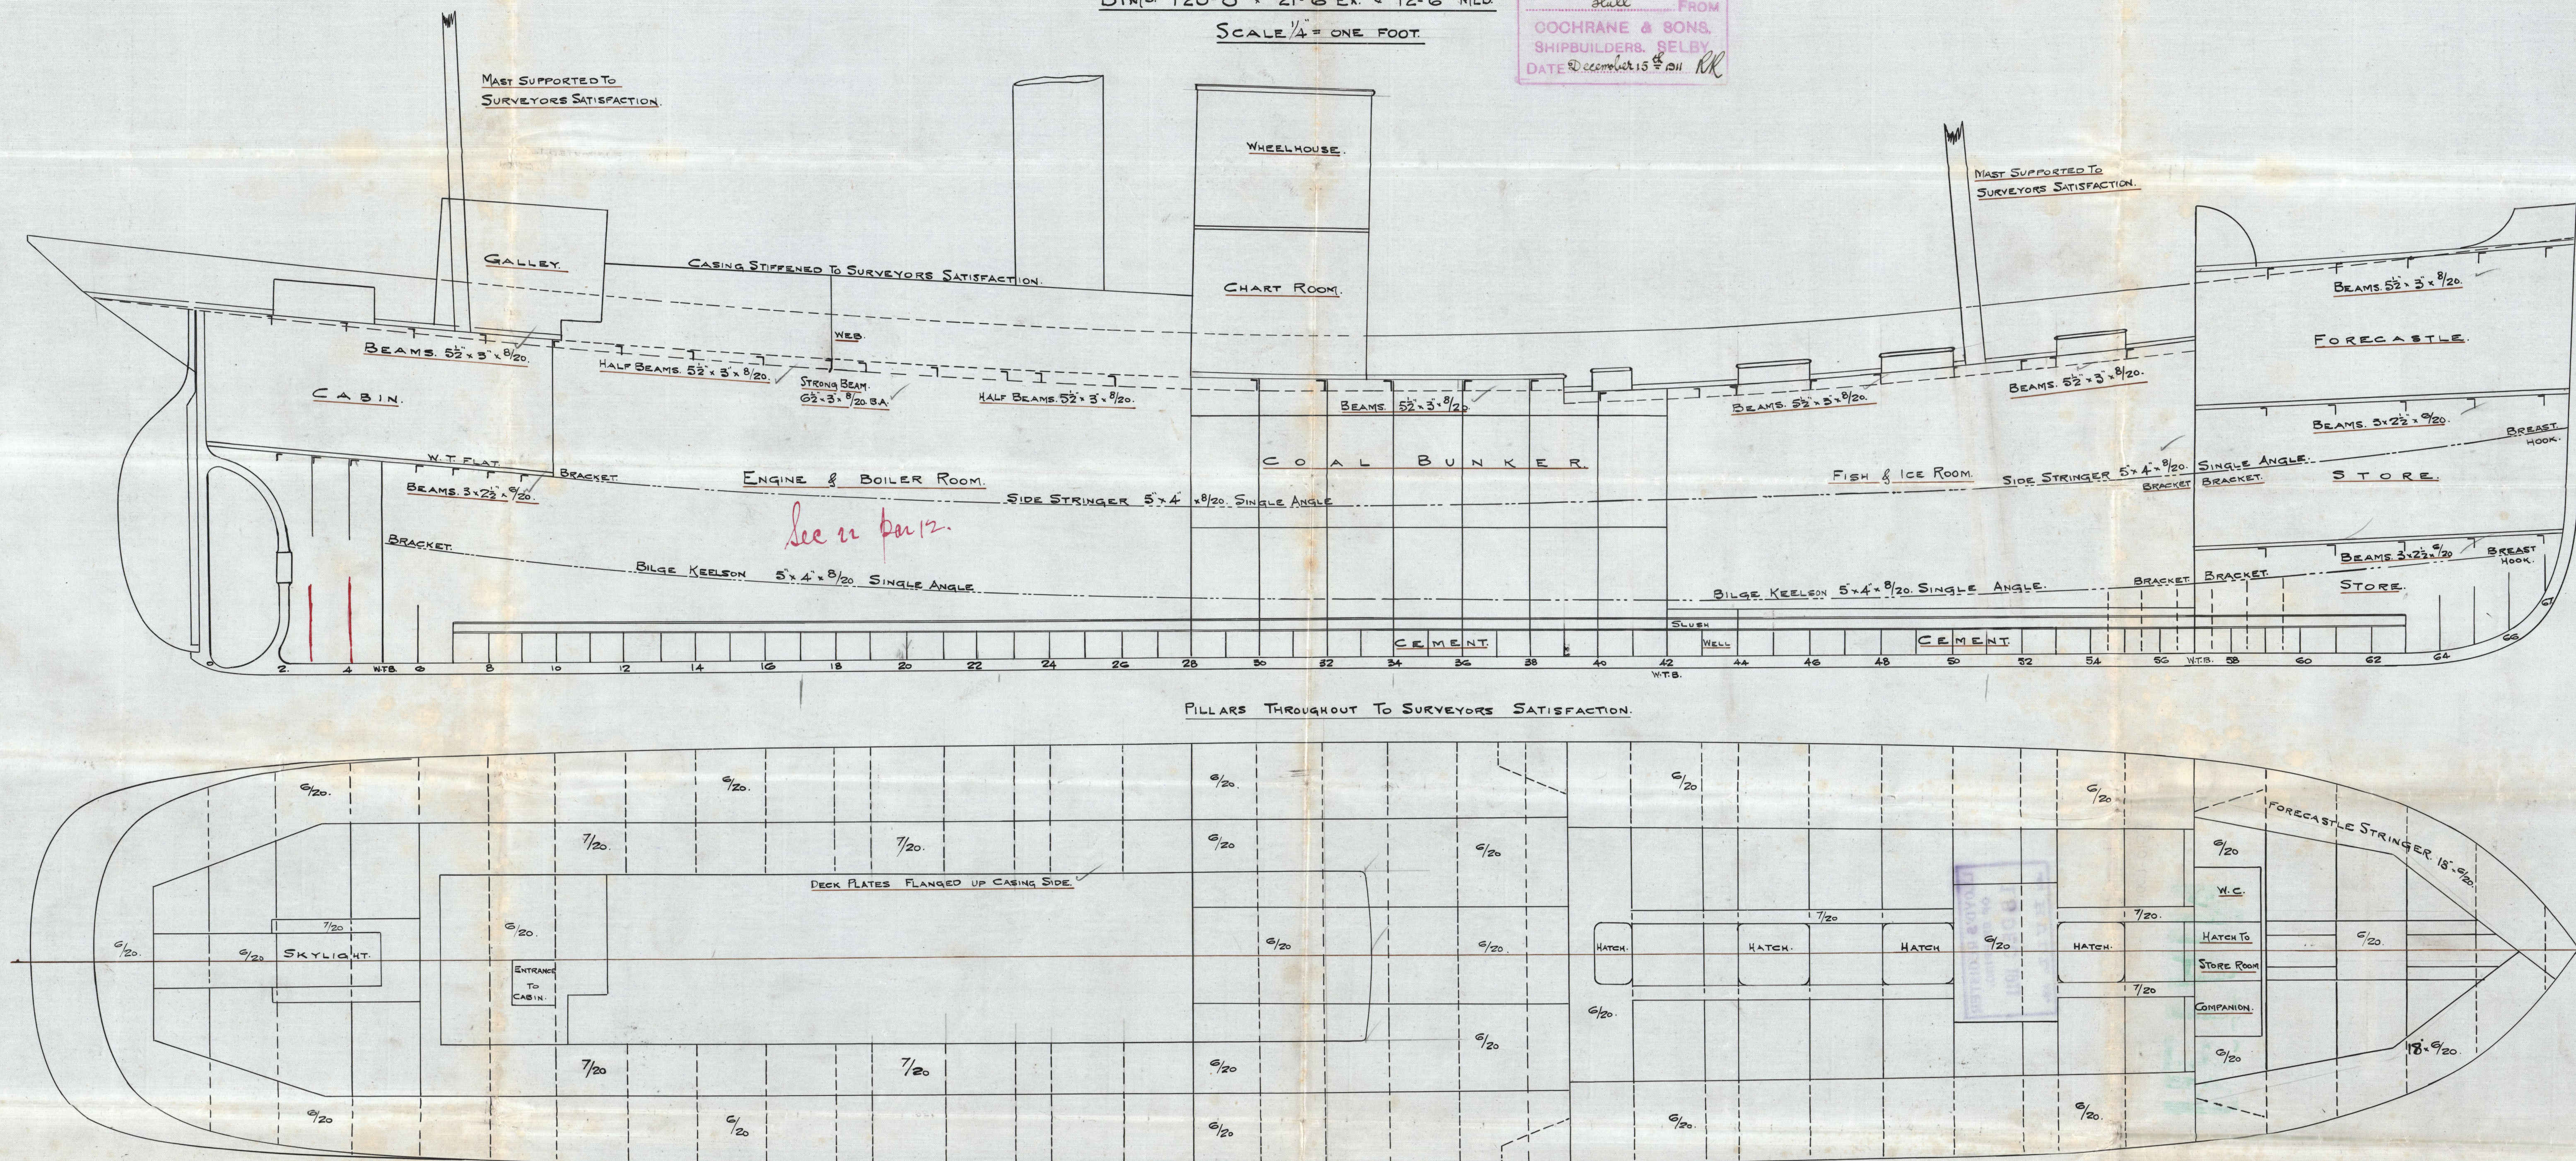

C. f.
19.12.11

with P marked
E 85 on
and also A have identified

Cochrane & Sons
No 523.
Profile and Deck Plan

1/2 Cyelose Hull Rpt No 25107.

