



Verification Report

No 1207

16698

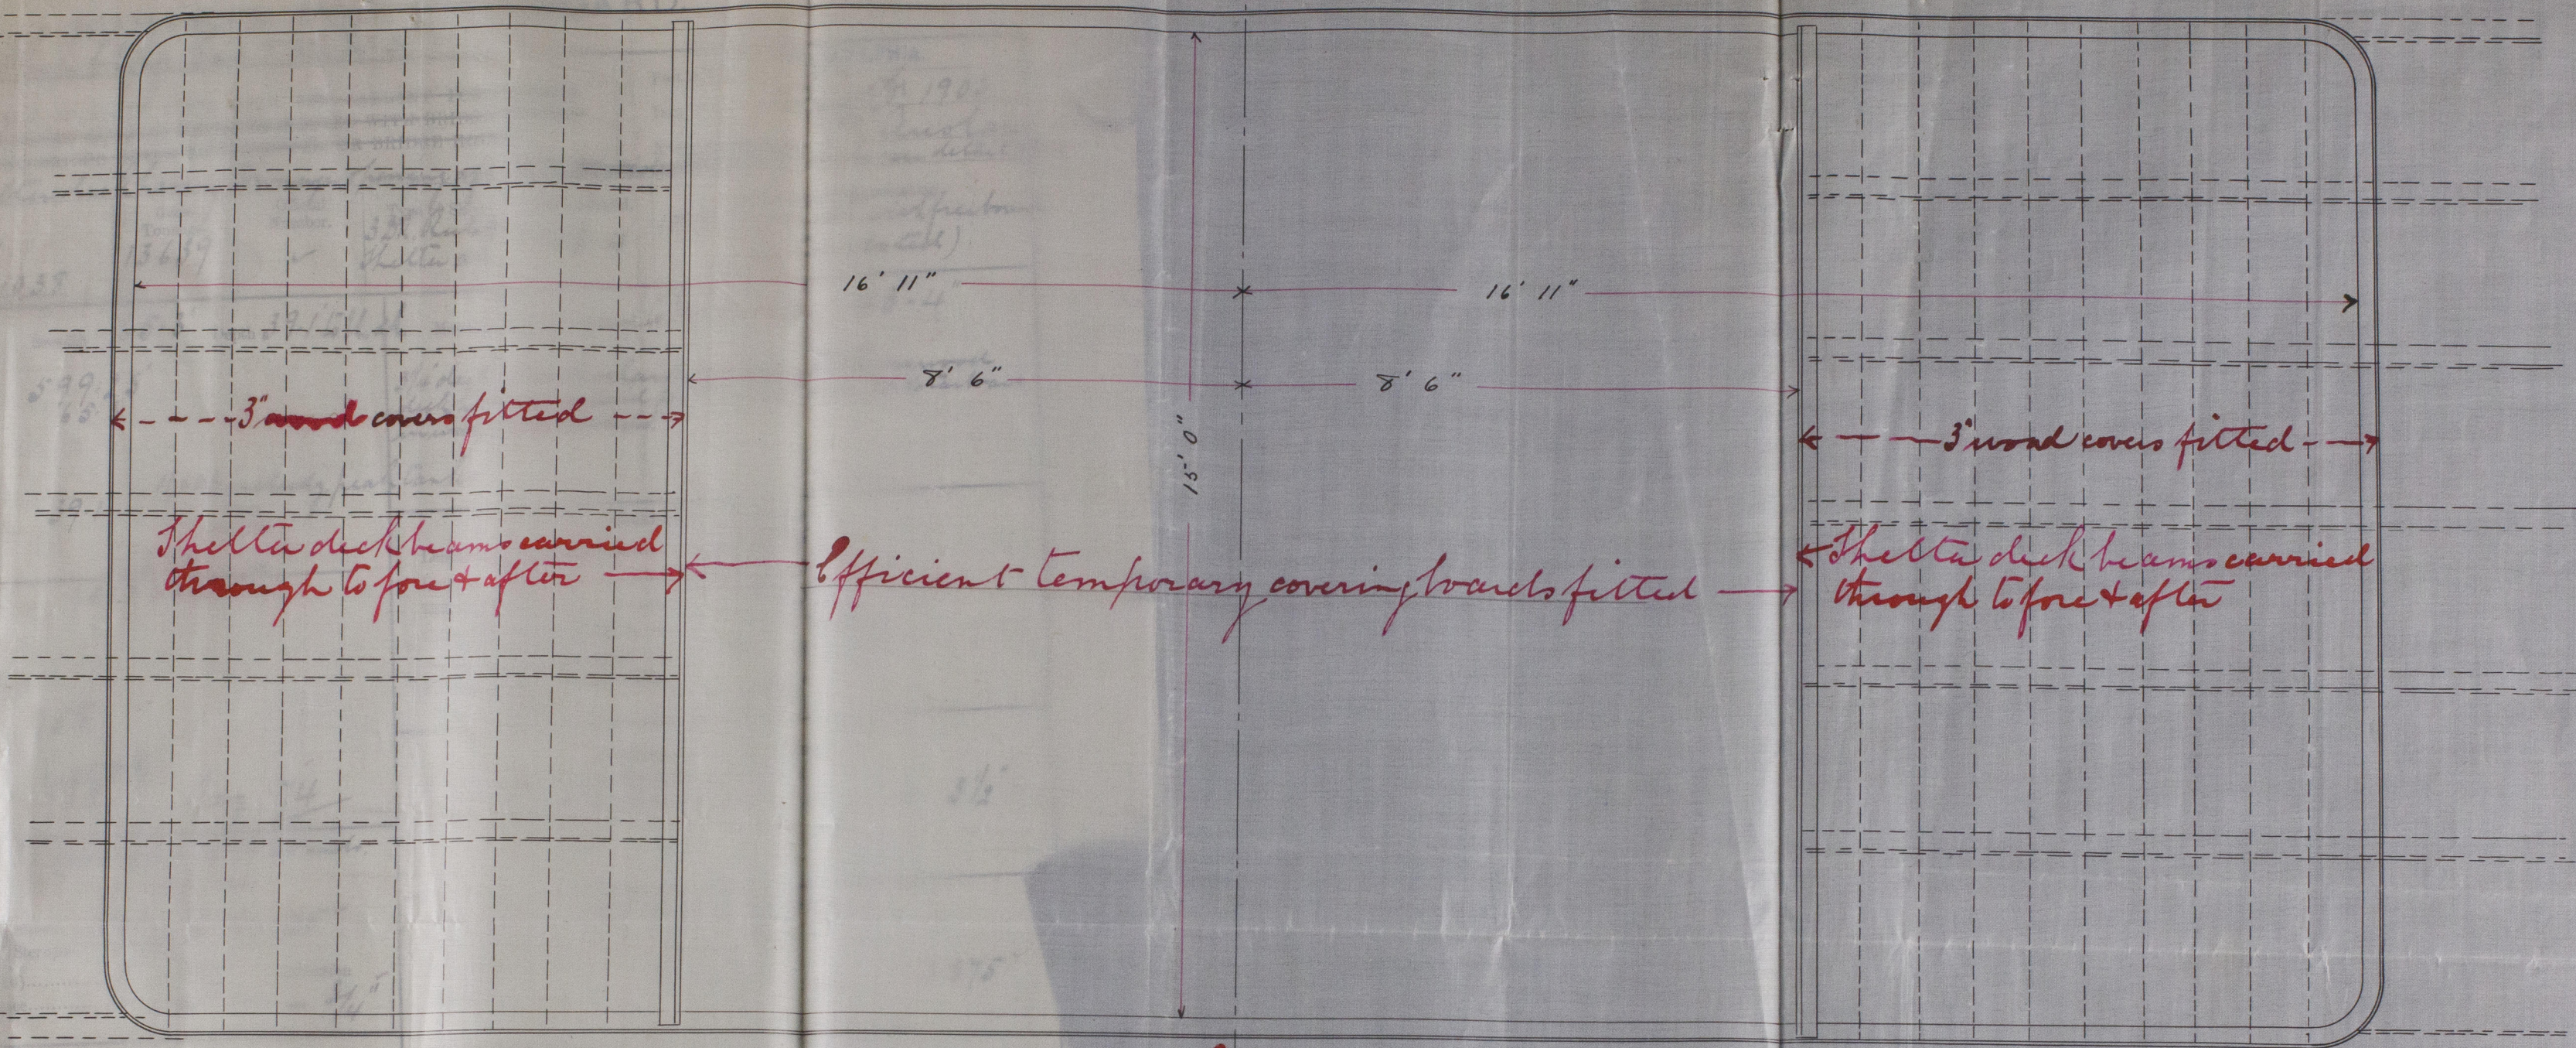

AFT.

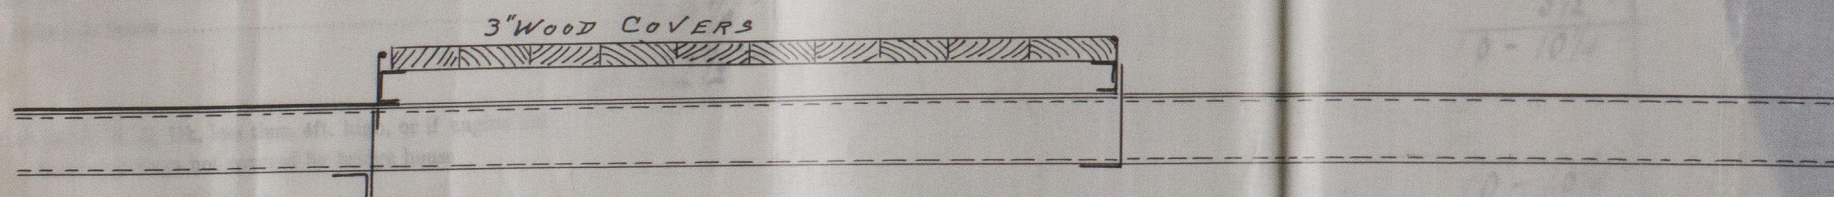

T.S.S. MONGOLIA. HULL No 5.
TONNAGE OPENING FOR
FREEBOARD
SCALE $\frac{1}{2}$ = 1 FT DATE OCT. 19.03
MADE BY No 372 TRACED BY No 372 CHECKED BY No 372
NEW YORK SHIPBUILDING COMPANY
CAMDEN NEW JERSEY U.S.A.

Lloyd's Register
Foundation

H. J. B. Co.
No. 5

Detail of Tonnage
opening.

19/10/03

W1008-8001M

TRA

[Faint, illegible handwriting]

2.2" 2.2" 11.21" 11.21"



© 2019
Lloyd's Register
Foundation

[Handwritten signature]