


DR. 5-6/21-10
N. Y. BUILDING CO.
Feb 5 1899

For McQuinn

5-7-12
OK 2m

Returned to Library
APR 28 1902

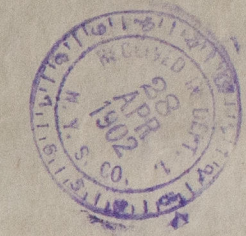


Section S/s two 5. 6 7 + 8
Juyst Co

N - [Signature]


W1008-0054

Philadelphia

W1008-0054

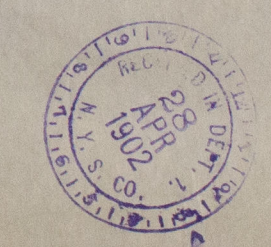

W1008-0054

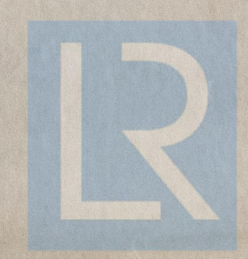

W1008-0054



New York I. B. Co.
I. I. No. 546.


Revised Midskip
Section embodying
modifications

5/5/02

W. J. has copy in N. Y.
"MONGOLIA"

REPORT No 1234


W1008-0054

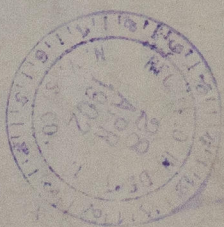

W1008-0054



n/m Panamanian

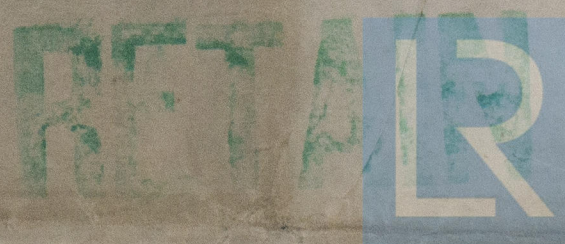

© 2019

Lloyd's Register
Foundation