


CAMDEN. PHILADELPHIA.  
U.S.A.

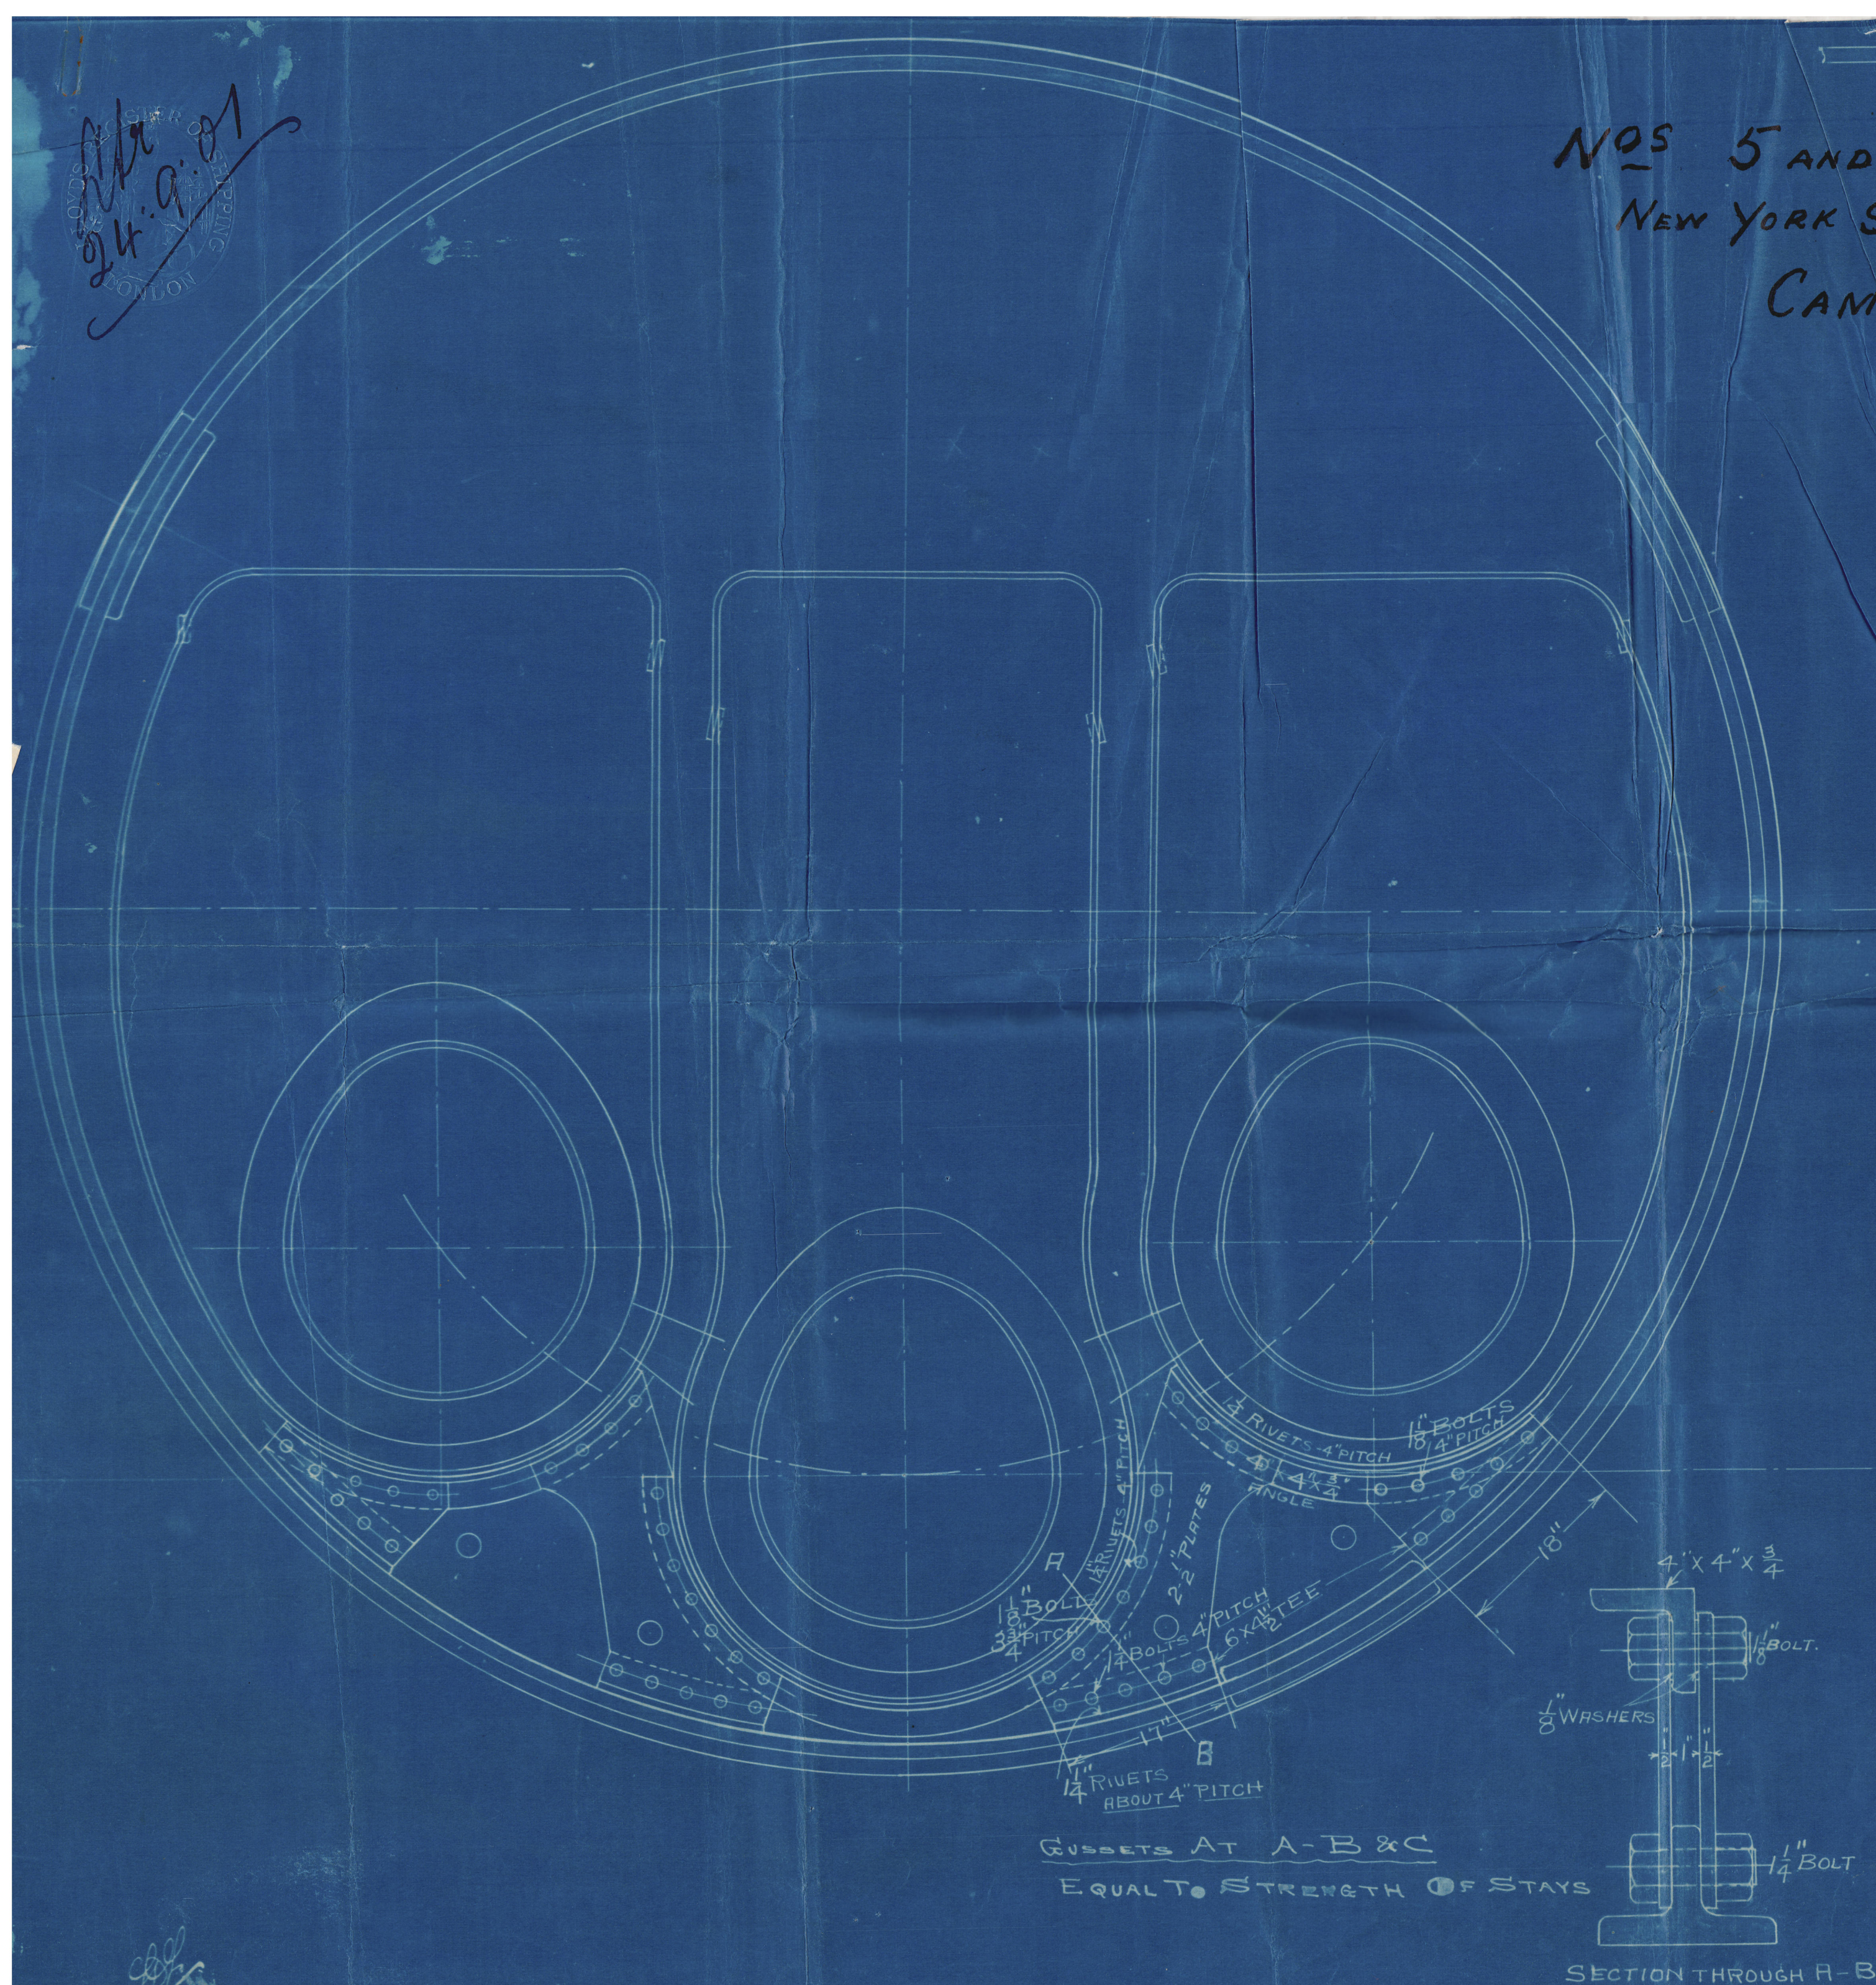


## ARRANGEMENT



Philadelphia  
New York S B &

Boiler Stamps  
105-6

W1008-0057

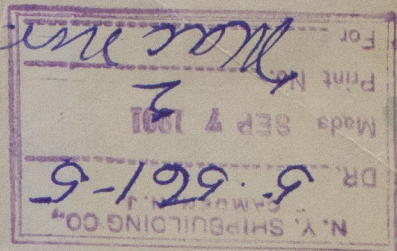

7.18  



© 2019

Lloyd's Register  
Foundation