




A. PLATING AT BILGE
 14'-6" LONG X 8'-1" FOR END
 8'-6" AFT END.
 B. PATCH UNDER NO 1
 TANK 8'-7" LONG X 7'-1"
 FOR END 8'-9" AFT END
 C. PLATING AT BILGE
 61'-2" LONG.
 D. PATCH 3'-0" X 5'-0"
 AT BILGE.
 E. DAMAGED BILGE KEEL
 CUT AWAY & BILGE &
 TANK CEMENTED

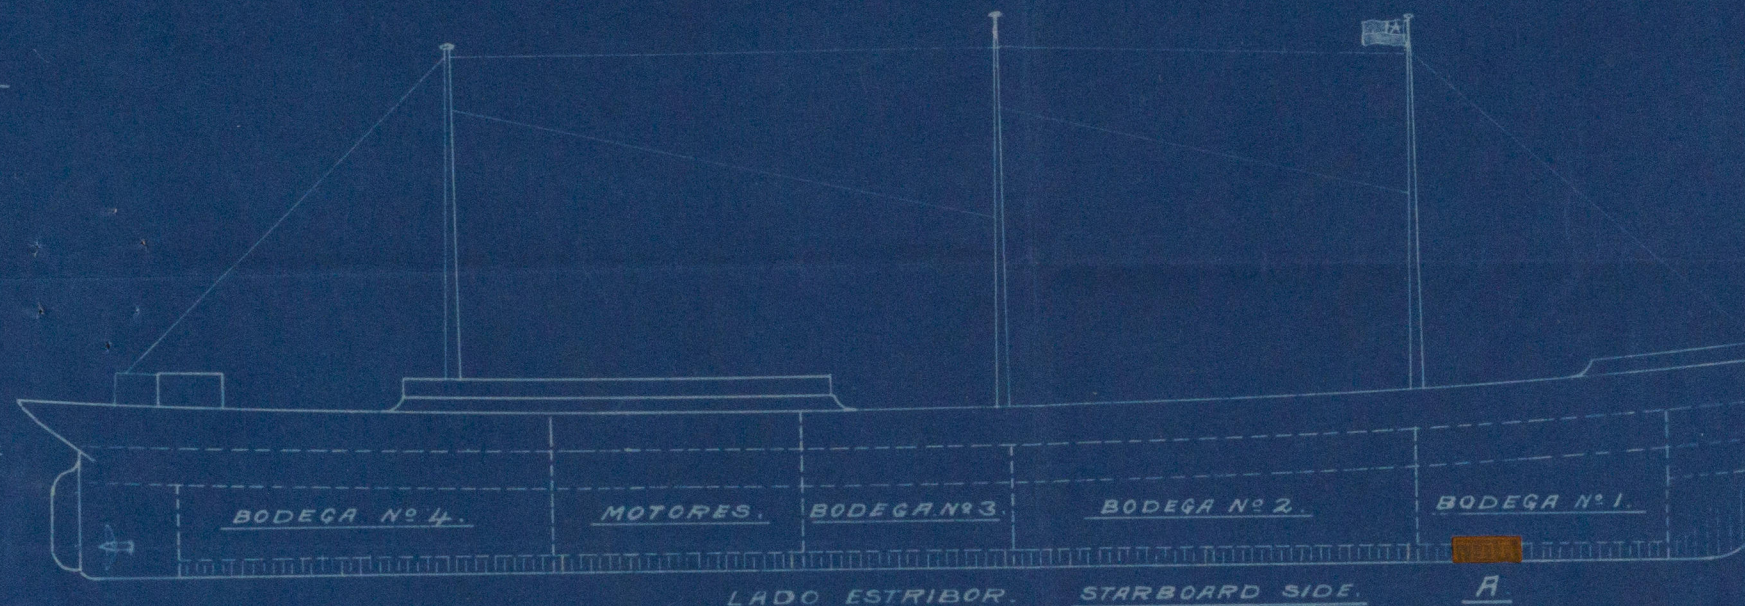

LADO ESTIBOR. STARBOARD SIDE. A

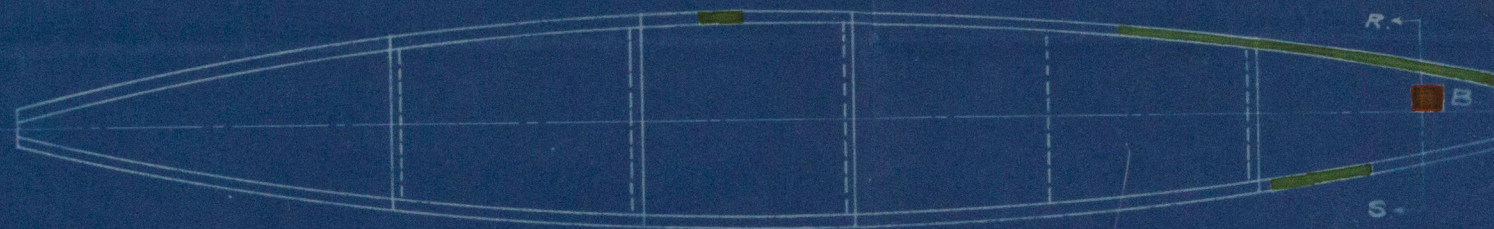

PLANO DE LAS BODEGAS. PLAN OF HOLDS.

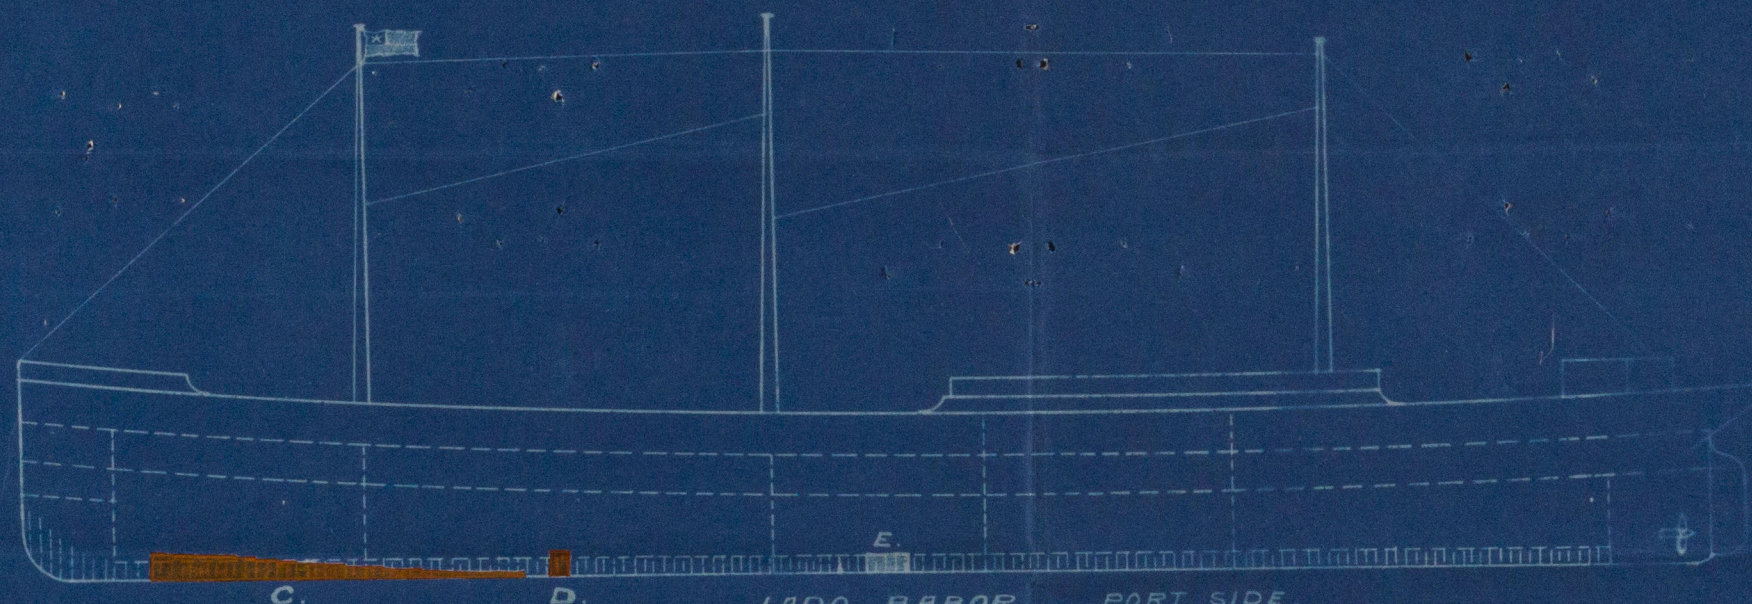

LADO BABOR. PORT SIDE. E

PLATES & PATCHES SHOWN THUS
 LAS PLANCHAS Y PARCHES SON INDICADOS ASI
 LAS CENTINAS LLENO CON CIMIENTO SON
 INDICADAS ASI

BILGES FILLED WITH CONCRETE SHOWN THUS.

M. V. "LIMA"

CROQUIS, SIN ESCALA.

NOT TO SCALE.



ENLARGED SECTION

AT R. S.

LR

SANTA ARENAS

2-1-22.

2-1-22