




SS N° 1289.
PROFILE & DECK S.

SCALE 1/8" = ONE FOOT.
DIMENSIONS 248' 0" B.P. x 37' 0" B.M. x 22' 0" U.M. TO UPPER DECK. 16' 8" to 2nd Deck.


TO CLASS LLOYDS 100 A1 WITH FREEBOARD corresponding to a draught not exceeding that contemplated by the Rules for a complete superstructure ship having a tonnage of 1500.
DRAFT 15' 10 1/2" N° 42

Plans of Hatch End Beams, Pillars & Bulkheads
To be submitted later.

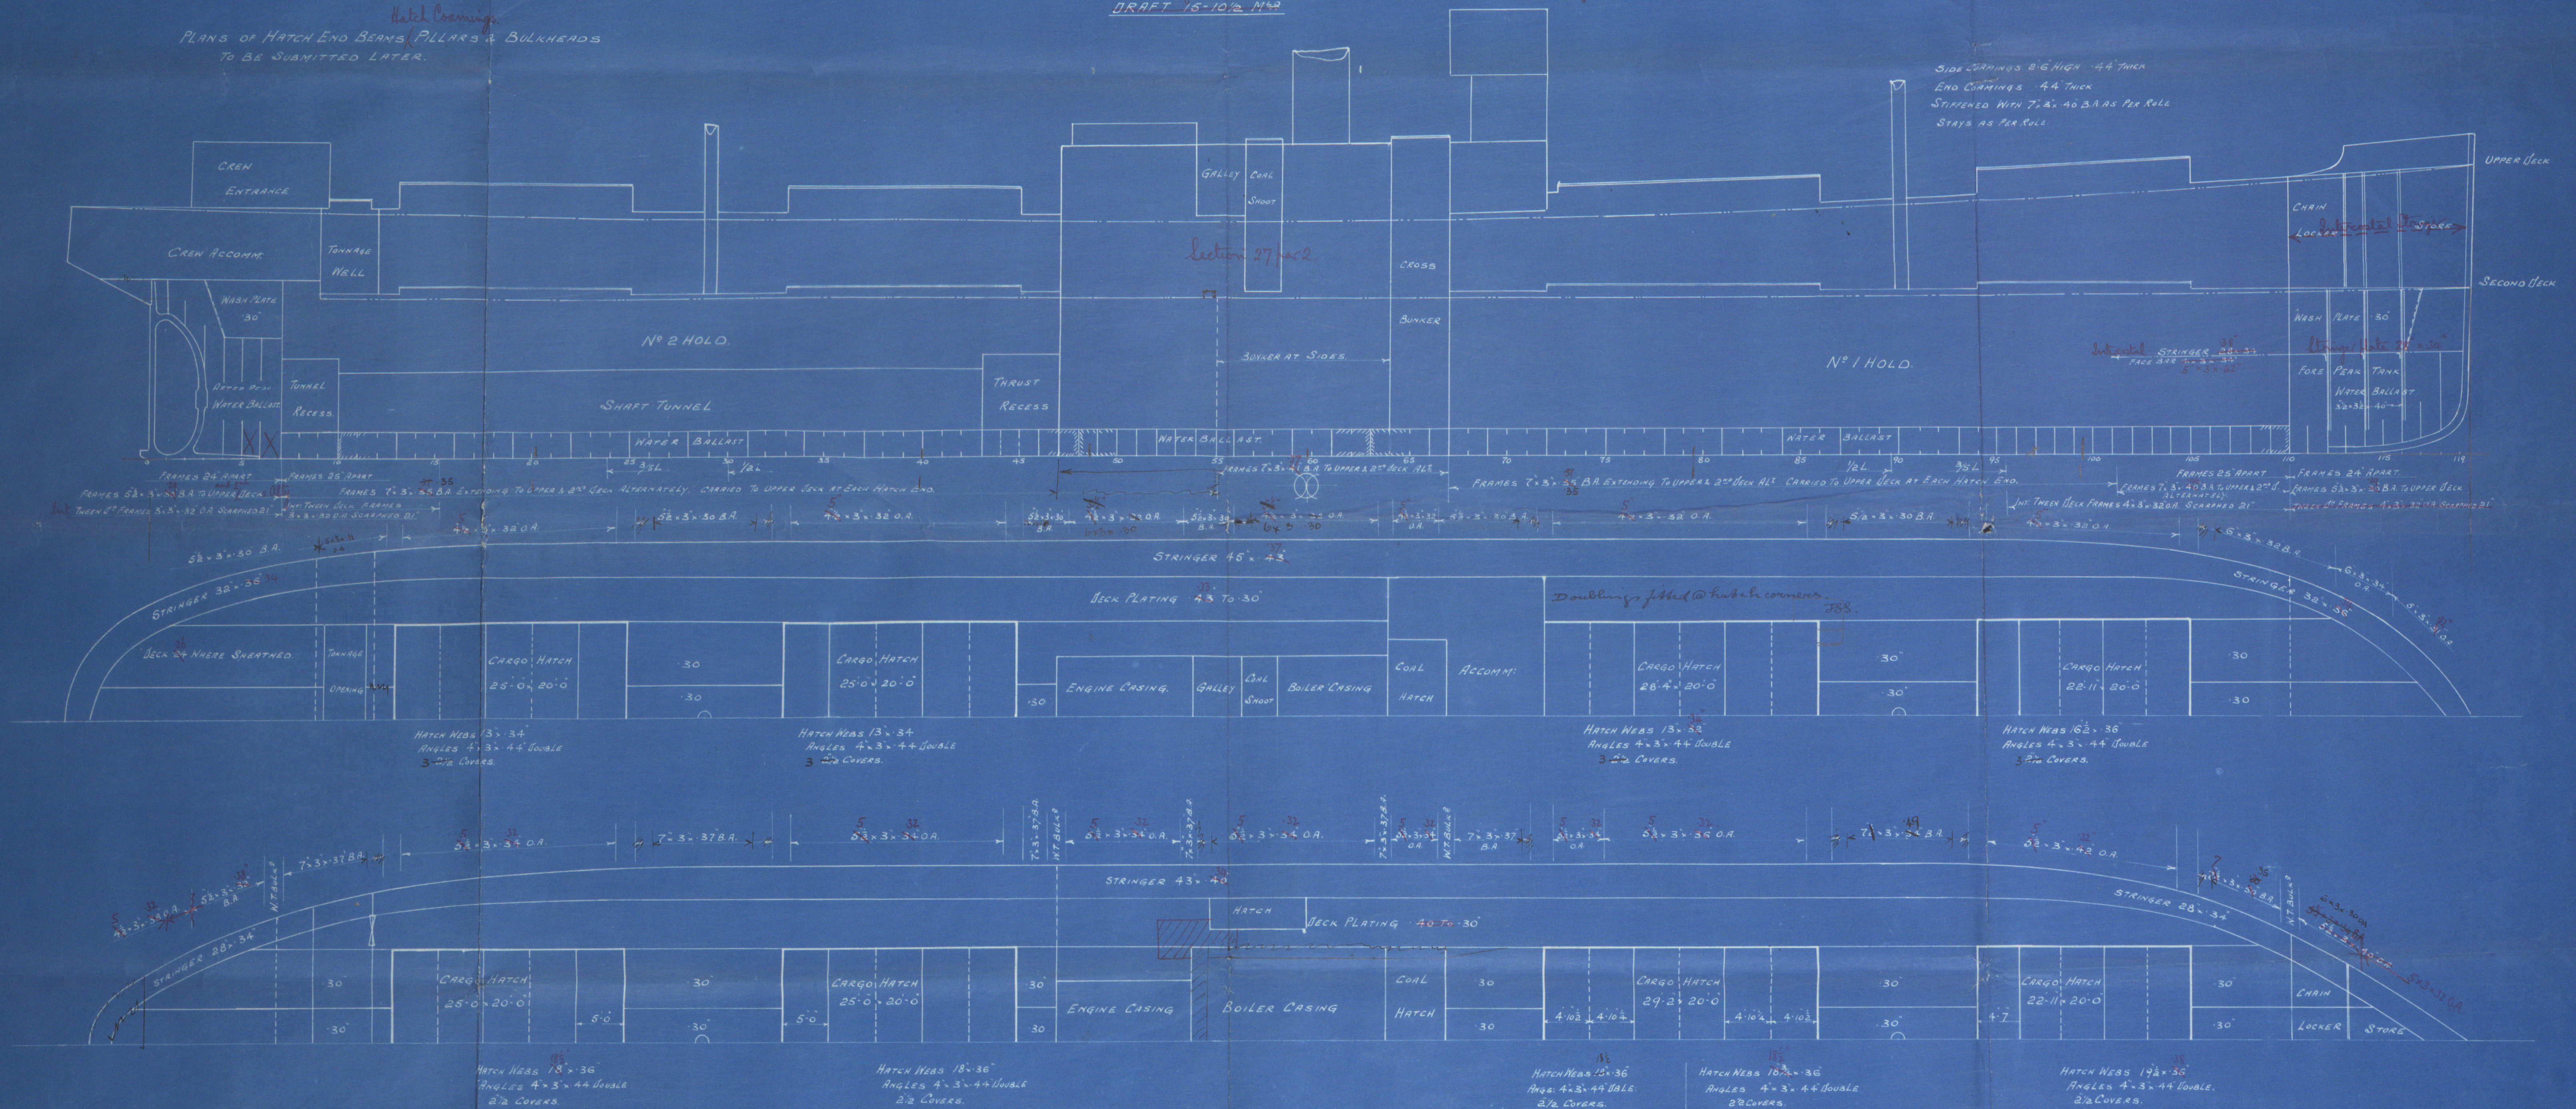

SIDE CHAMBERS 8' 6" HIGH 4' 4" THICK
END CHAMBERS 4' 4" THICK
STIFFENED WITH 7' 8" 40 B.A.S PER RULE
STAYS AS PER RULE

30.11.25

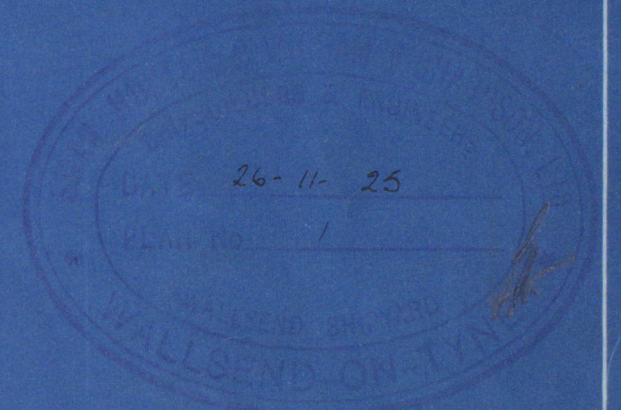

(2)

Swan & Hunter.

no. 1289

Profile & decks

"Liverpool Packet"
ex

S. S. NIDARNES.

NEWCASTLE ON TYNE.

Report No. 80681

W101 - 0194



© 2019

Lloyd's Register
Foundation