

— N^{OS}. 442-X-X&S. —

— MIDSHIP SECTION. —

— DIMENSIONS - 400'x52'-0"x31'-0" M^{LD}. —

— SCALE $\frac{1}{2}$ " = ONE FOOT. —

— TO CLASS, 100 A.I. LLOYDS. —

— NUMERALS —

B + D = 52 + 31 = 83 = TRANSVERSE N^O.

L x (B + D) = 400 x 83 = 33200 = LONGITUDINAL N^O.

POOP BRIDGE & FCLE = 200 x 8 x 75 = 1200



DECKHOUSE = 31'5" x 8 x 75 = 189.

34585 = EQUIPMENT N^O.

L TO UPPER DK = 12'90"

L TO BRIDGE DK = 10'20"

D = 18'4"

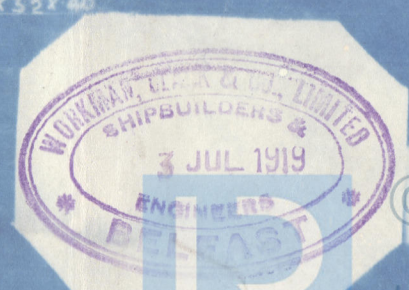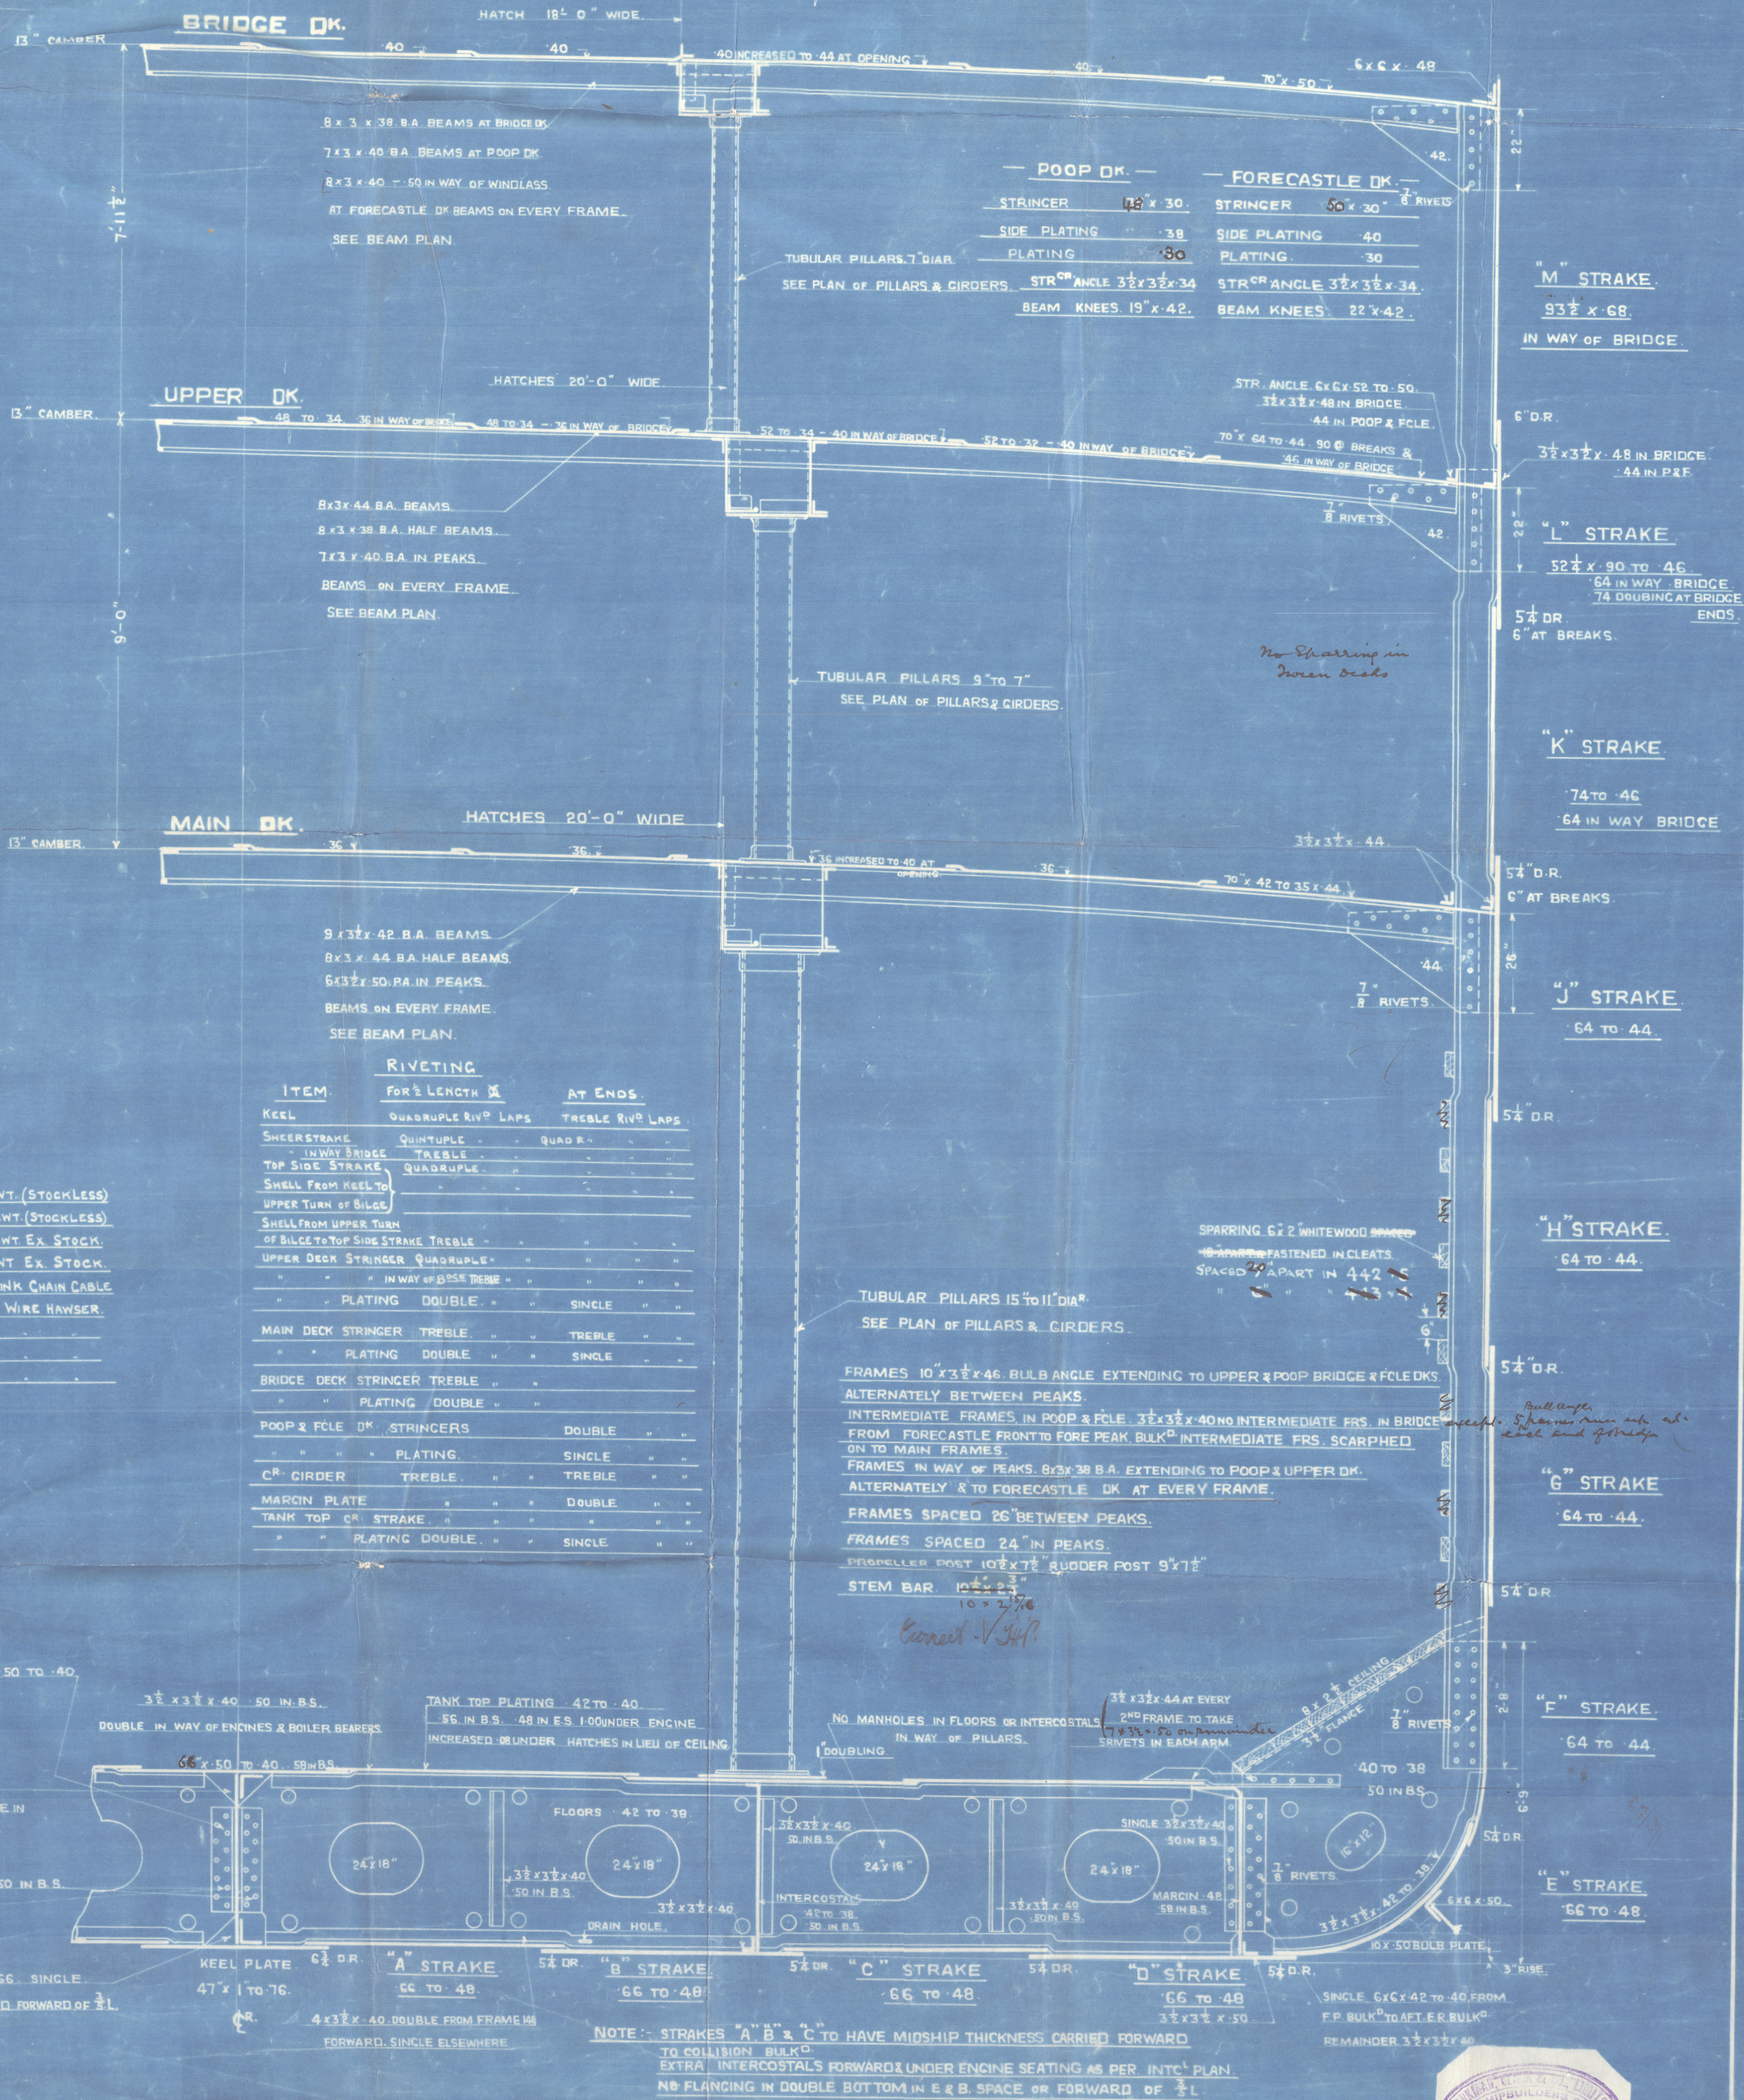


Midship Section

SS Ballygally Head ^{now} Tombouctou

Messrs Workman Clark & Co. No. 442

203.

"ⁿ Ispahan"

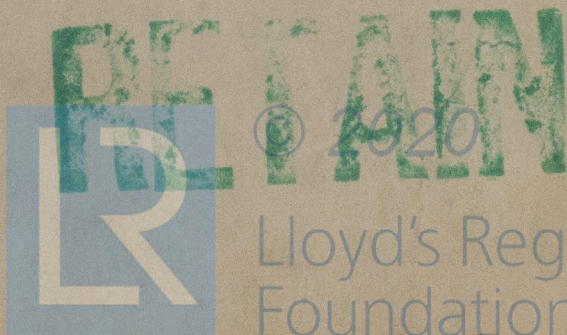

© 2020

Lloyd's Register
Foundation

W1010-0055