

14.7.14



Nº623

PROFILE & DECK PLAN.

DIMS. 133' 4" B.P. x 23' 0" E.L. x 13' 1" M.L.

SCALE 1/4 INCH.

PLAN No. 4517.  
FOR ENCLOSURE TO  
MESSRS LLOYD'S SURVEYOR  
HULL FROM  
DATE 8.7.14.

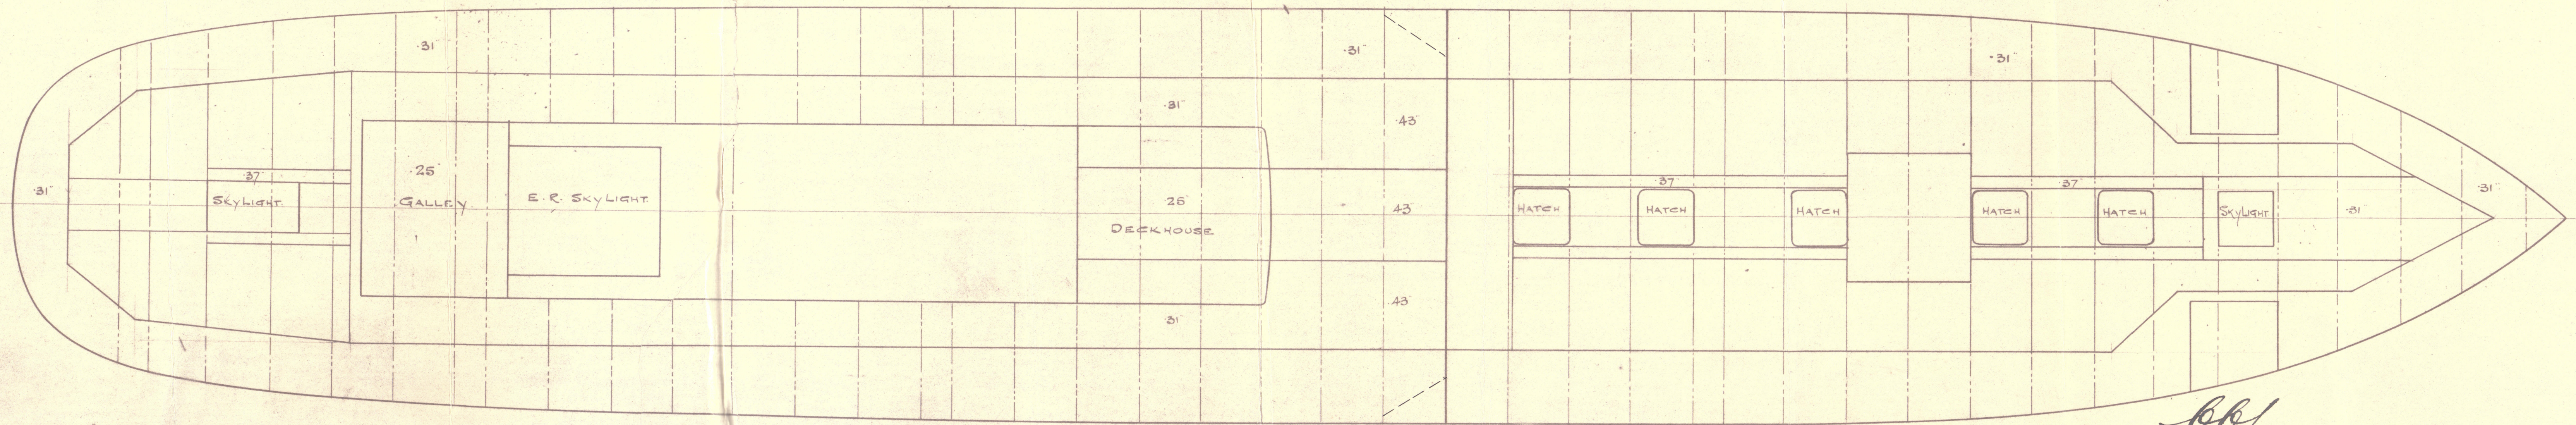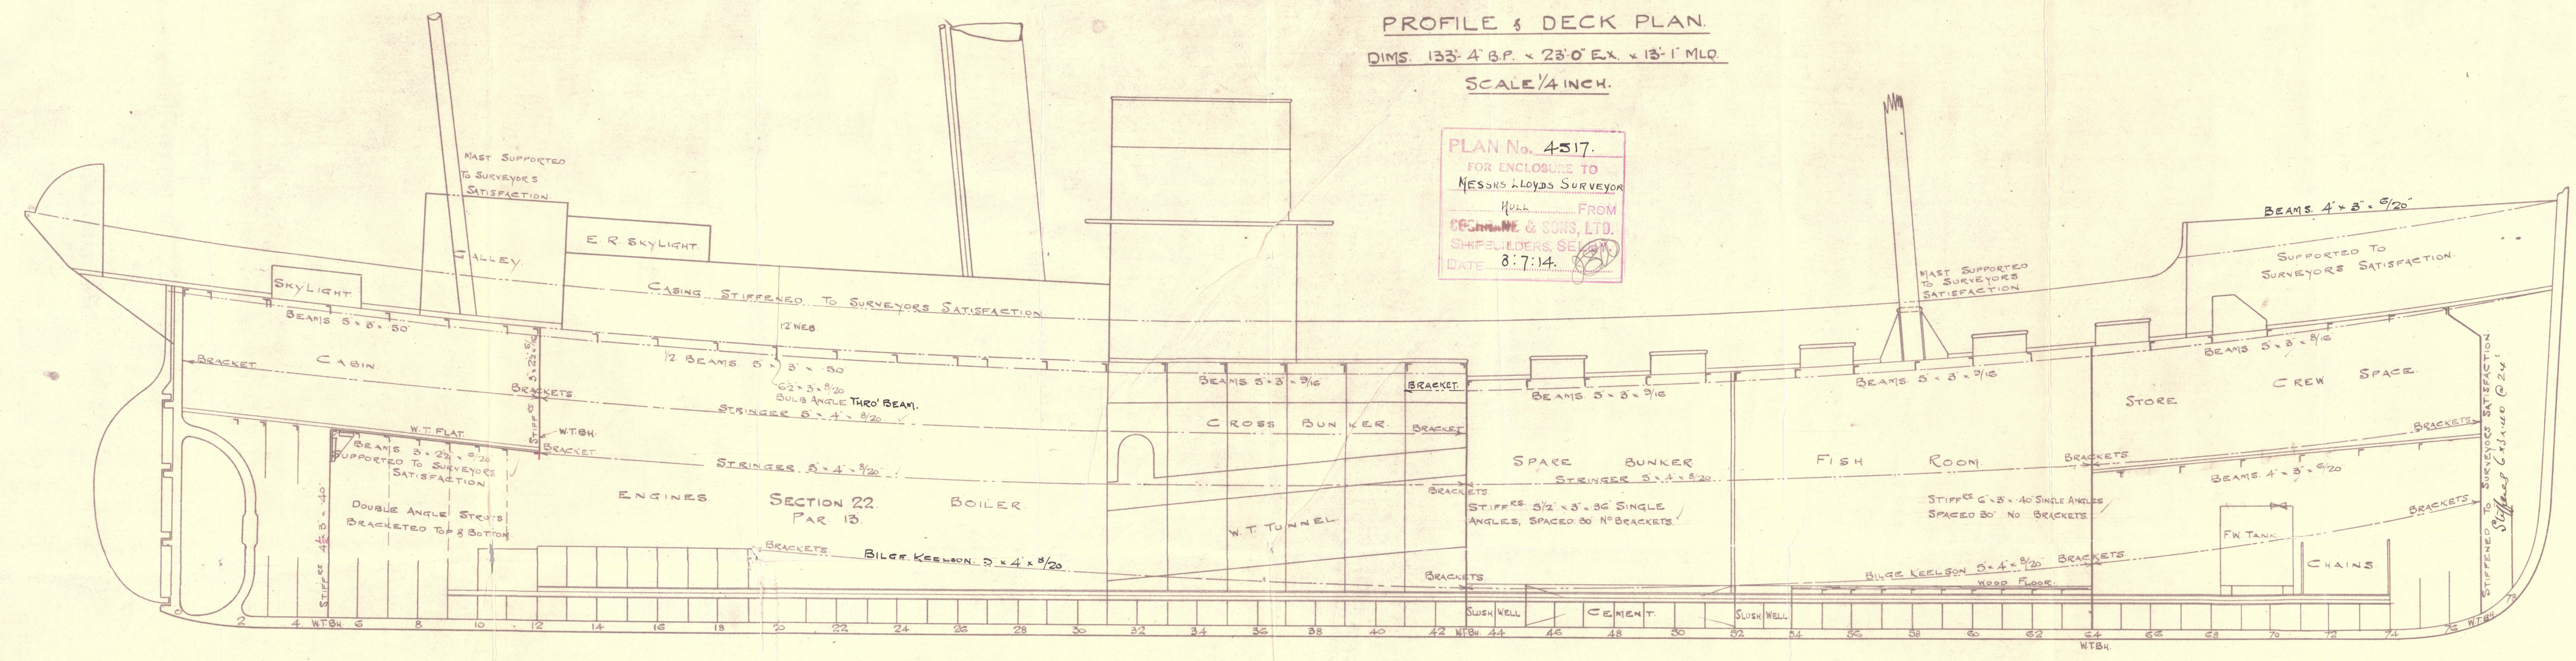

bbf  
14.7.14.



Cochran's 623.


Profile & Deck

1/2 "St. Denis"

Hull Rpt. no. 28352

1/4 "Masona"

RETAIN

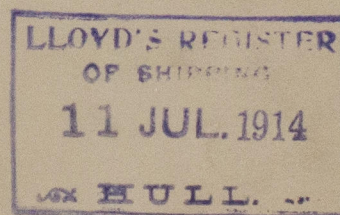

© 2020

Lloyd's Register  
Foundation