


30.12.02




30.12.02
Mills Monmouth Dock 16' x 12'
Boiling plate 2'-10" x 30' x 1 3/8"

Shell 1 1/2"
Combs 1 1/2"
Tubes 1 1/2"
Rivets 1 1/2"

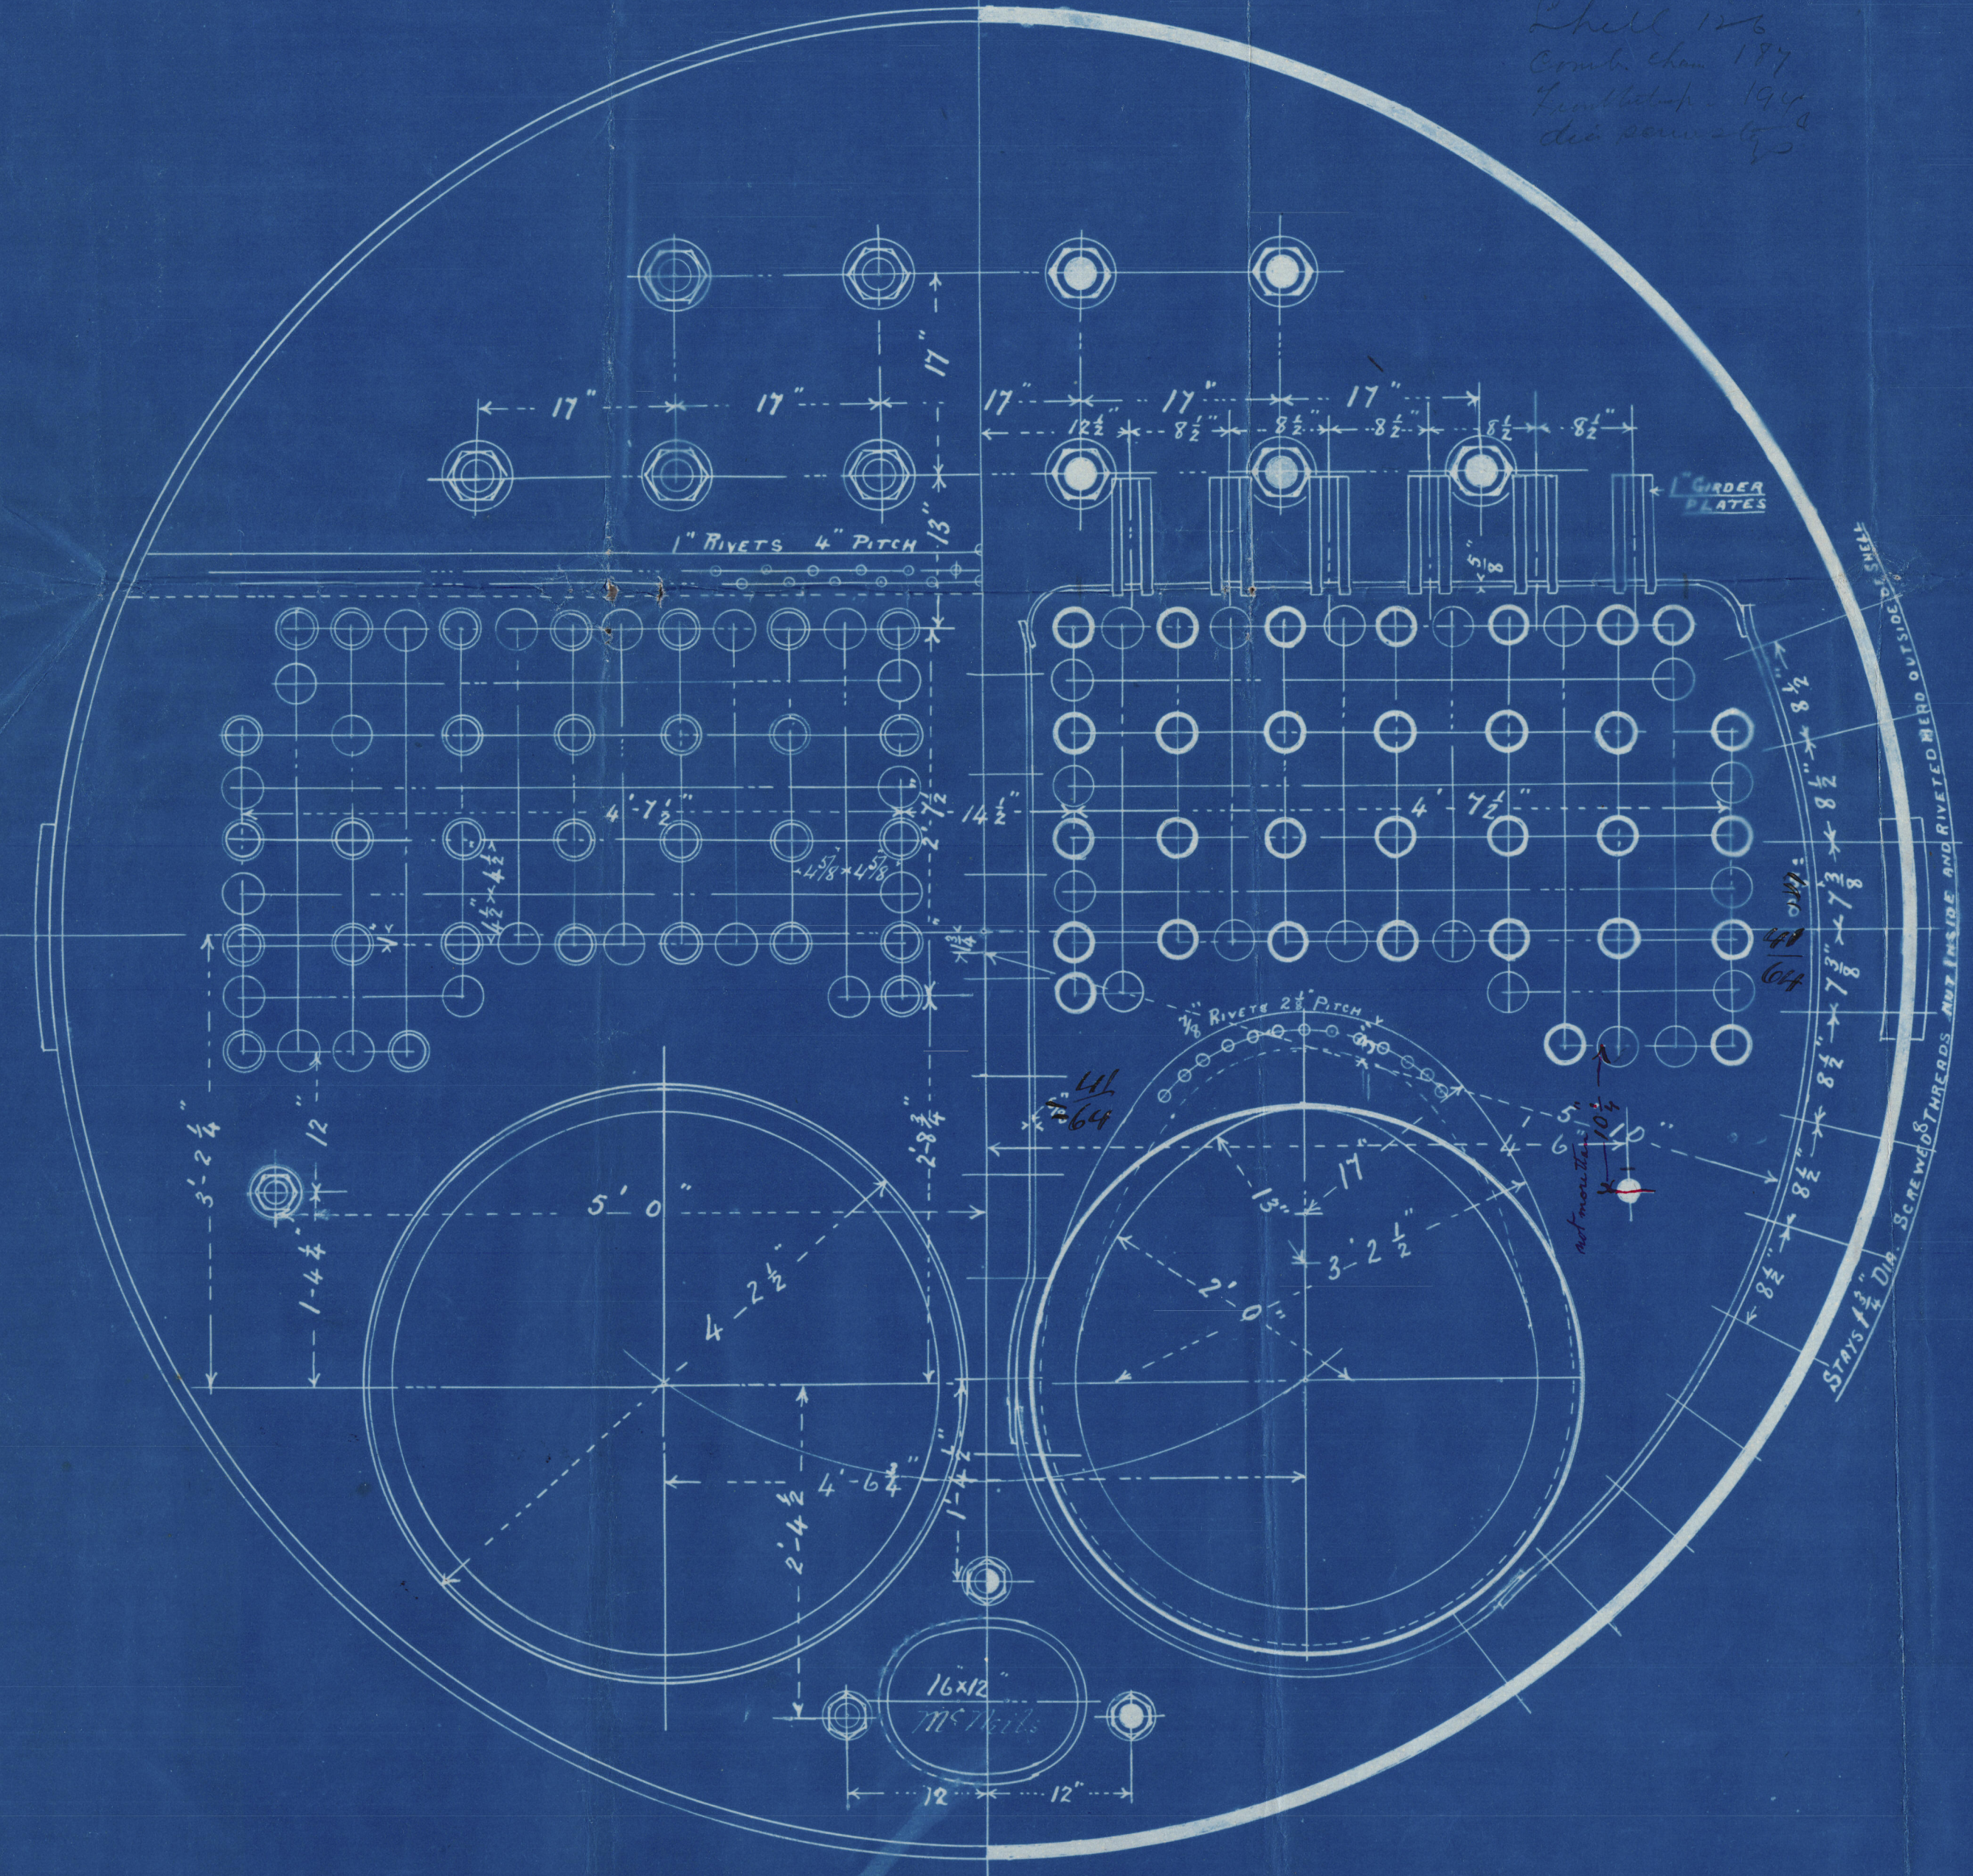

PLATES RIVETS STAYS STEEL TUBES IRON

LLOYD'S RULES		
PLATE	PERCENTAGE	85.06
RIVET	" "	91.60

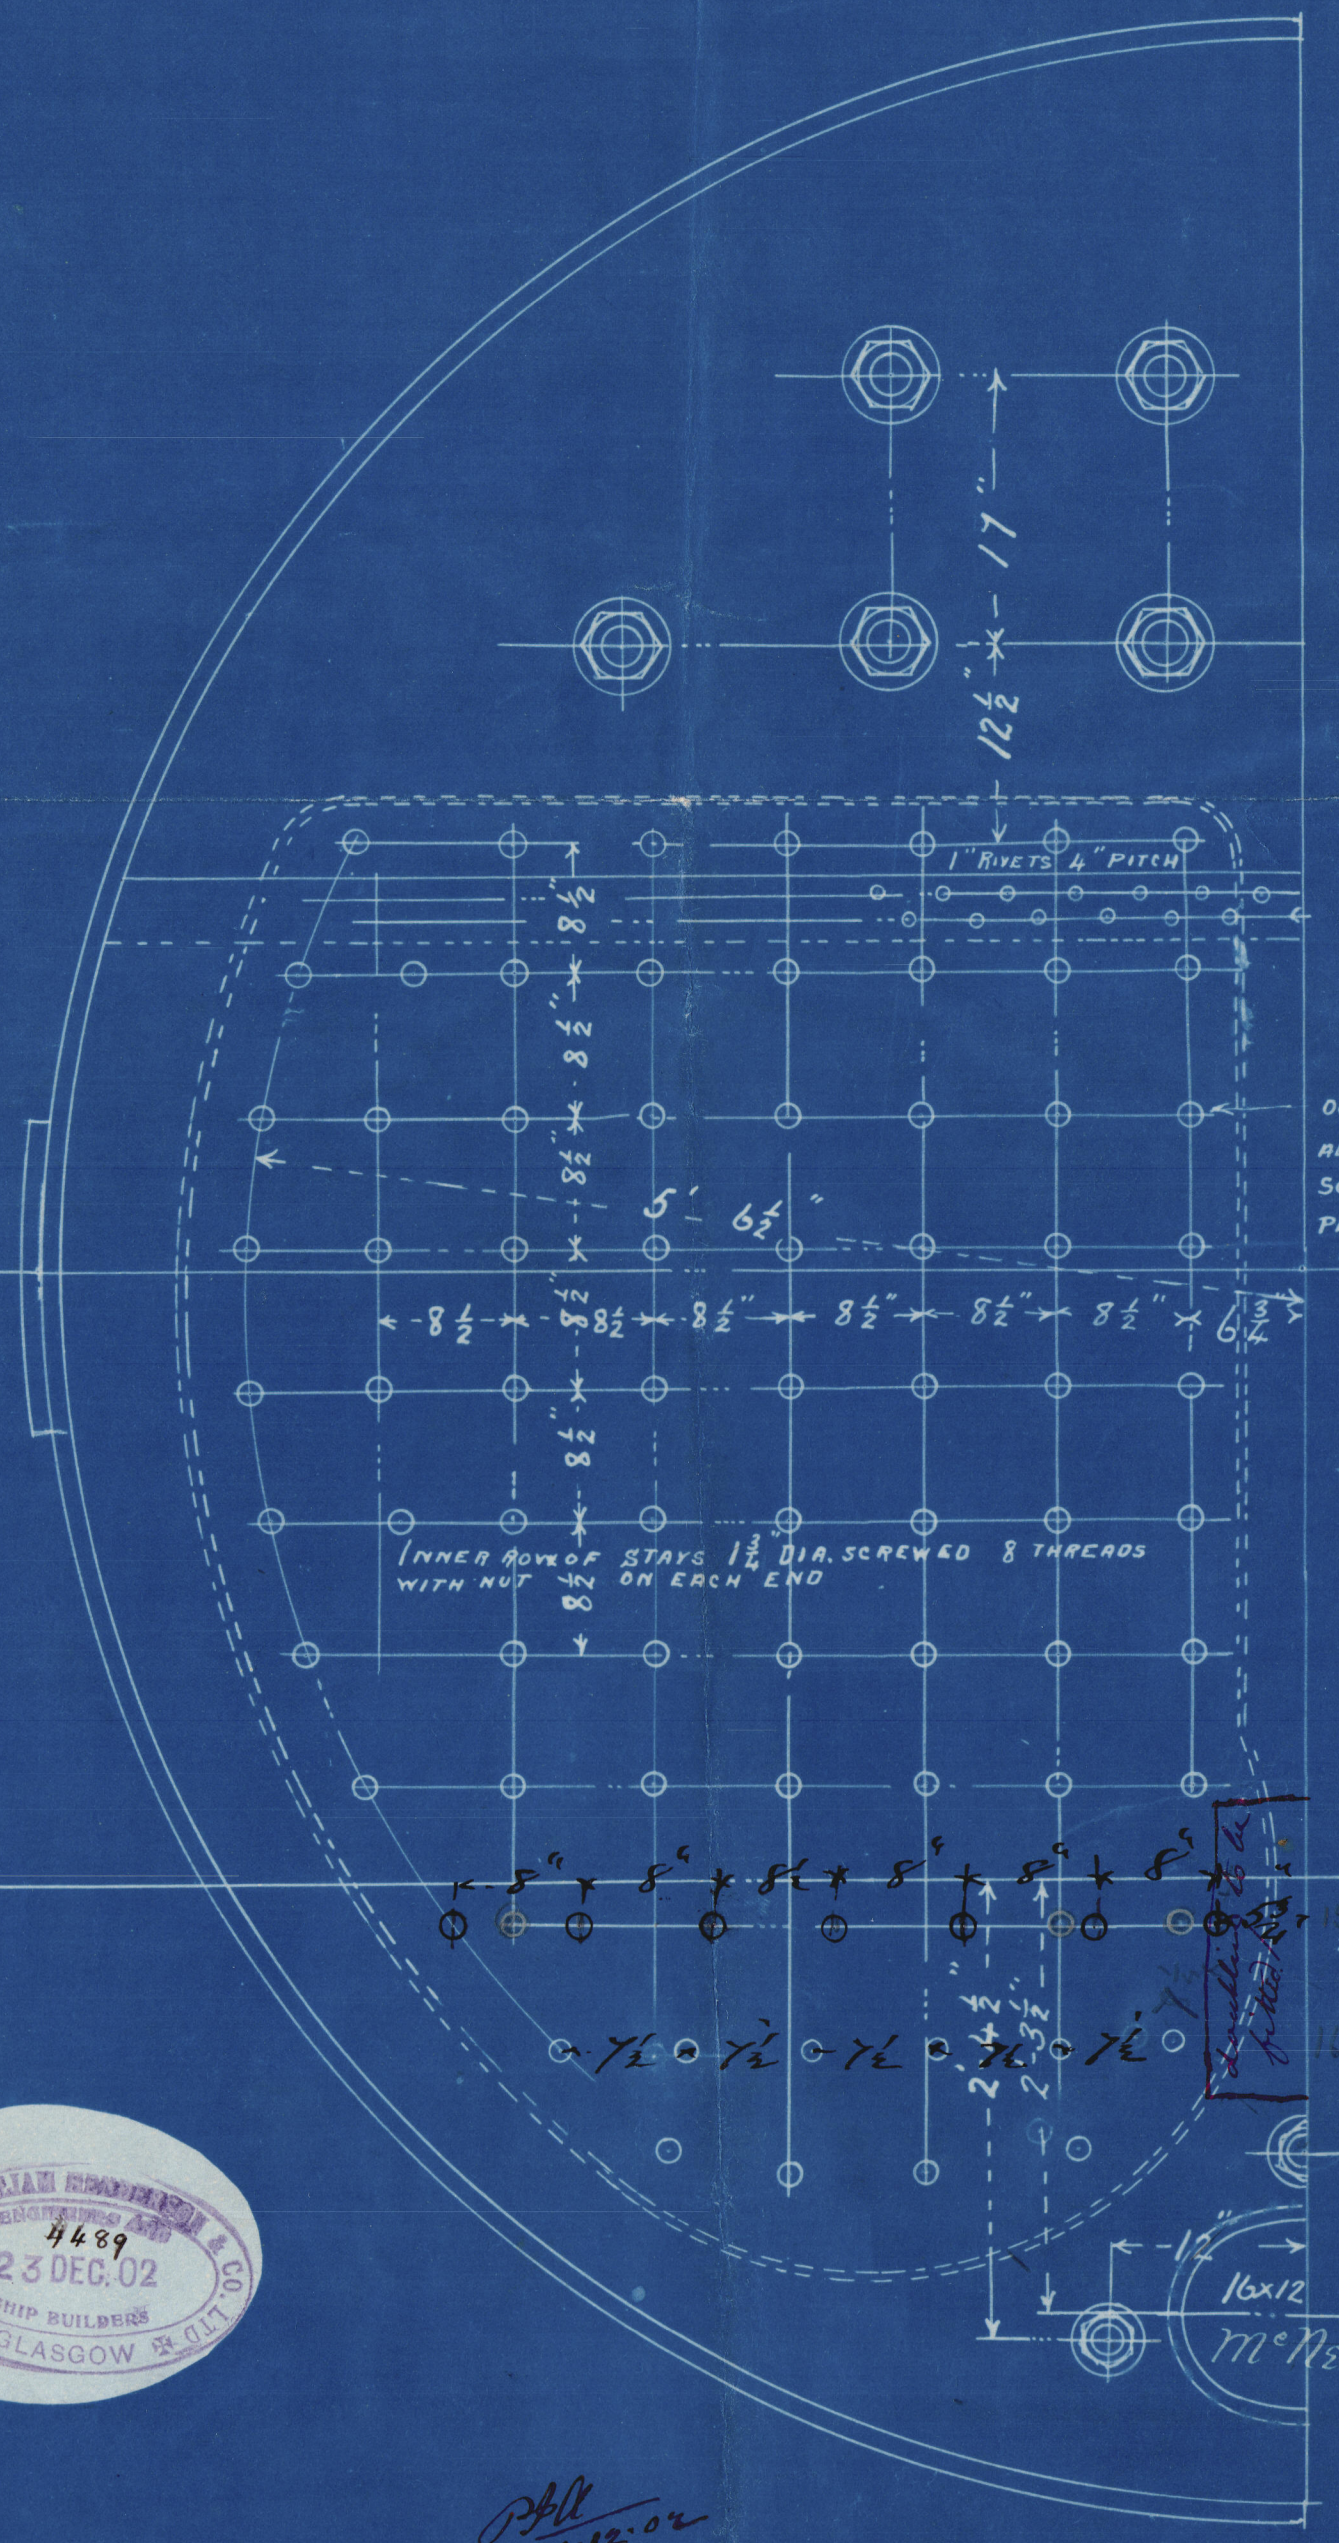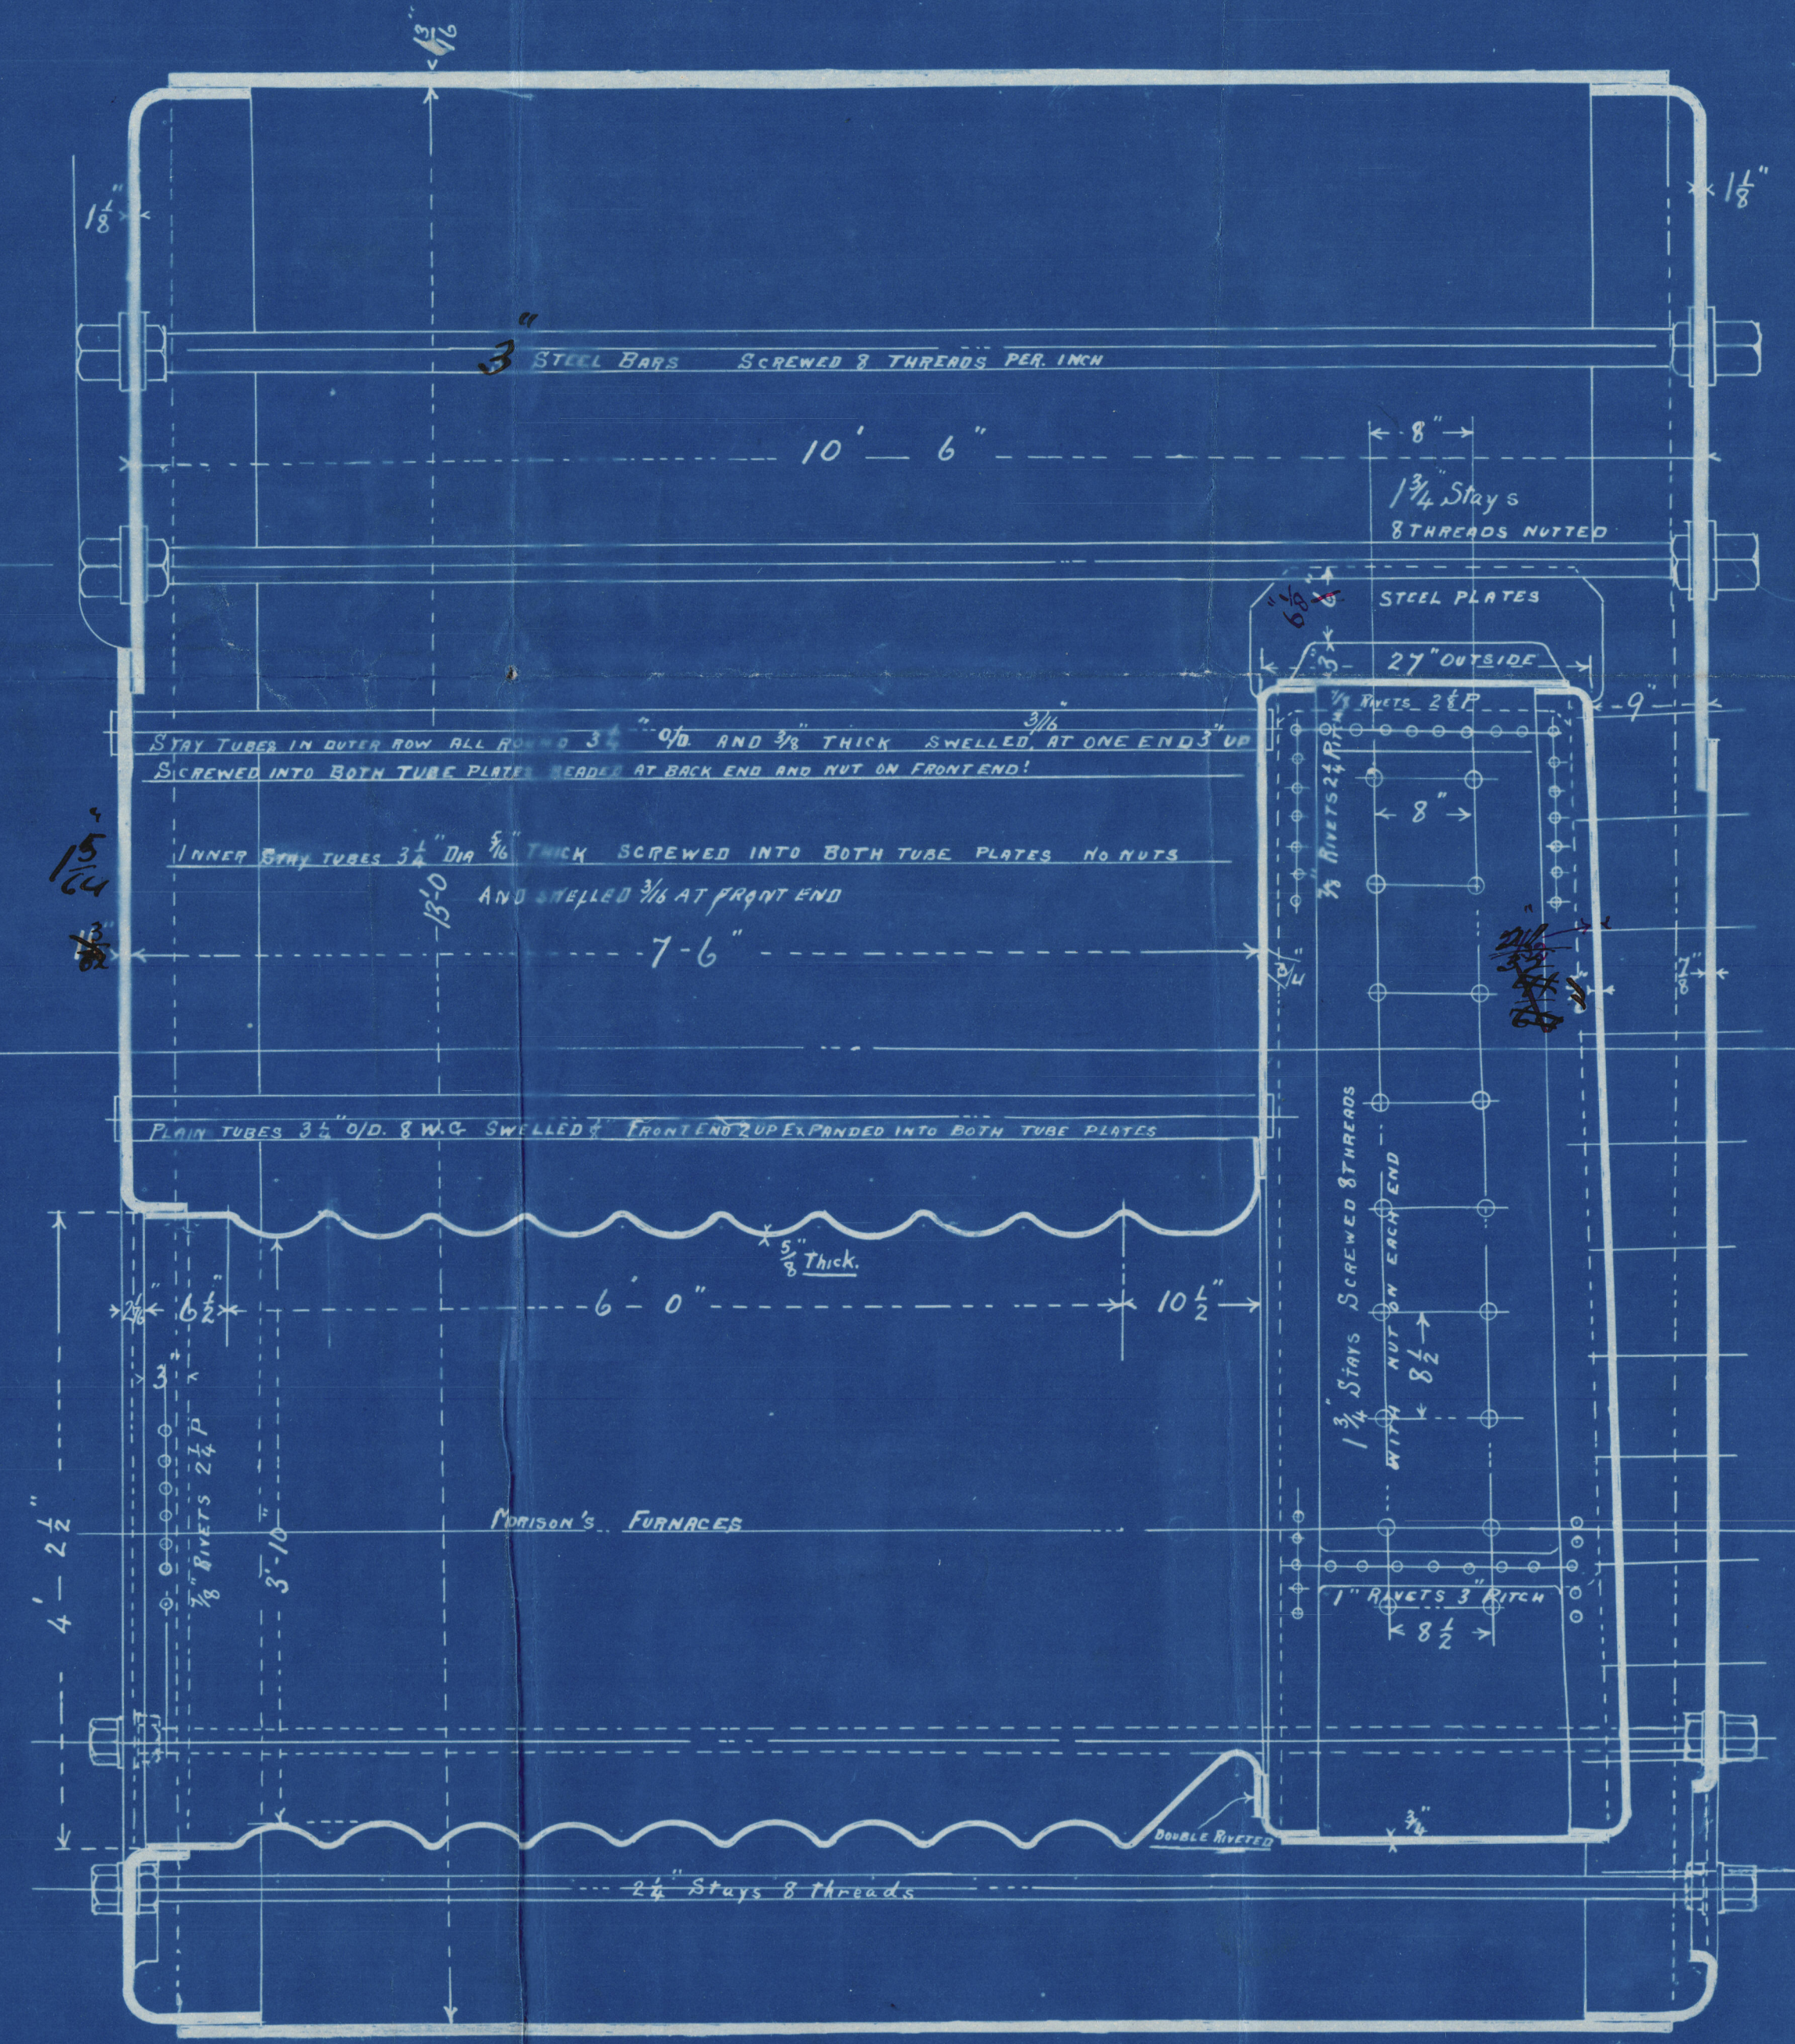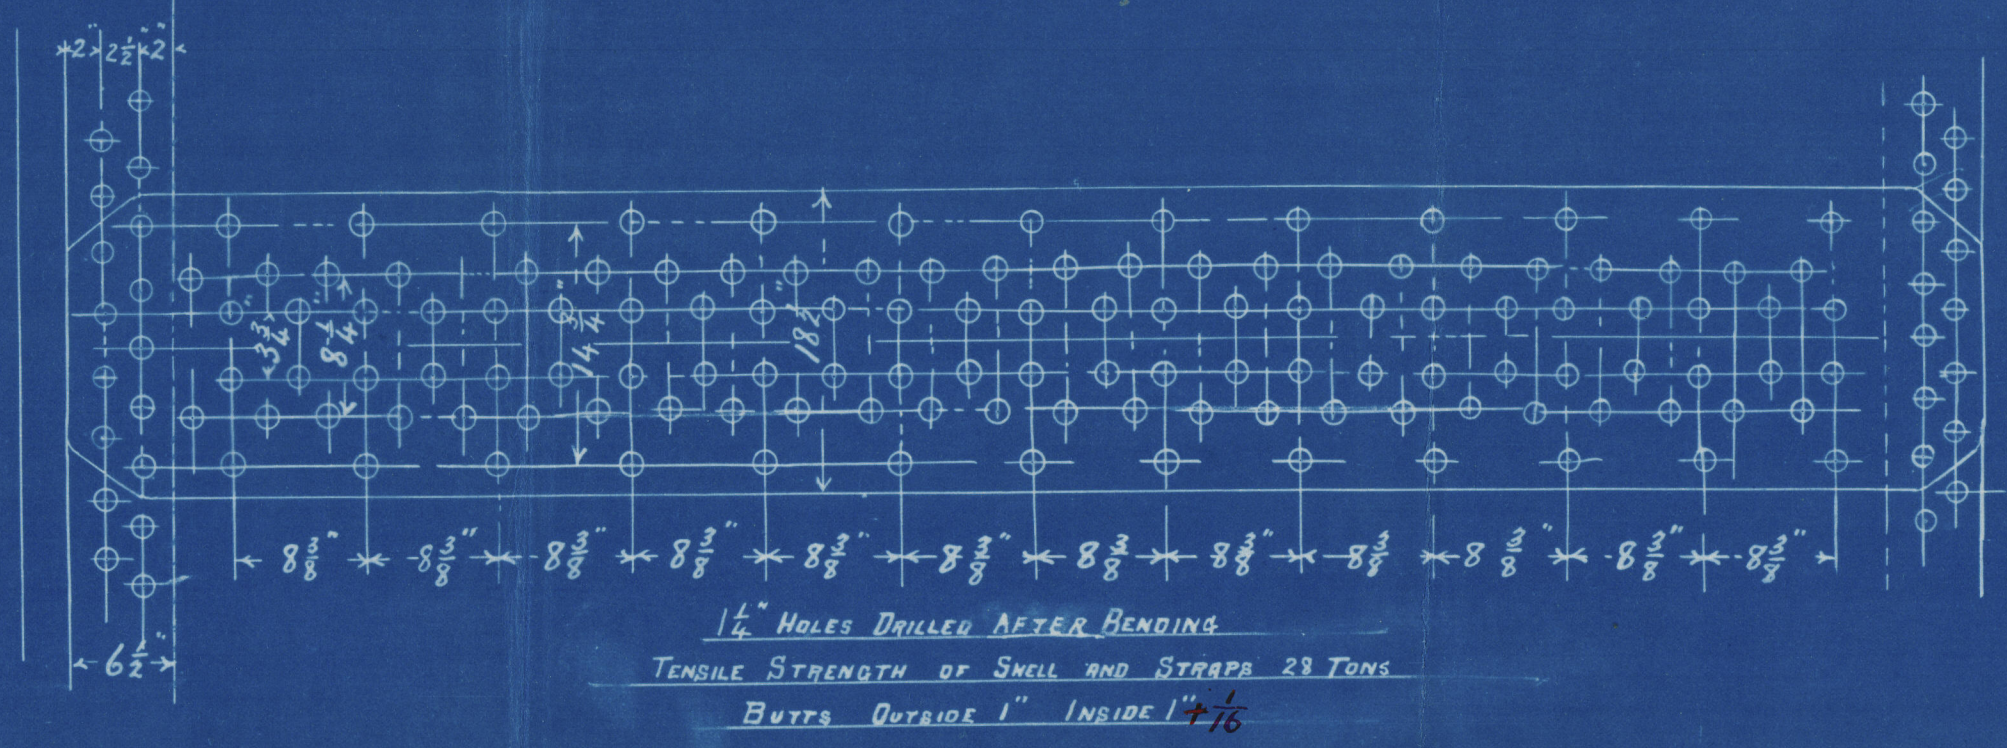


WORKING PRESSURE	200 LBS.
TESTING	400 LBS.

MAIN BOILER N^o 435
SCALE 1" = 1 FOOT

To Pass LLOYDS

Drawn by J.P.P.
Traced by J.P.P.
Checked by J.P.P.

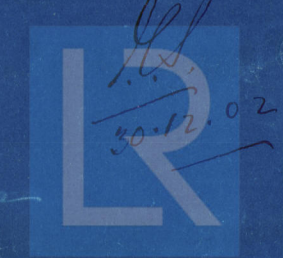

30.12.02


From DAVID & WILLIAM HENDERSON & CO.

FOR ENCLOSURE TO

Messrs. The Surveyors... to...

Lloyds Registry


W1011-0247²/₂

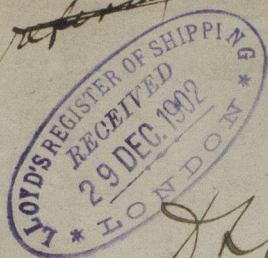

J.W. Henderson
No. 435

"Varala"
ex.
Beccate
Pls upr No 21109

Baler - 200 P.S.S.

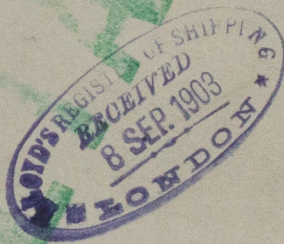

© 2020

Lloyd's Register
W1011-0247/2
[checked by ...]